5 cm

03 DM 08 - 3020

0374_3304

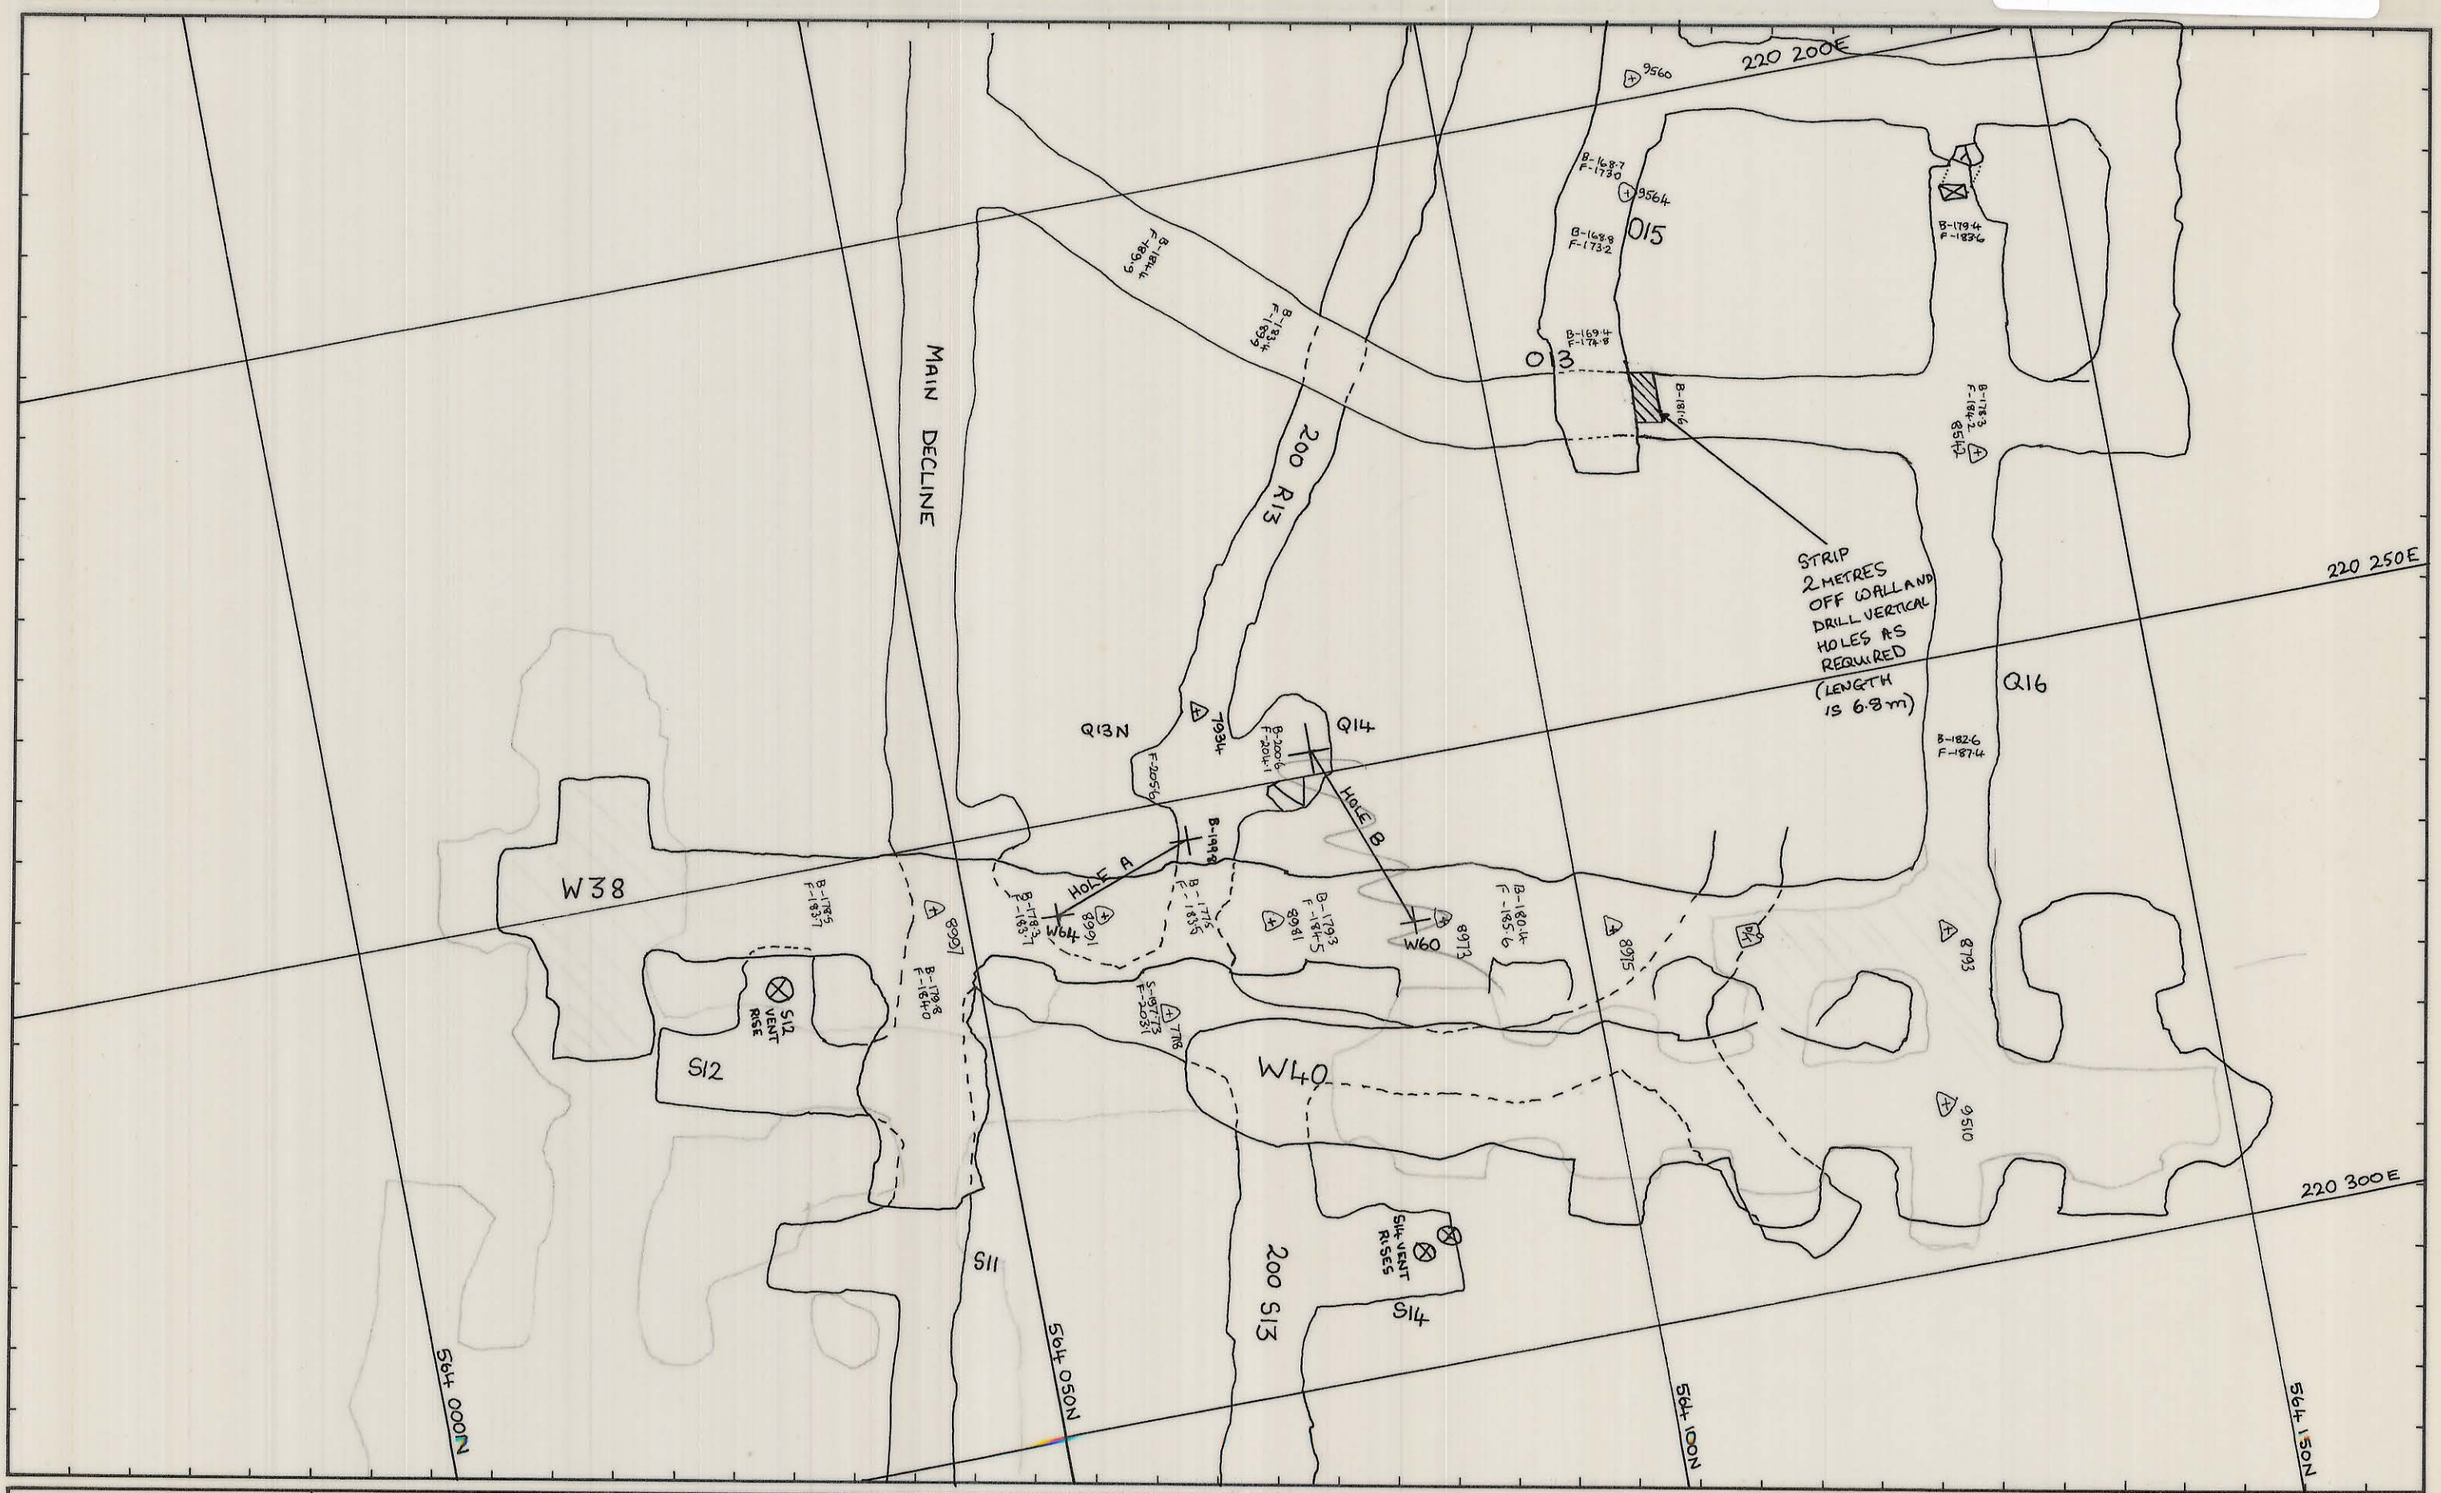

HOLE A W64 – 200R13	HOLE B W60 – 200Q14		REF. PLAN				SCALE 1:500	KING ISLAND SCHEELITE GRASSY KING ISLAND
ANGLE = -52°	ANGLE = 43.5°	Hole B. Install in Lift 6. Matt O.	Matt O. 30/10/84.	GEOLOGY			MID-WEDGE DRAIN HOLES	
LENGTH = 20.5 metres	LENGTH = 22.6 metres			SURVEY			015 CABLE HOLES.	
BEARING = 340°	BEARING = 249°			PLANNING	AD7	11-10-84		
				ROCK MEC.				
				GRADE CON.				
				DRAFTING			DRAWING NUMBER	
				T.S.S.			03 DM 08 – 3020	