27 JUN 1981

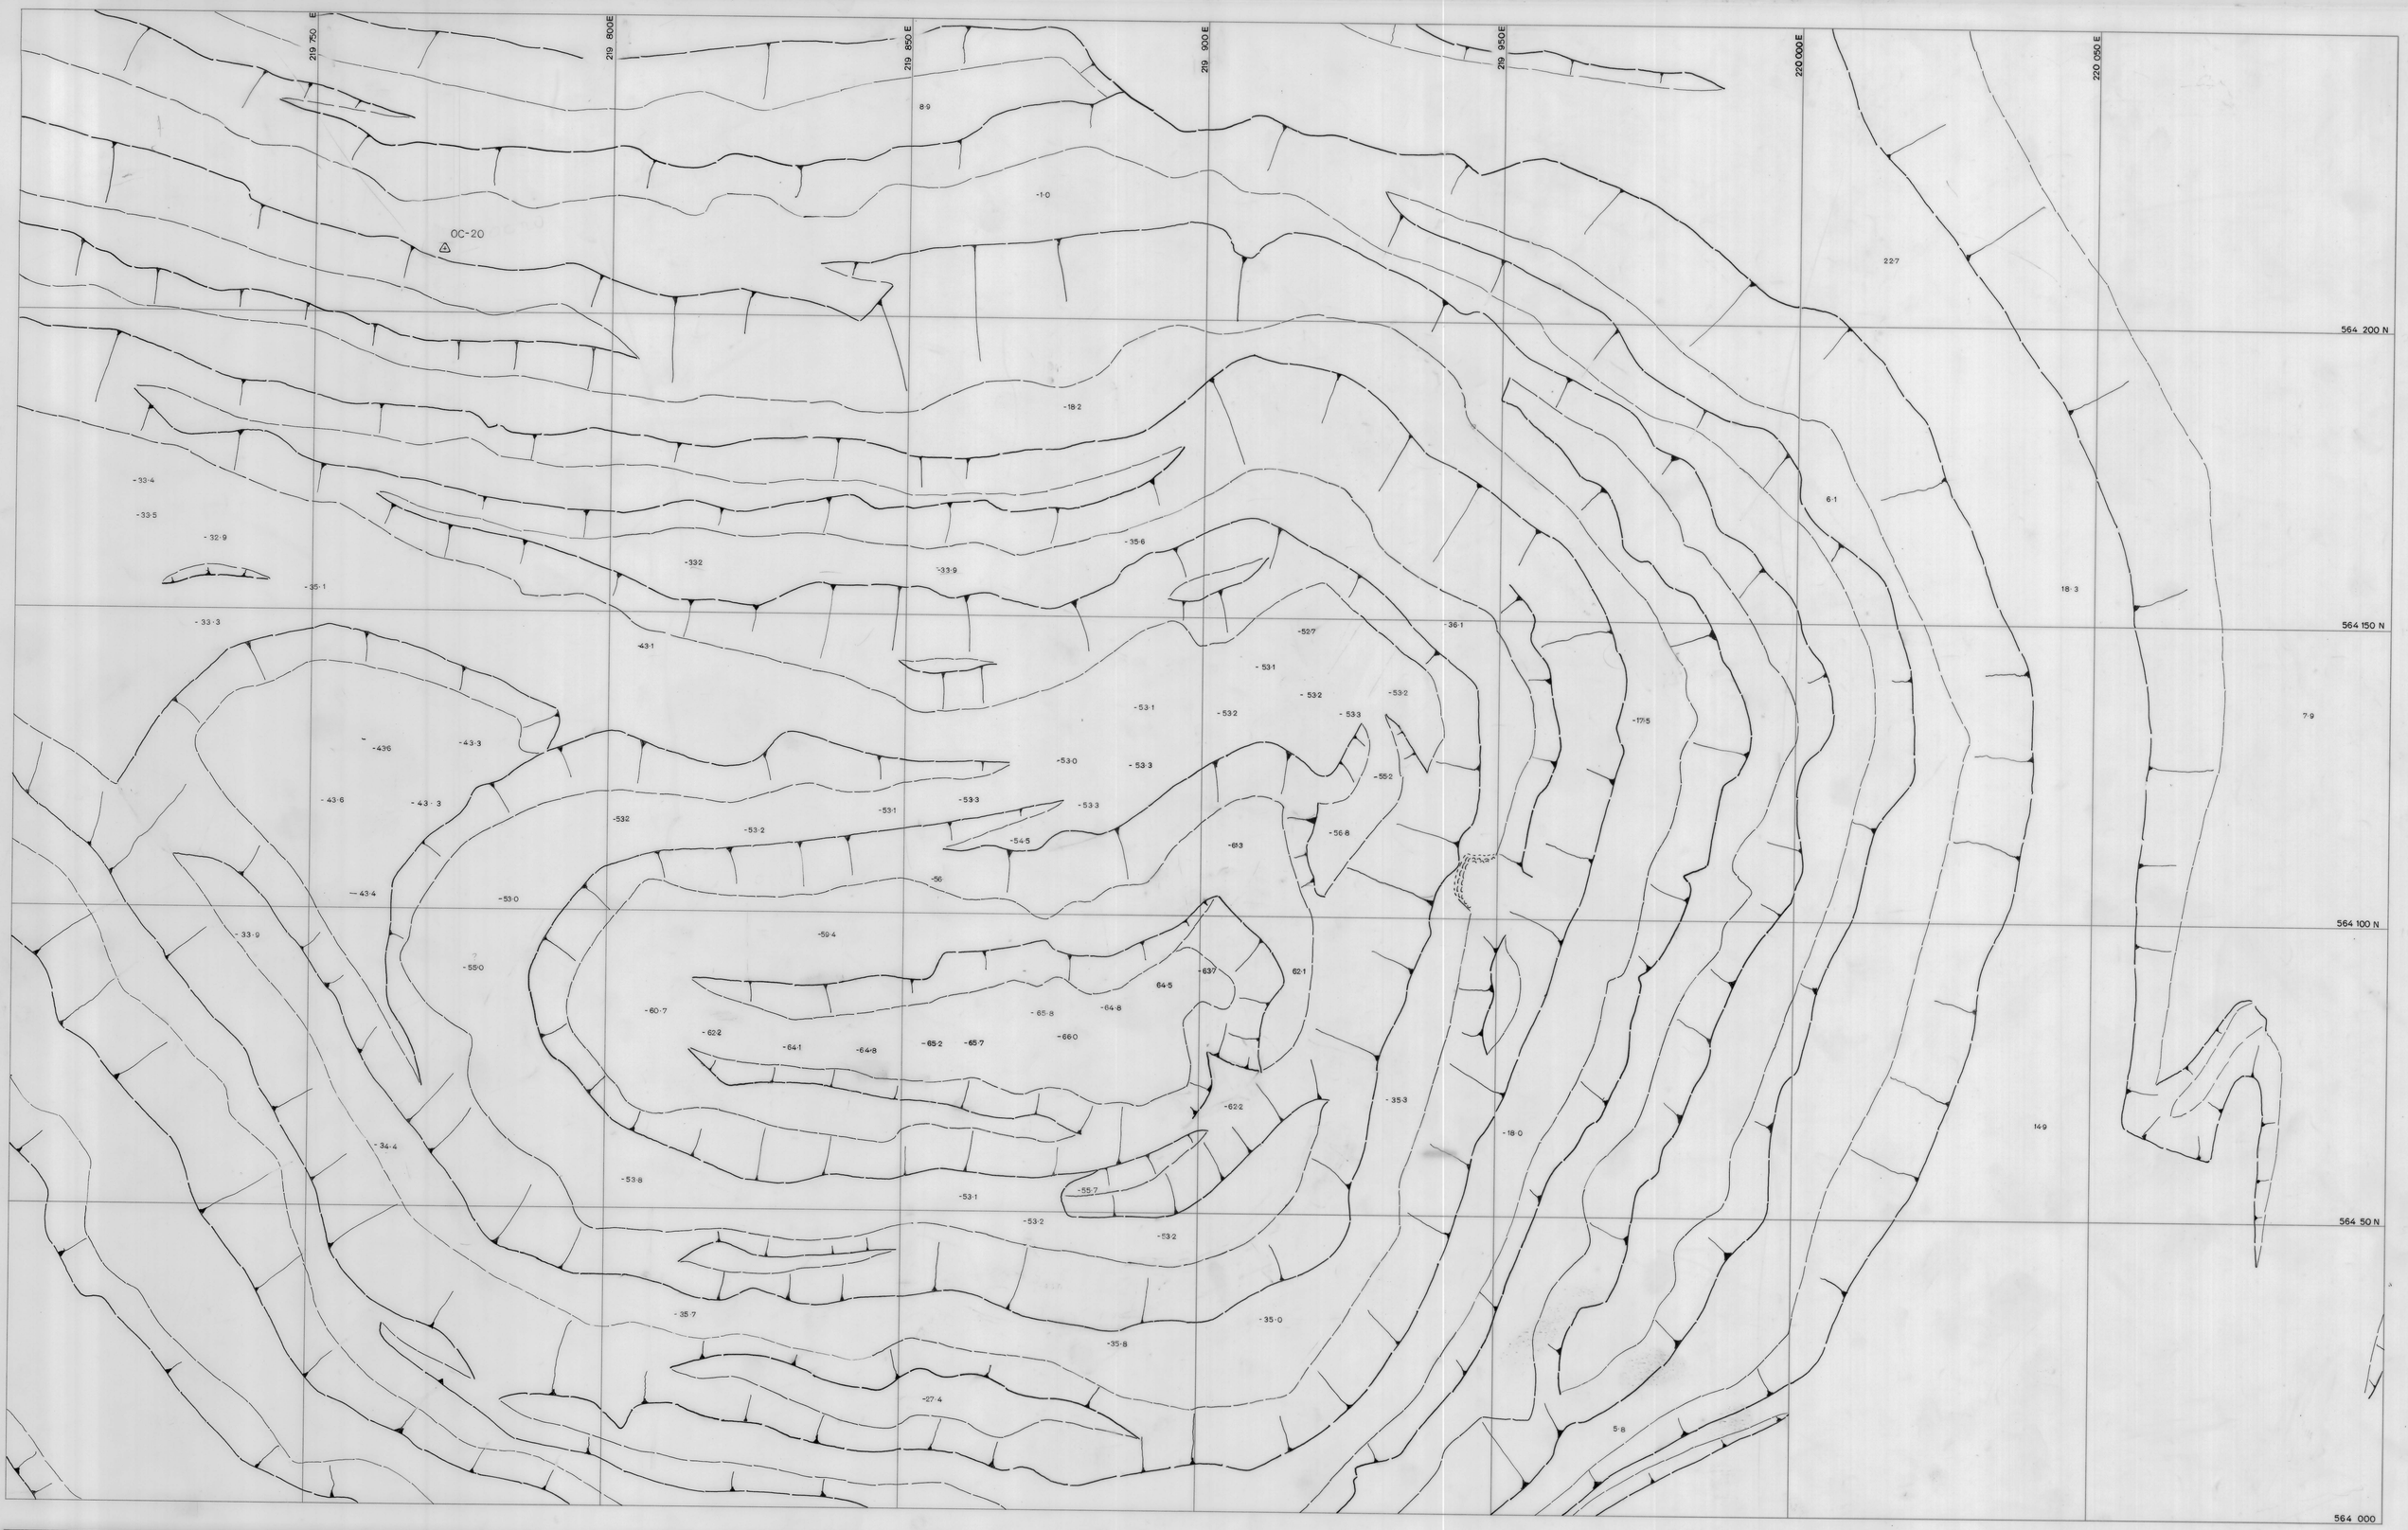

SURVEYED	SCALE 1: 500		LOCATION OPEN CUT	KING ISLAND SCHEELITE — A DIVISION OF WARMAN INTERNATIONAL
DATE	5 cm		SUBJECT BEDROCK RL's	GRASSY KING ISLAND
DRAWN A.F.		north		PLAN NUMBER 040C03 -1002
TRACED A.F.				
DATE 16/1/79				
CHECKED				
SHEET 2 OF 2 SHEETS				