


0374_3371

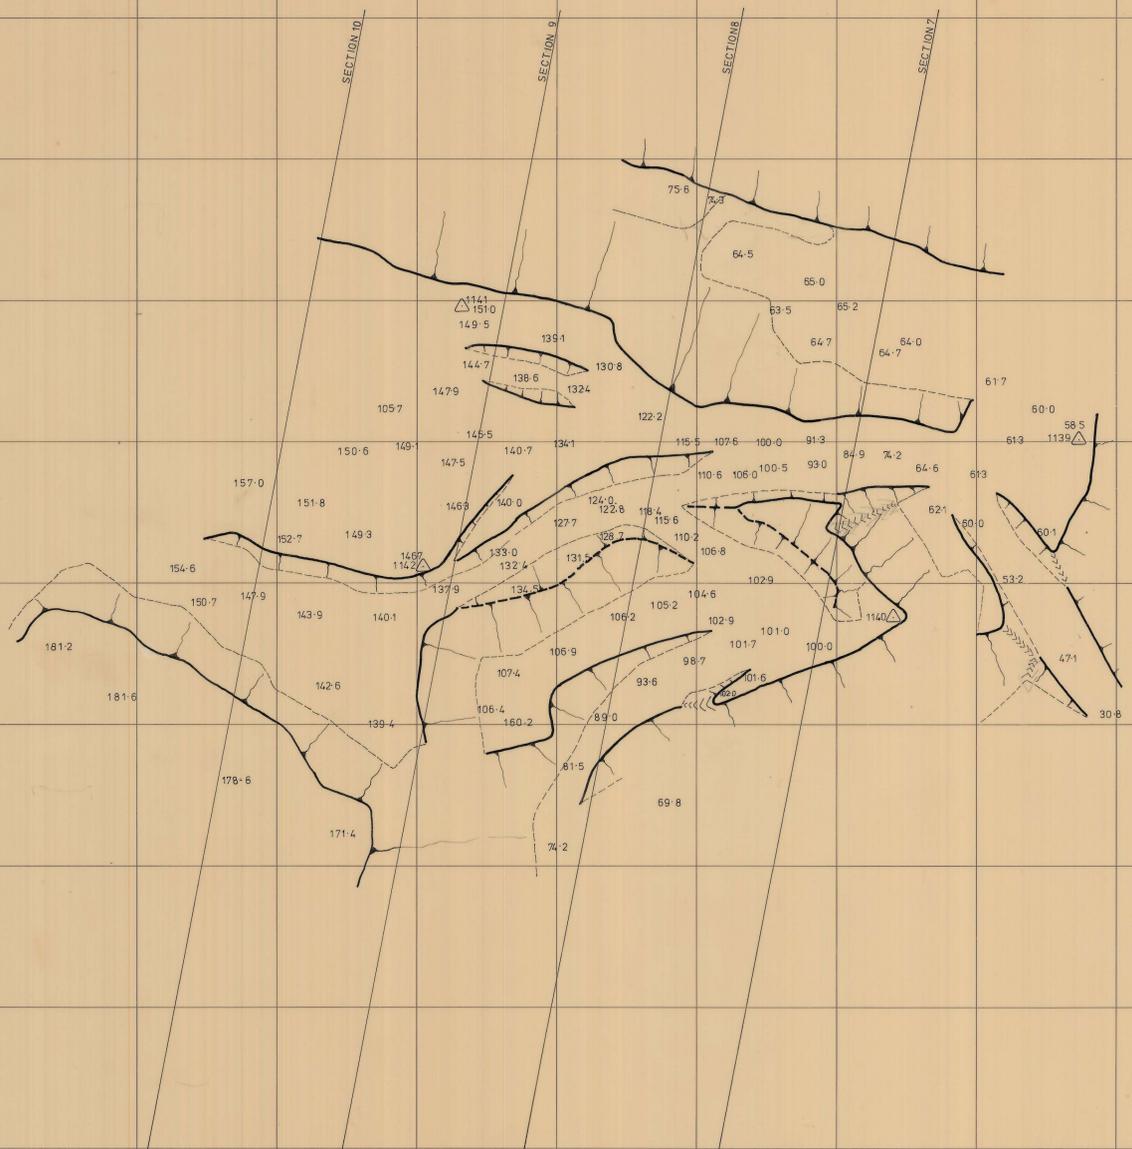

100,800E 100,900E 100,000E 100,100E 100,200E 100,300E 100,400E 100,500E 100,600E 100,700E

98,500N 98,600N 98,700N 98,800N 98,900N 99,000N 99,100N 99,200N 99,300N 99,400N 99,500N 99,600N 99,700N 99,800N 99,900N

KING ISLAND SCHEELITE (1947) LIMITED

SAND DUMP

SCALE 1 inch = 50 Feet

NOTE
EAST END SAND DUMP BEFORE
SCRAPING BY ROCHE BROS. AND
AFTER SCRAPING BY K.I.S.

SURVEY I. M. DOUGLE CHECKED R. HARTH
DRAWN G. HAMMERSTEIN Date: 31-3-71

1-13-8