


0374_3375

WHARF PARAPET

Scale : 20 ft to an inch

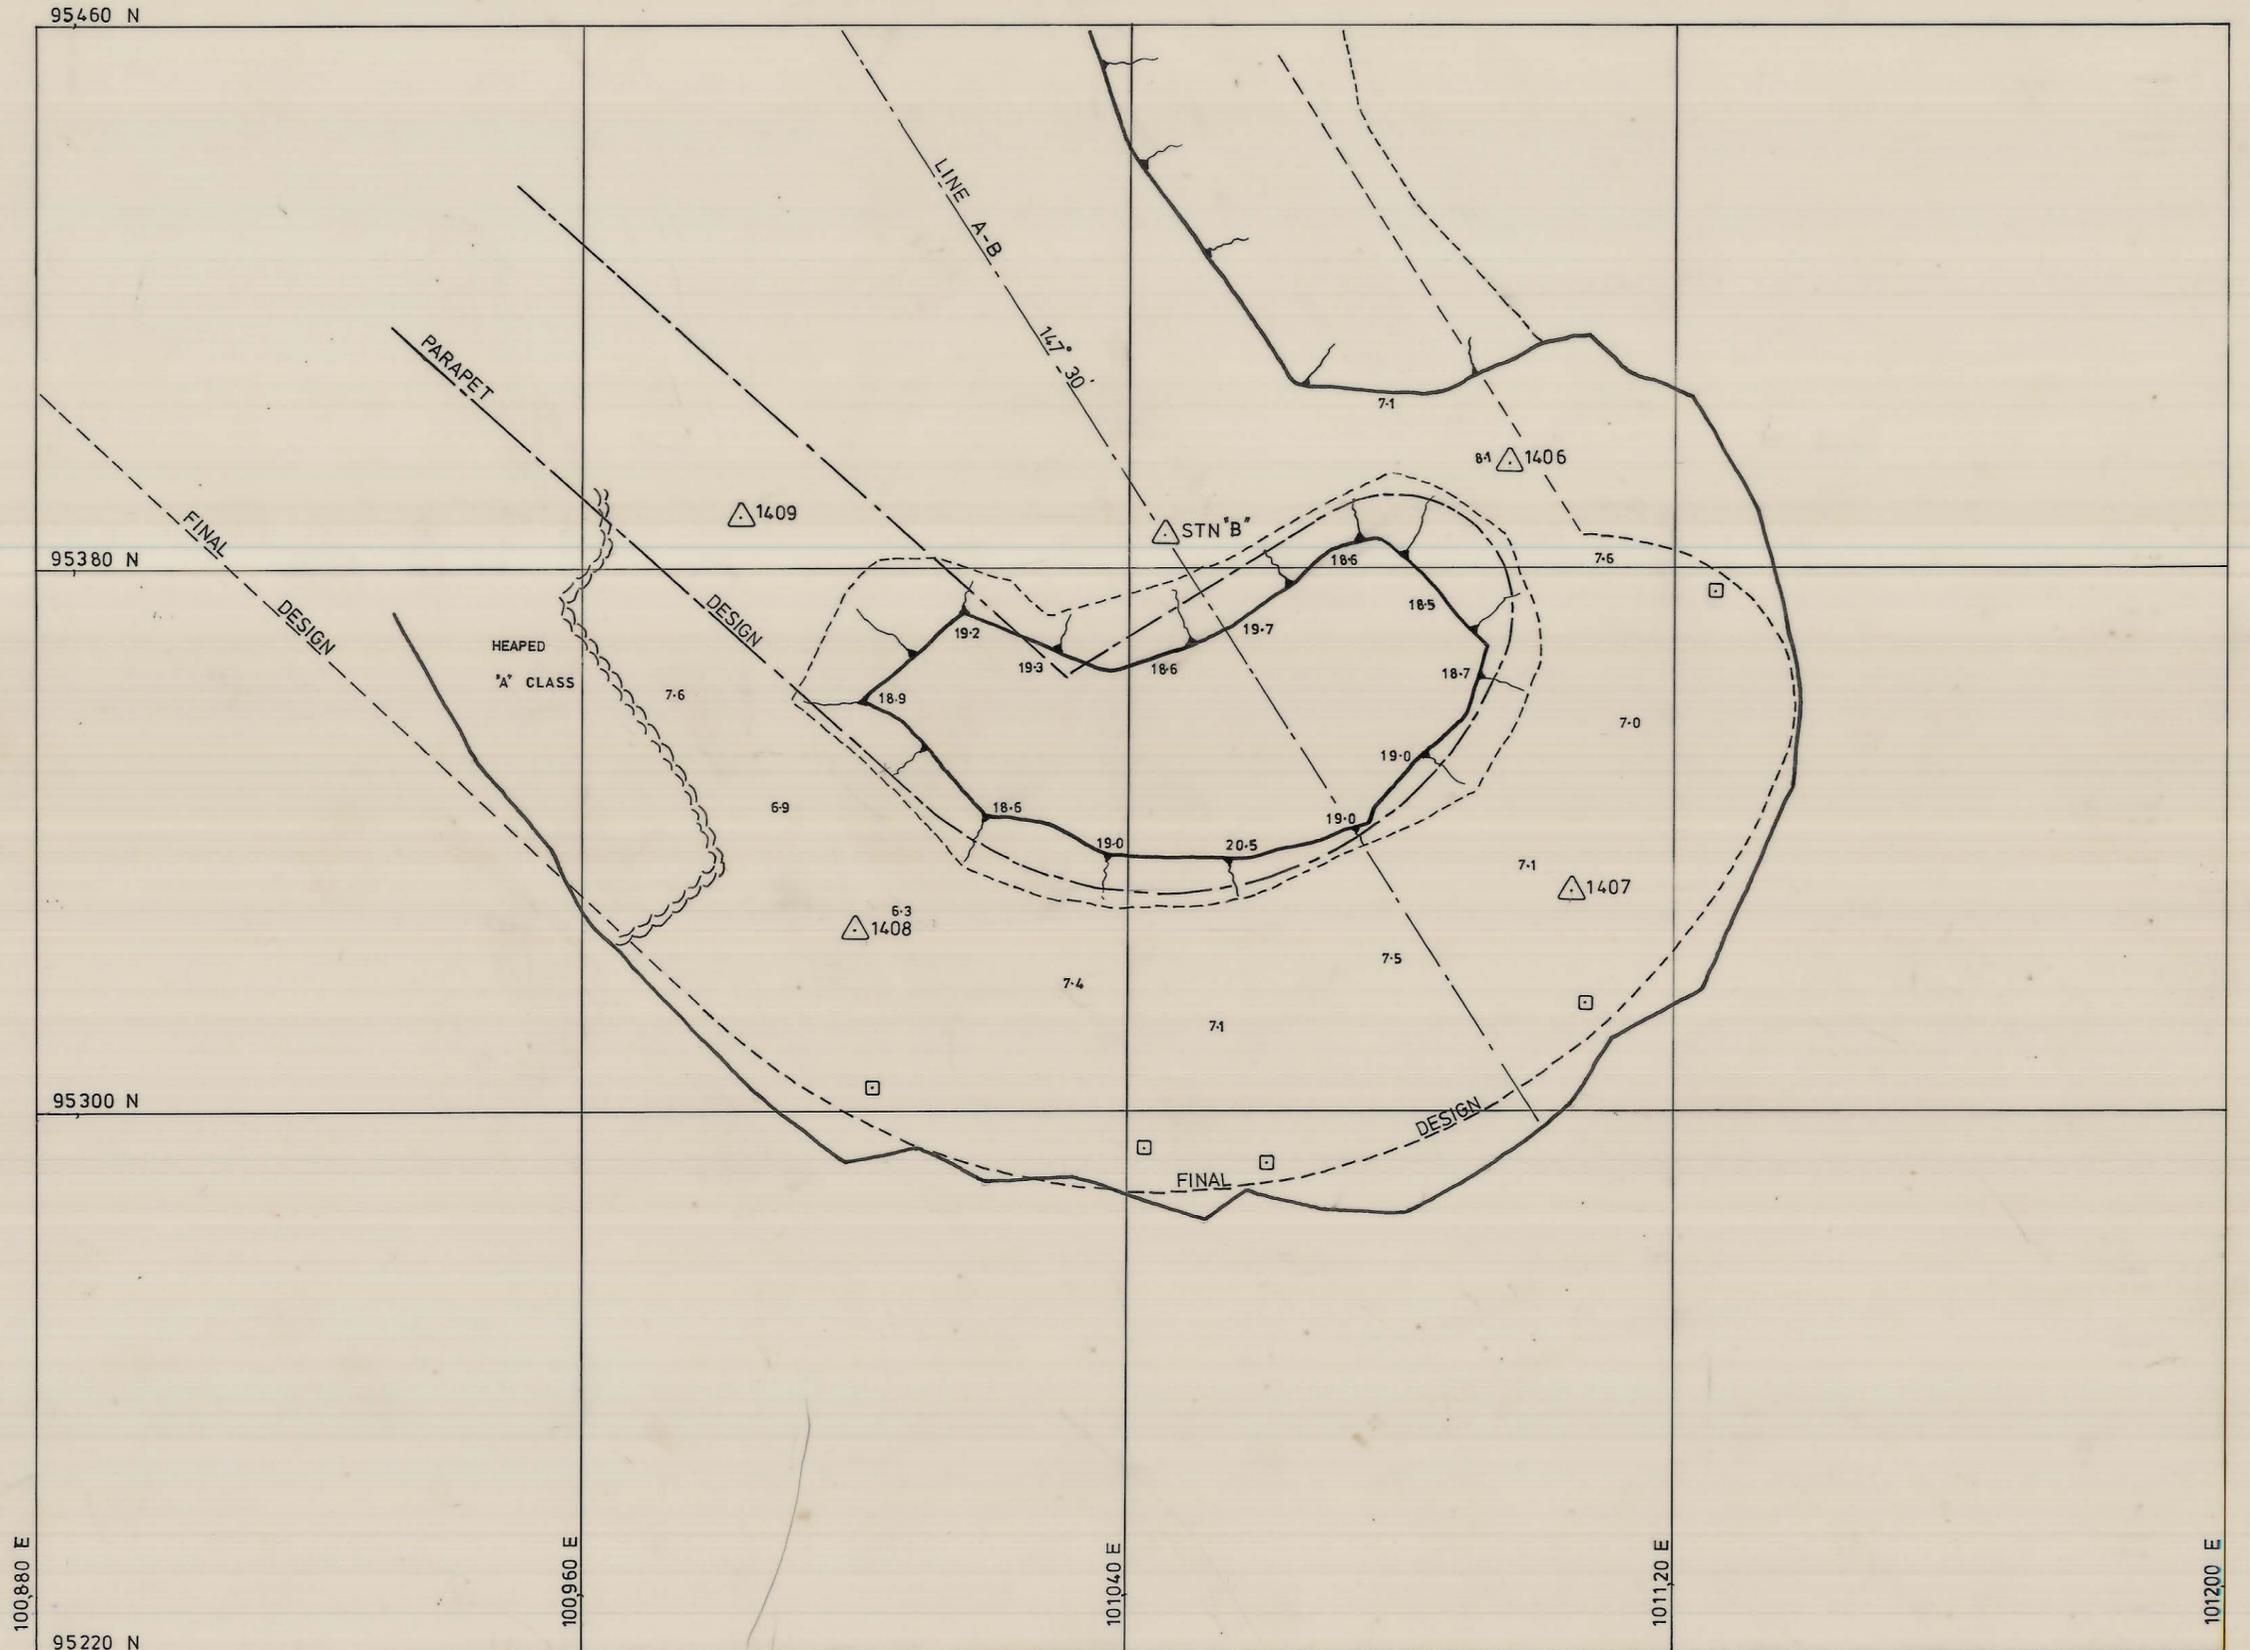

5 cm

1-11-28(w)