27 JUN 1981

5 cm

04GD04 - 106255

0374_3378

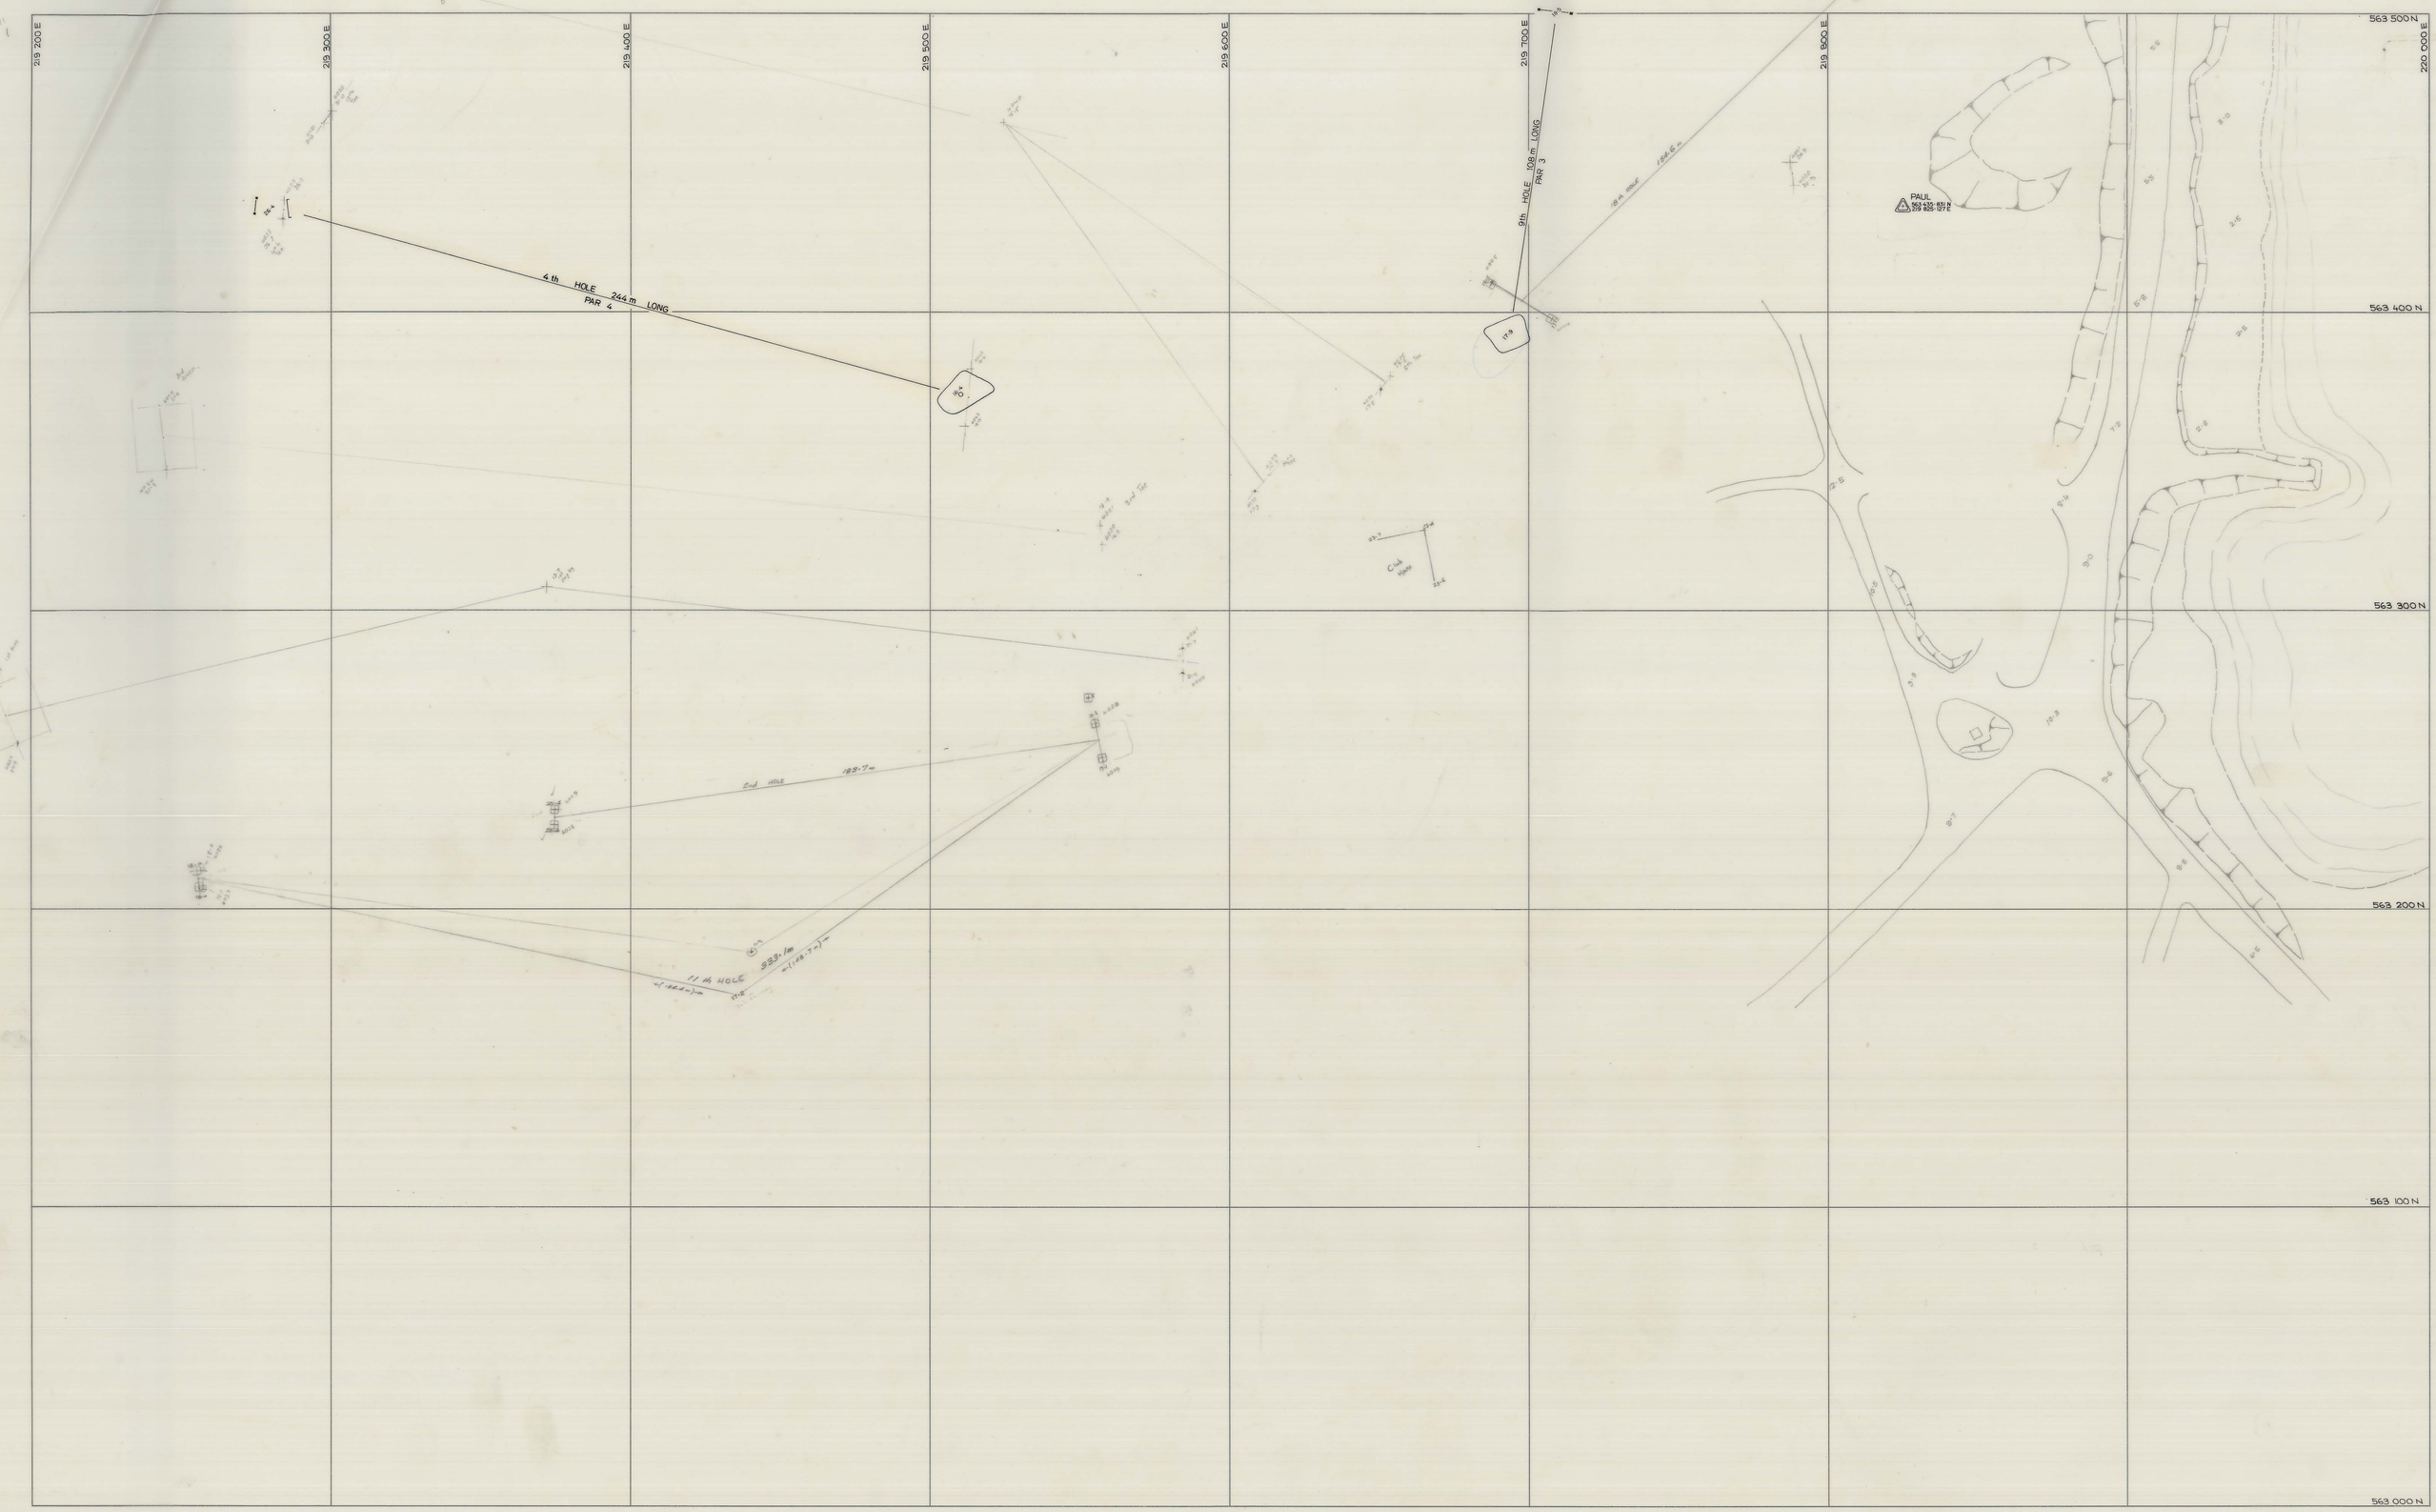

	SCALE 1:1000	north	LOCATION: GRASSY & ENVIRONS
			SUBJECT: GOLF COURSE
			KING ISLAND SCHEELITE — A DIVISION OF WARMAN INTERNATIONAL — GRASSY KING ISLAND
			PLAN NUMBER: 04GD04 - 106255