


5 cm

0374_3384

WHARF PARAPET

Scale : 20 ft to an inch

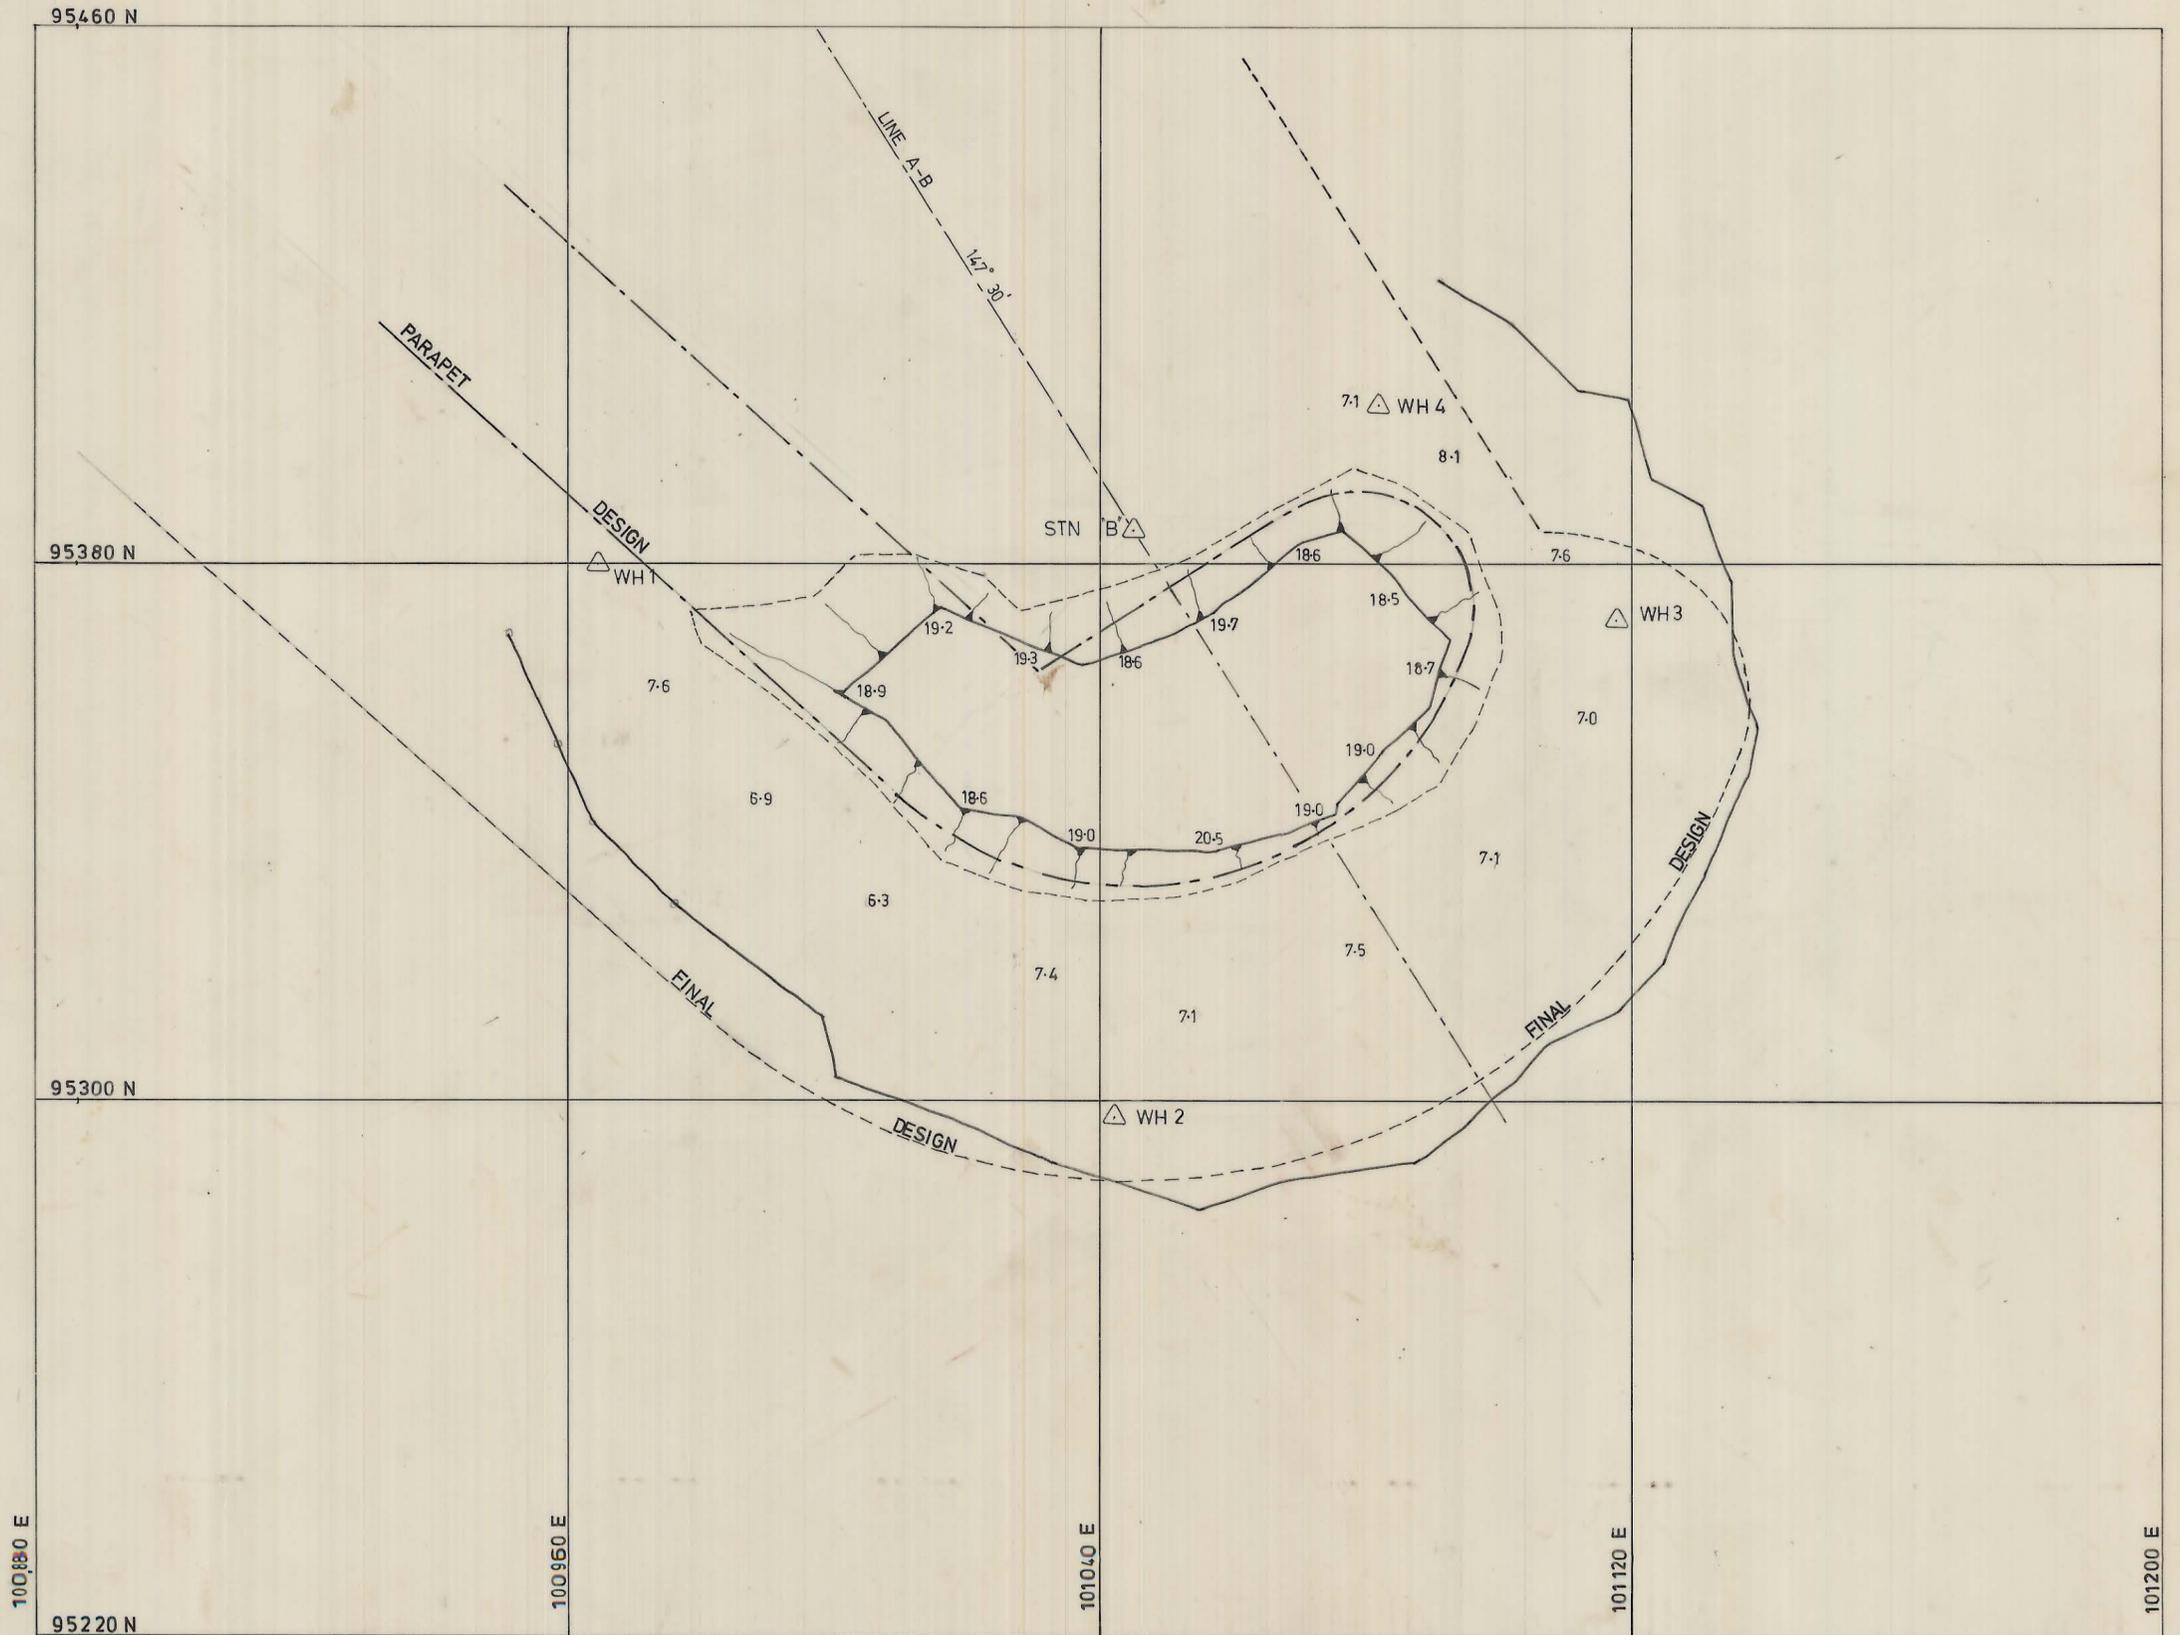

1-11-27 (with signature) 73