


DOLPHIN MINE

PARTIAL VENTILATION SURVEY D/S WED 6 SEP 78
Quantities in m³/s

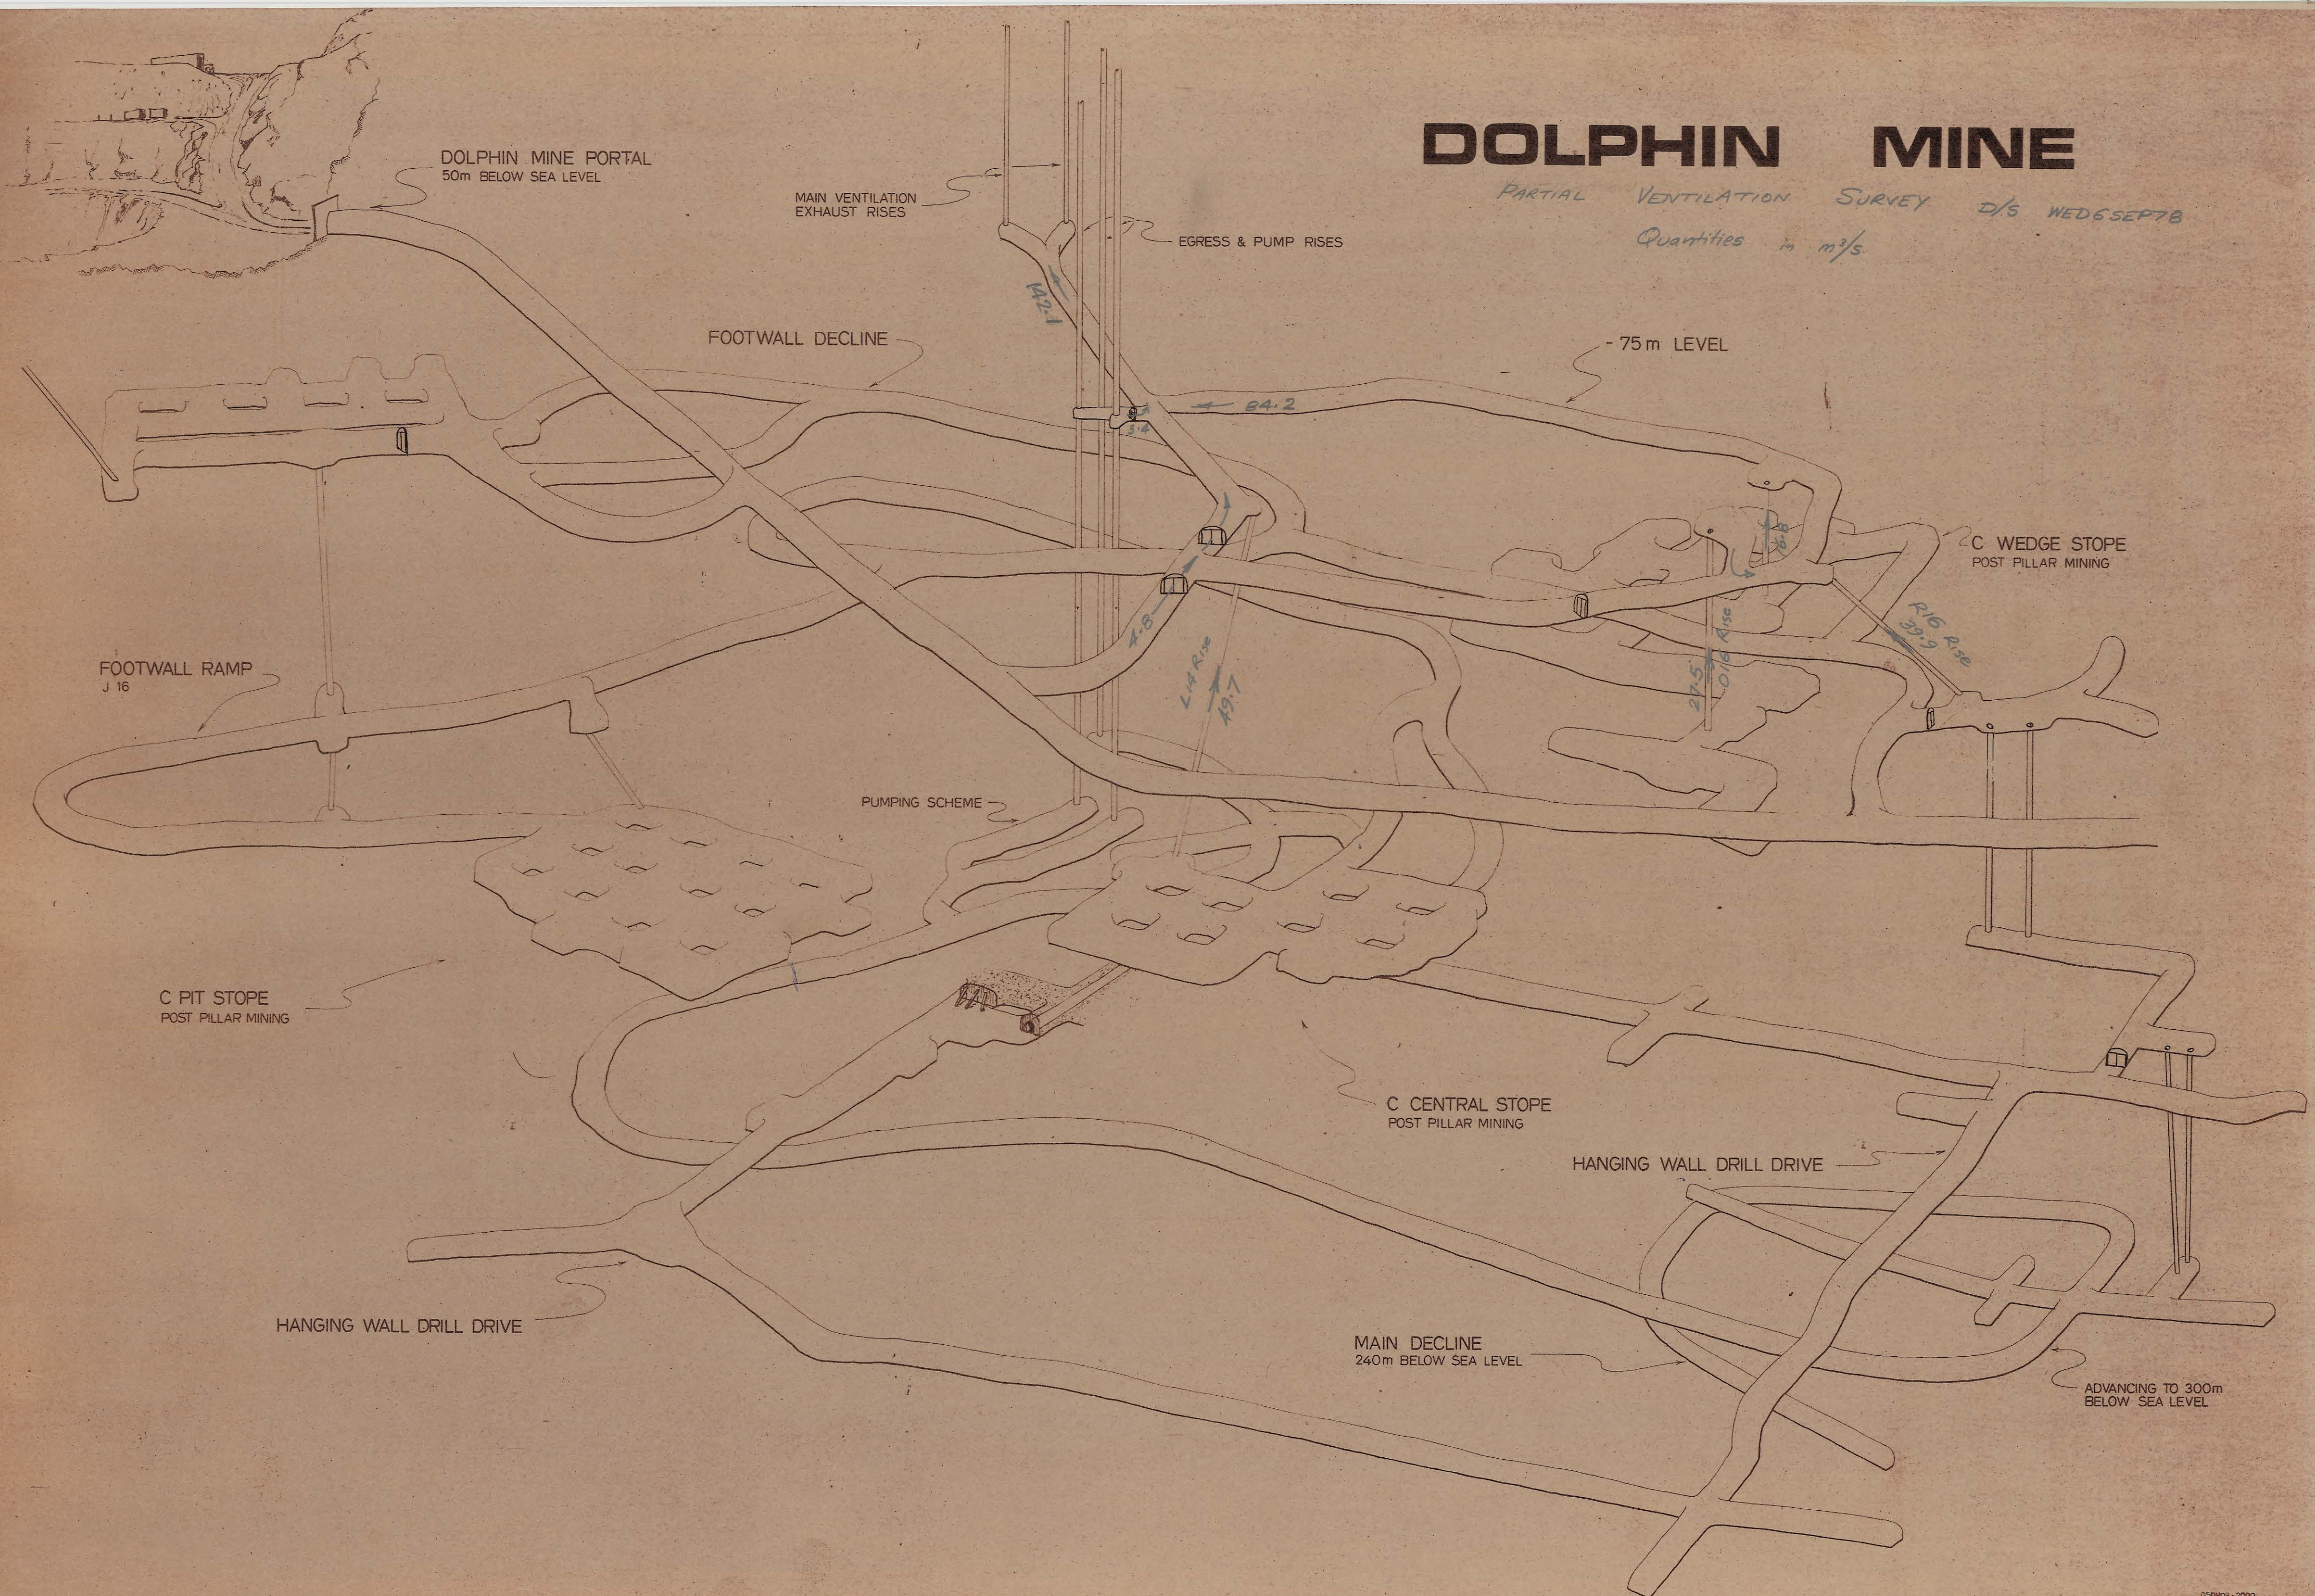

5m

05DM09-2008

0374_3388

05DM09-2008

05DM09-2008
SAC 090577