


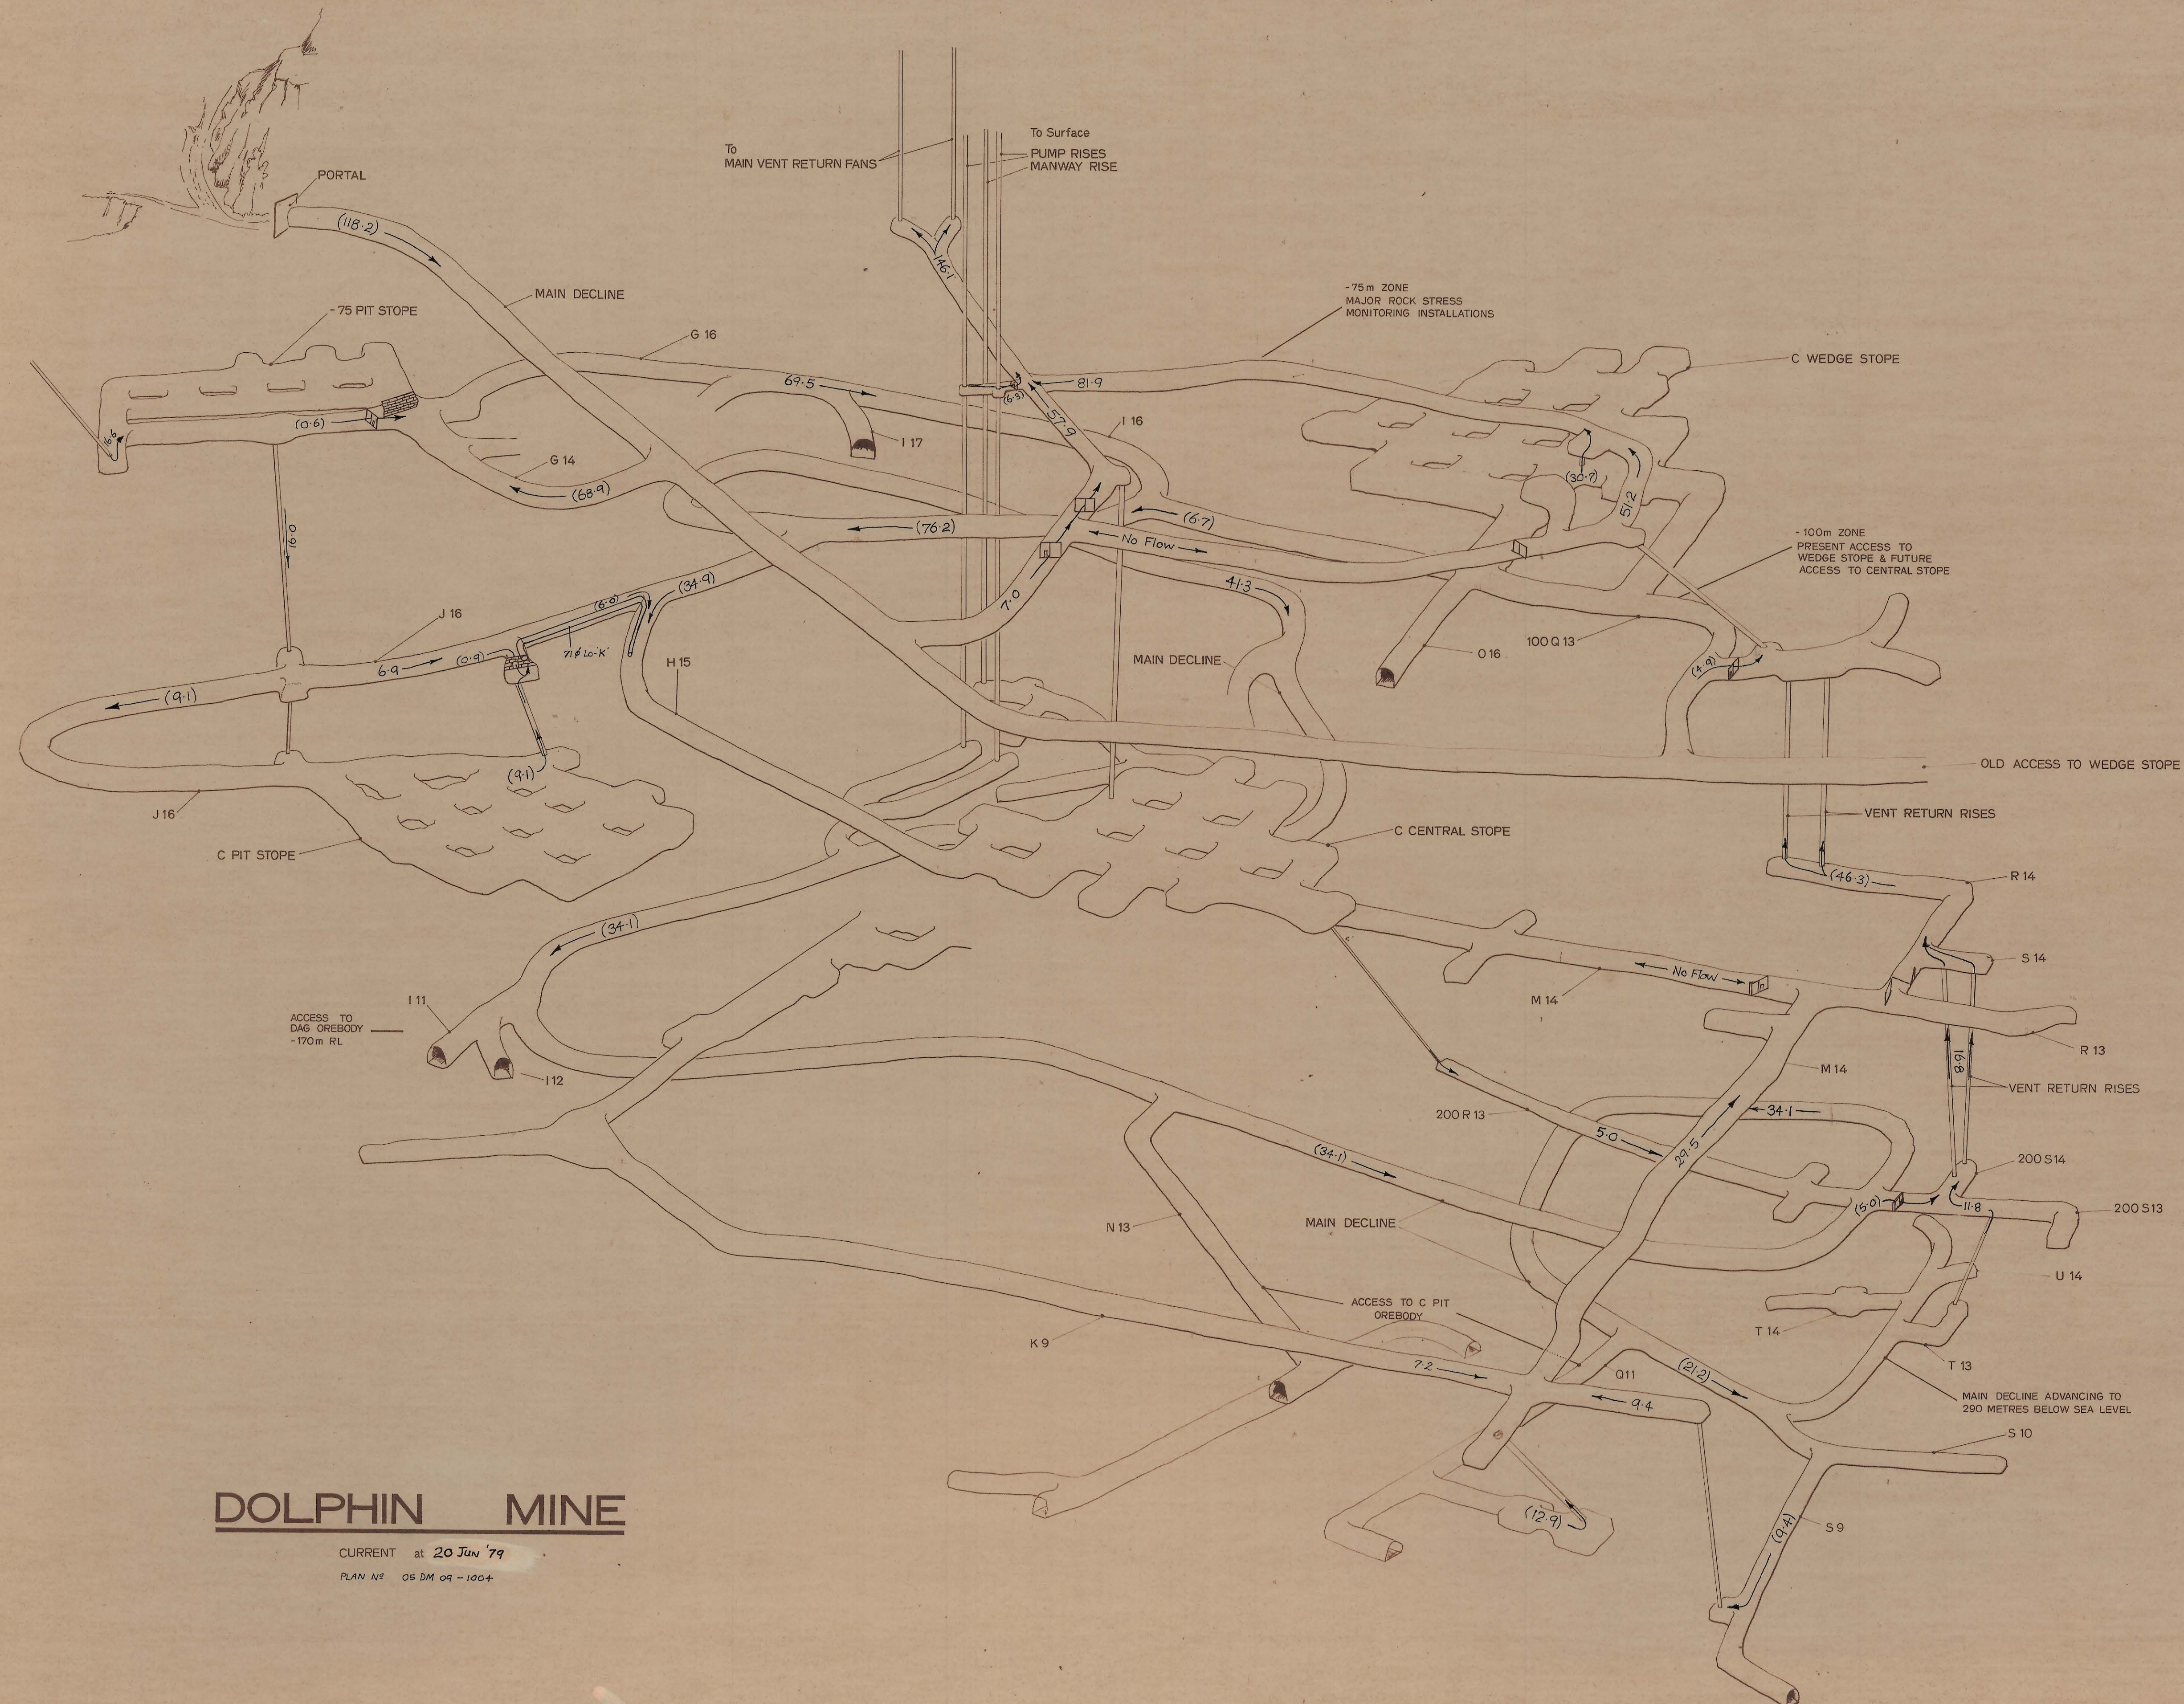

DOLPHIN MINE

CURRENT at 20 Jun '79
PLAN NR 05 DM 09 - 1004