


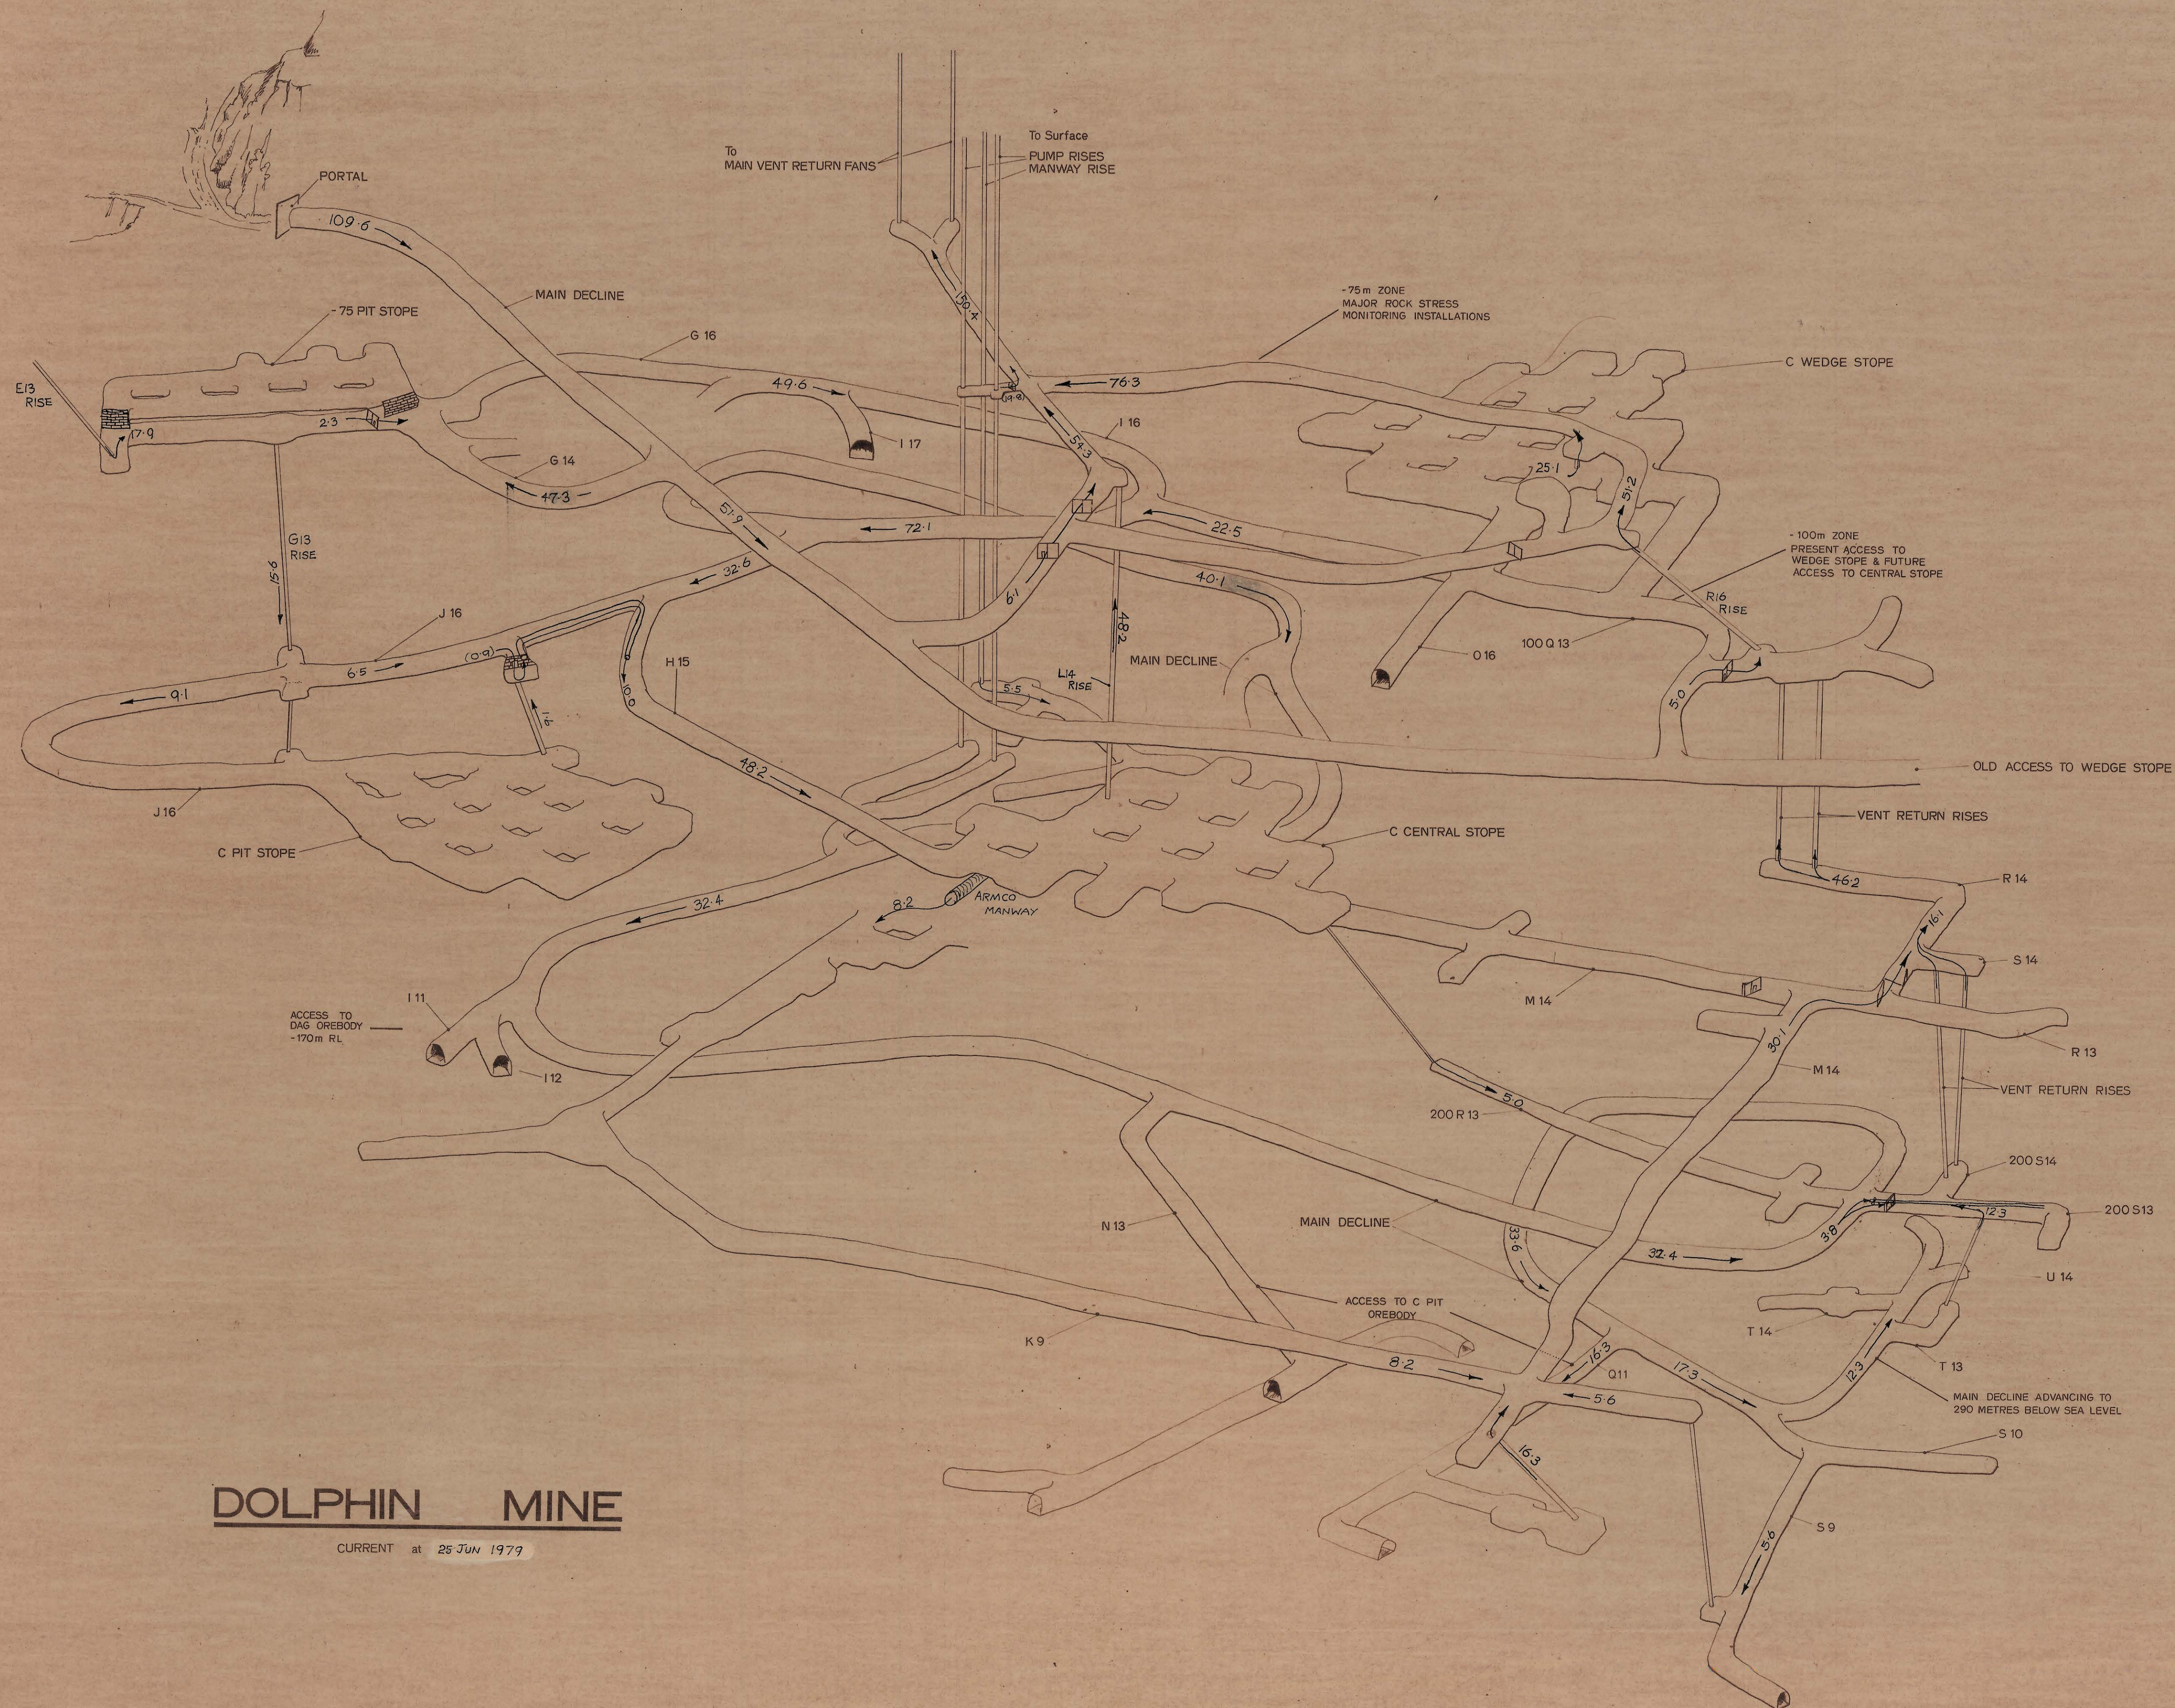

DOLPHIN MINE

CURRENT at 25 Jun 1979