


27 JUN 1981

5 cm

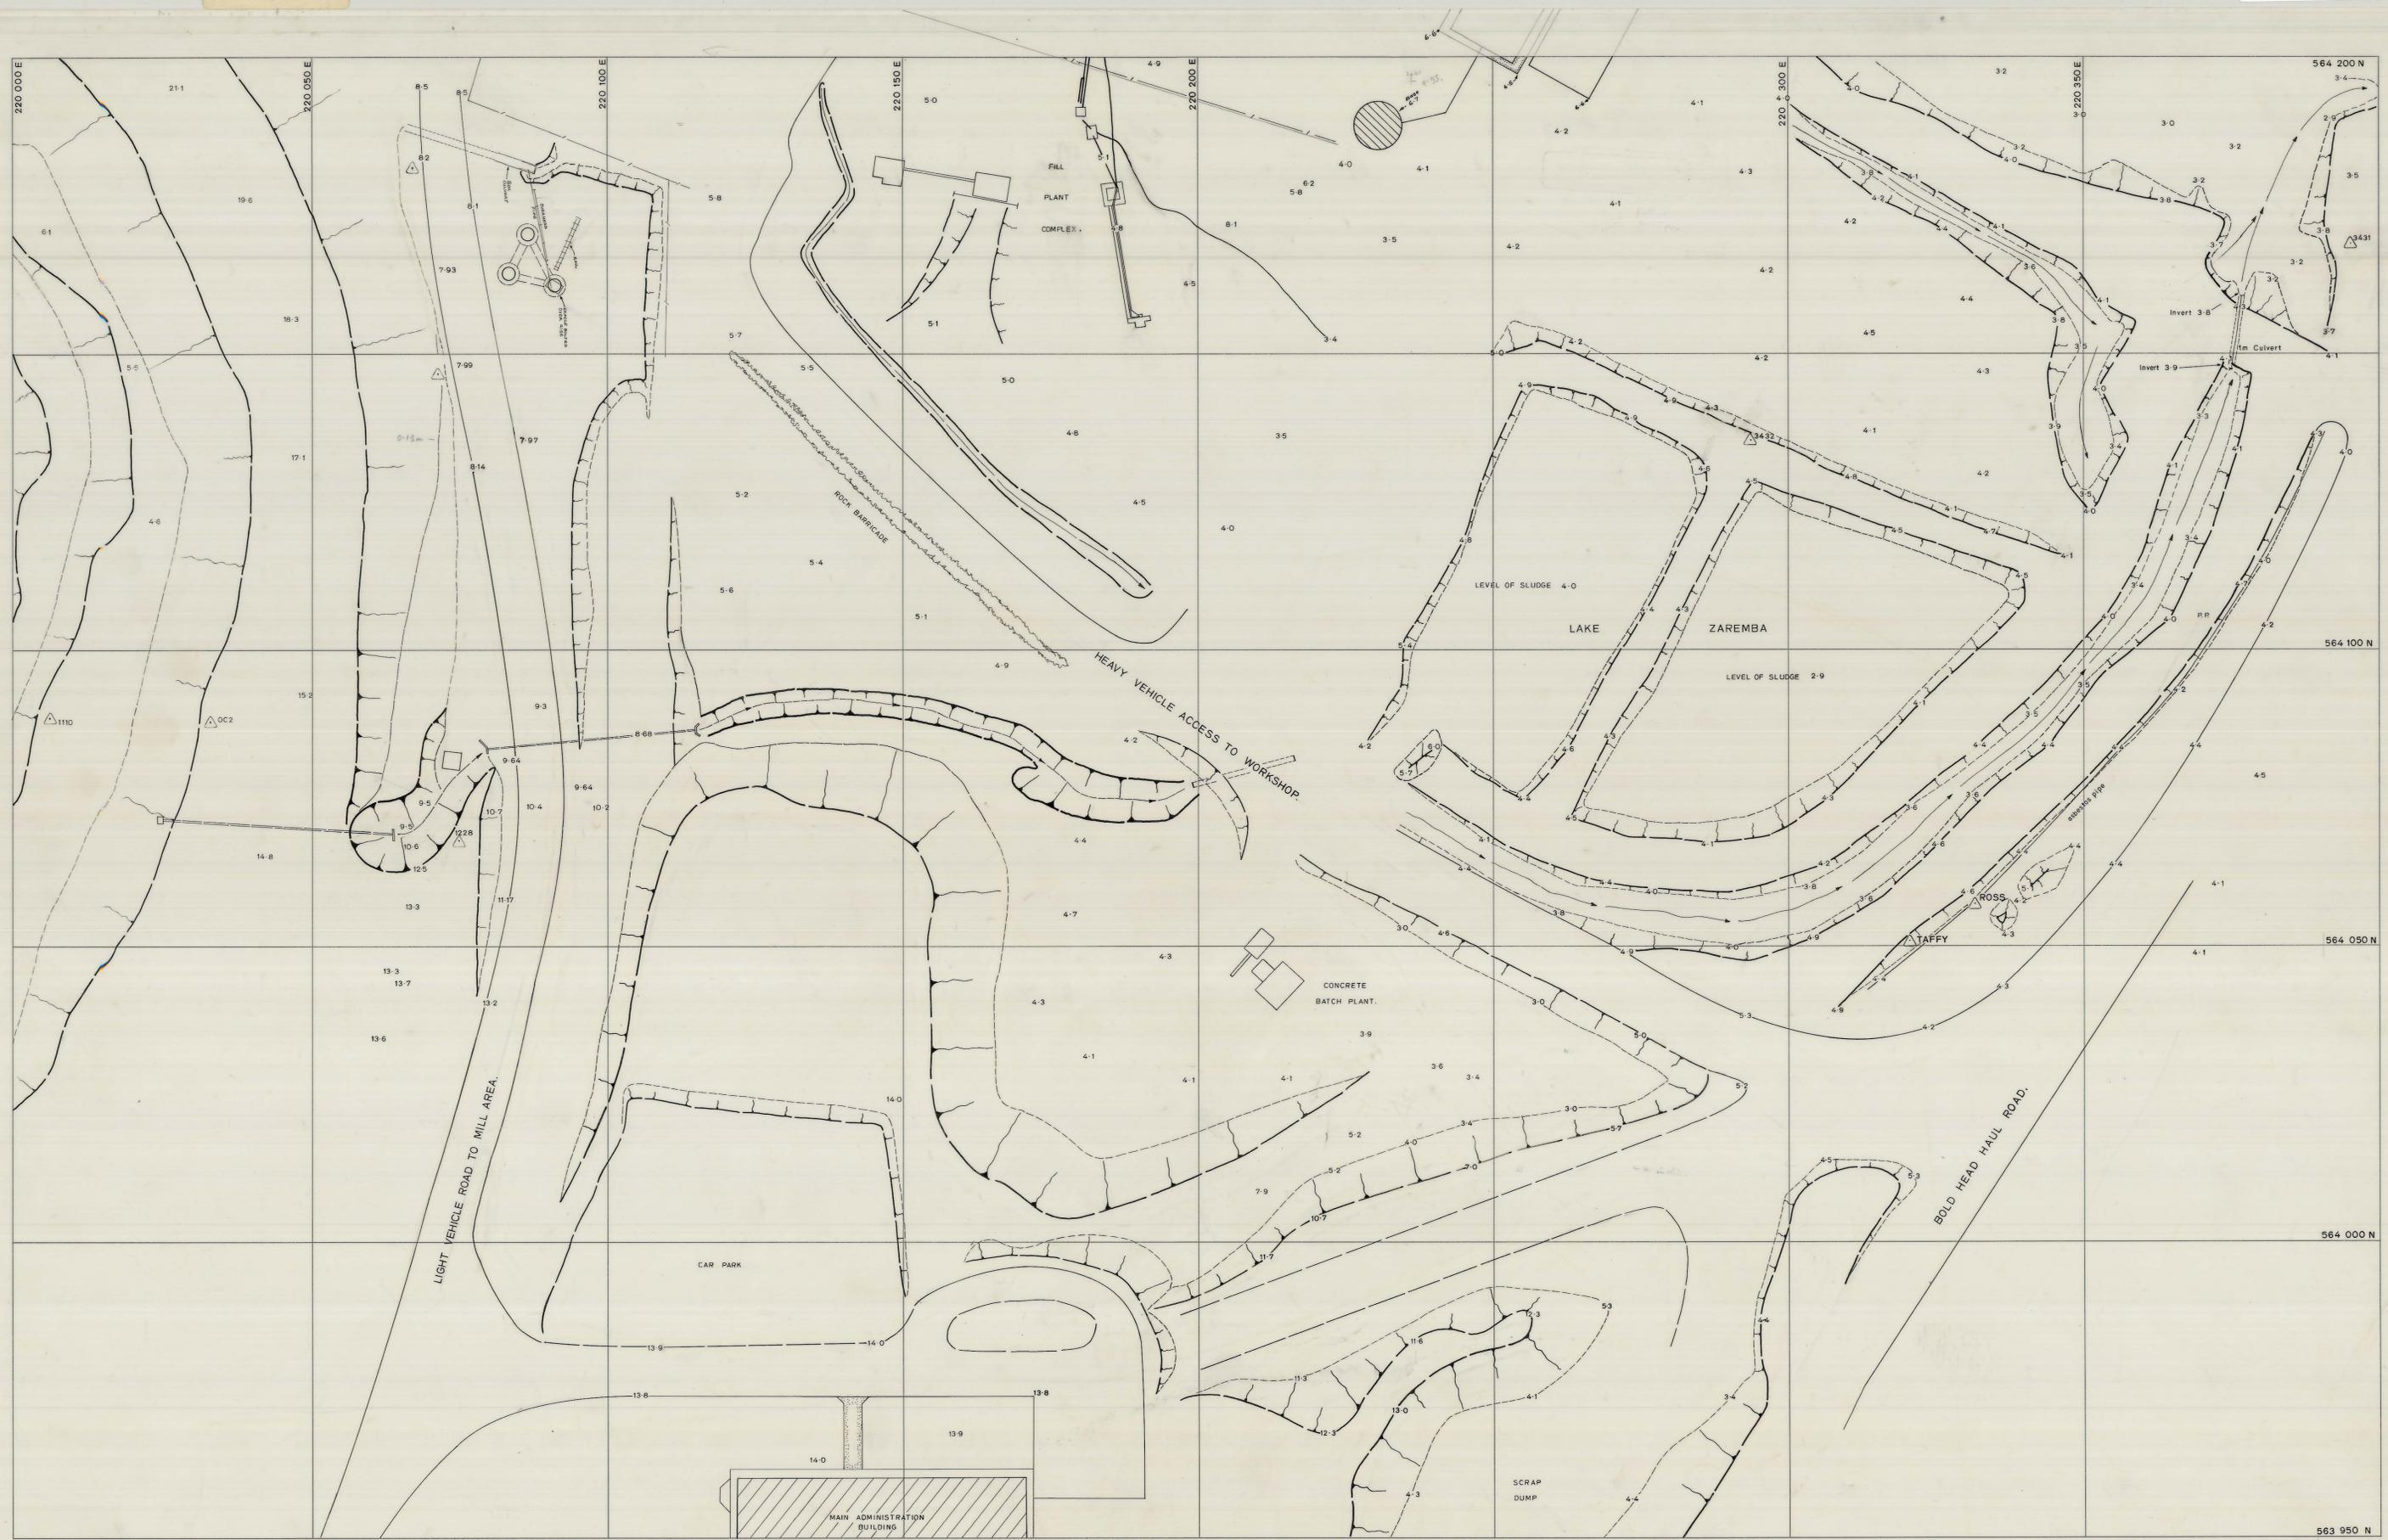

	SCALE 1:500	LOCATION WORKS AREA SUBJECT	 A DIVISION OF WARMAN INTERNATIONAL GRASSY KING ISLAND PLAN NUMBER 046 D 03 - 0098 II
		north	