27 JUN 1981

04WA02-100065

0374_3420

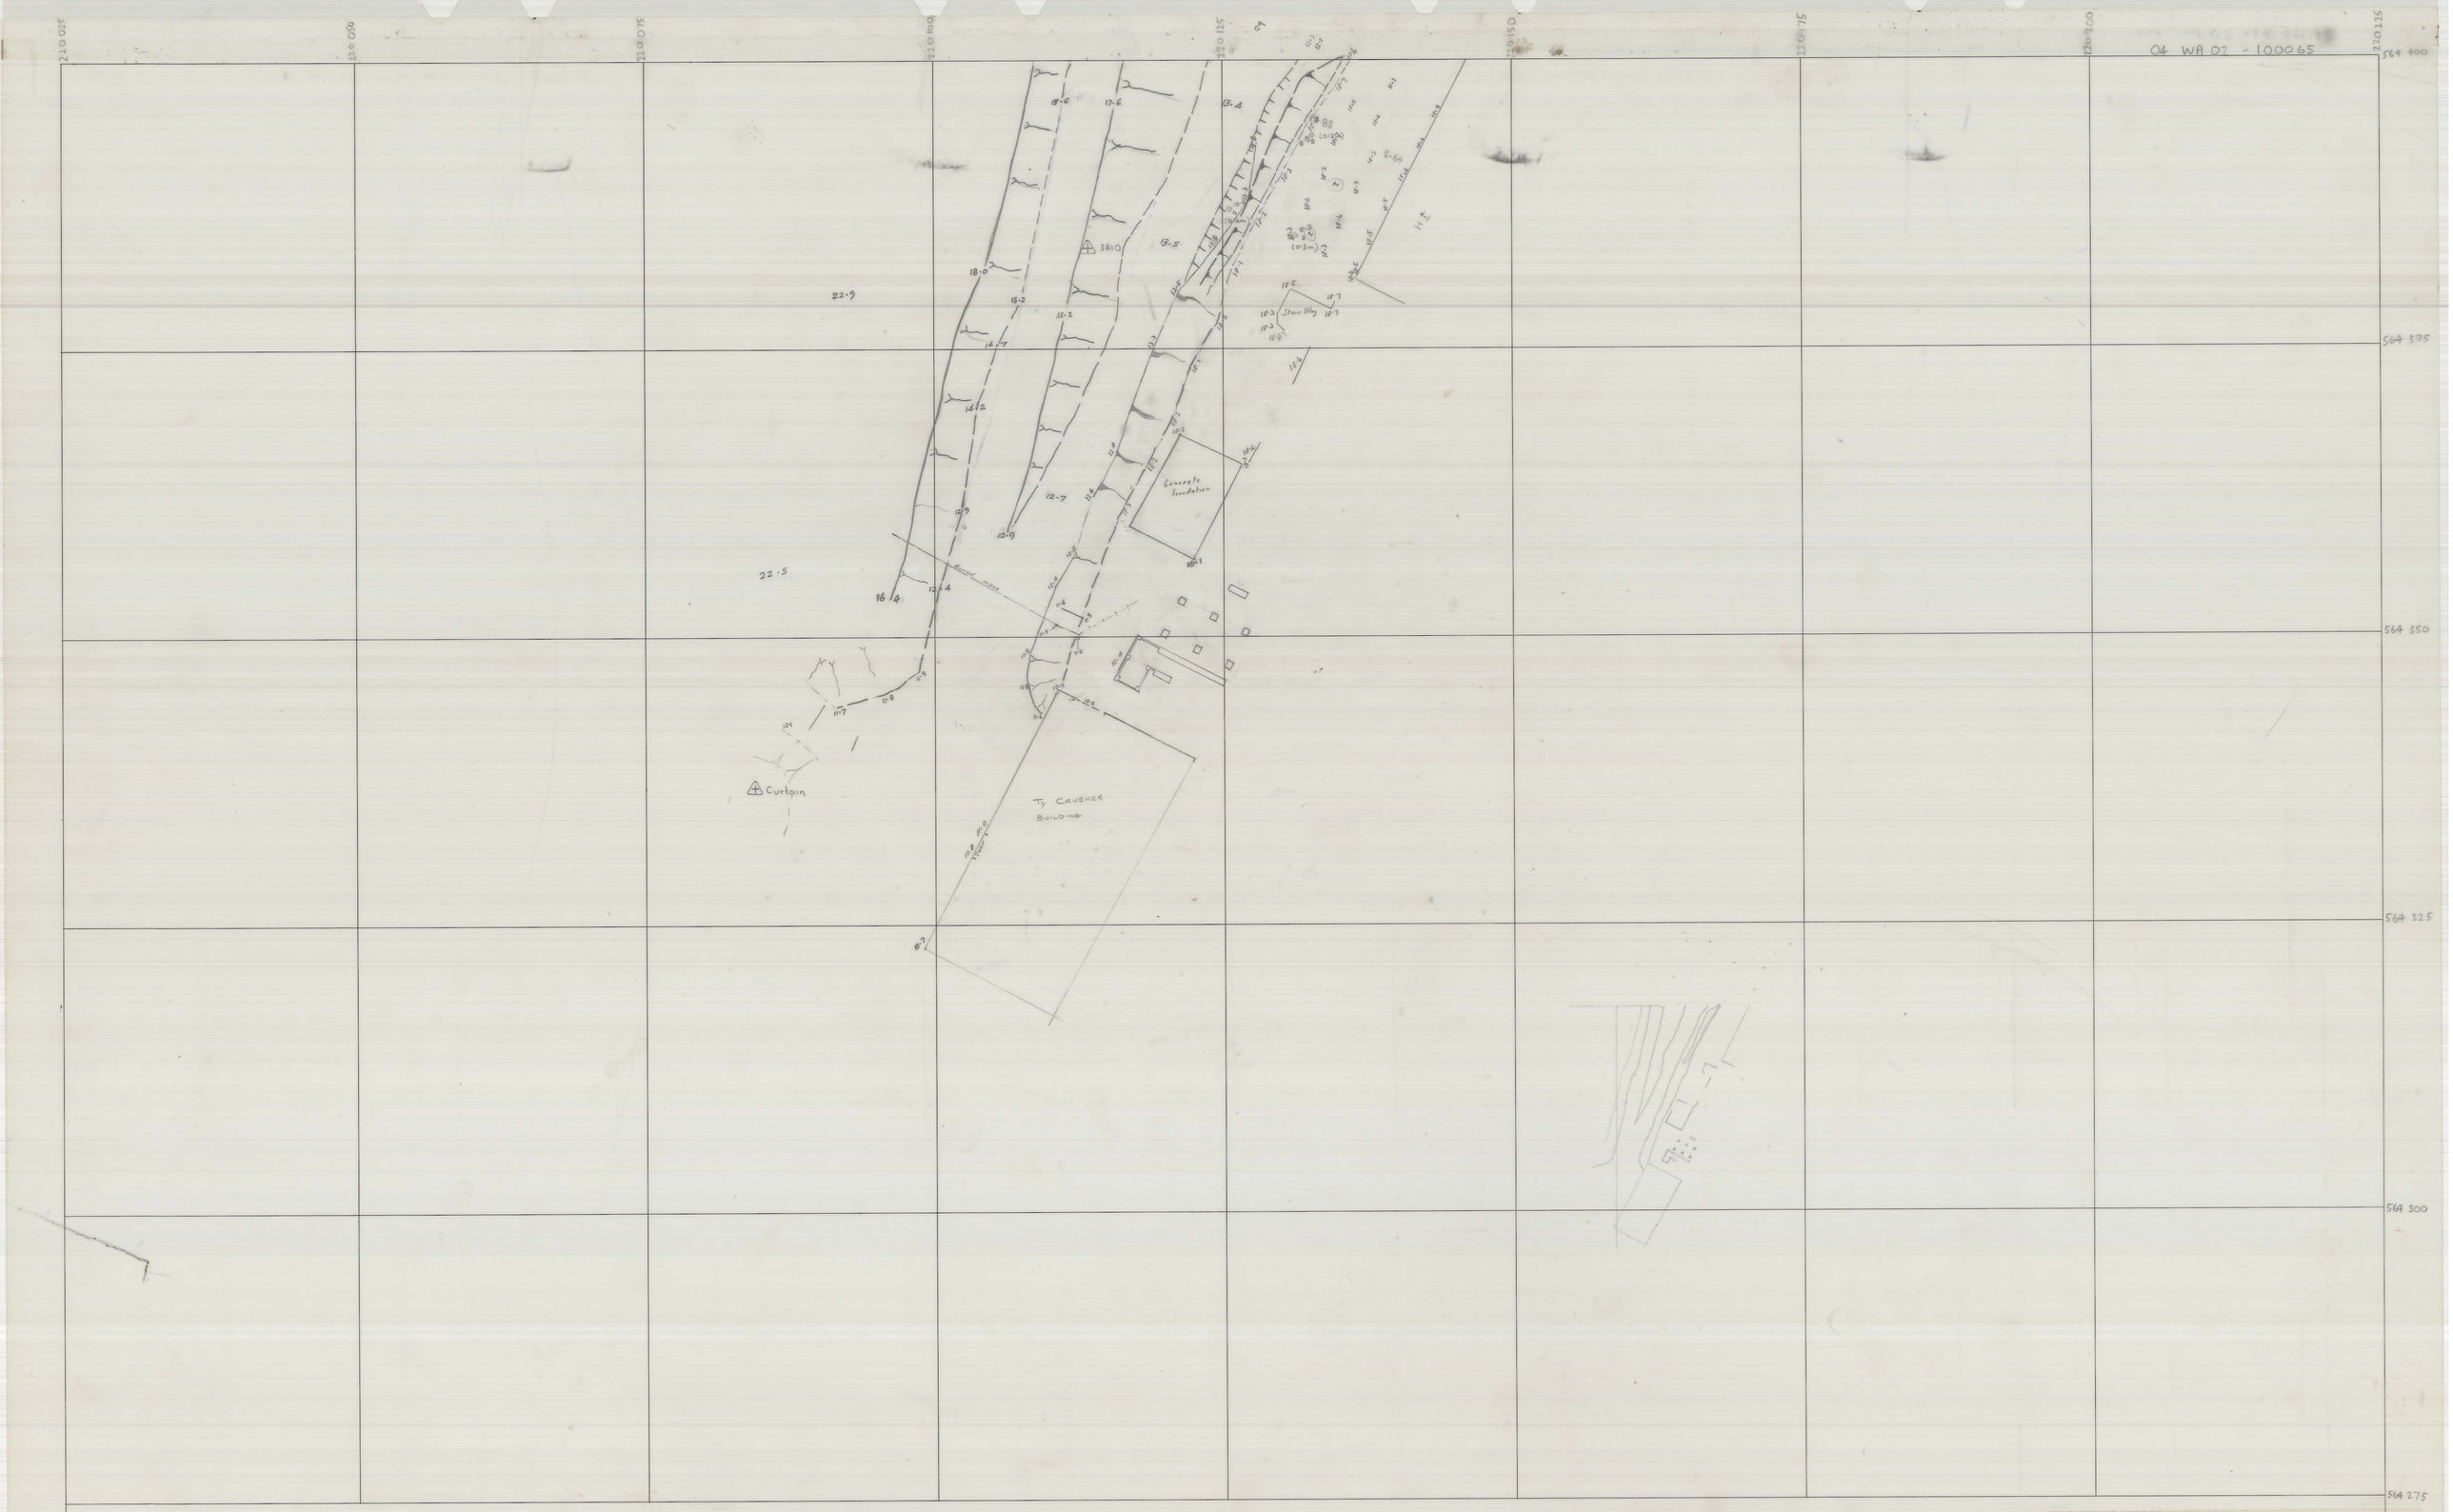

LINE	BEARING	H. D.	LATITUDE	DEPARTURE	R.L.	STN

SCALE 1: 250

north

LOCATION: WORKSHOP - MILL AREA

SUBJECT:

KING ISLAND SCHEELITE
A DIVISION OF WARMAN INTERNATIONAL

GRASSY KING ISLAND

PLAN NUMBER: 04 WA 02 -100065