



05BH05-100101

0374_3496

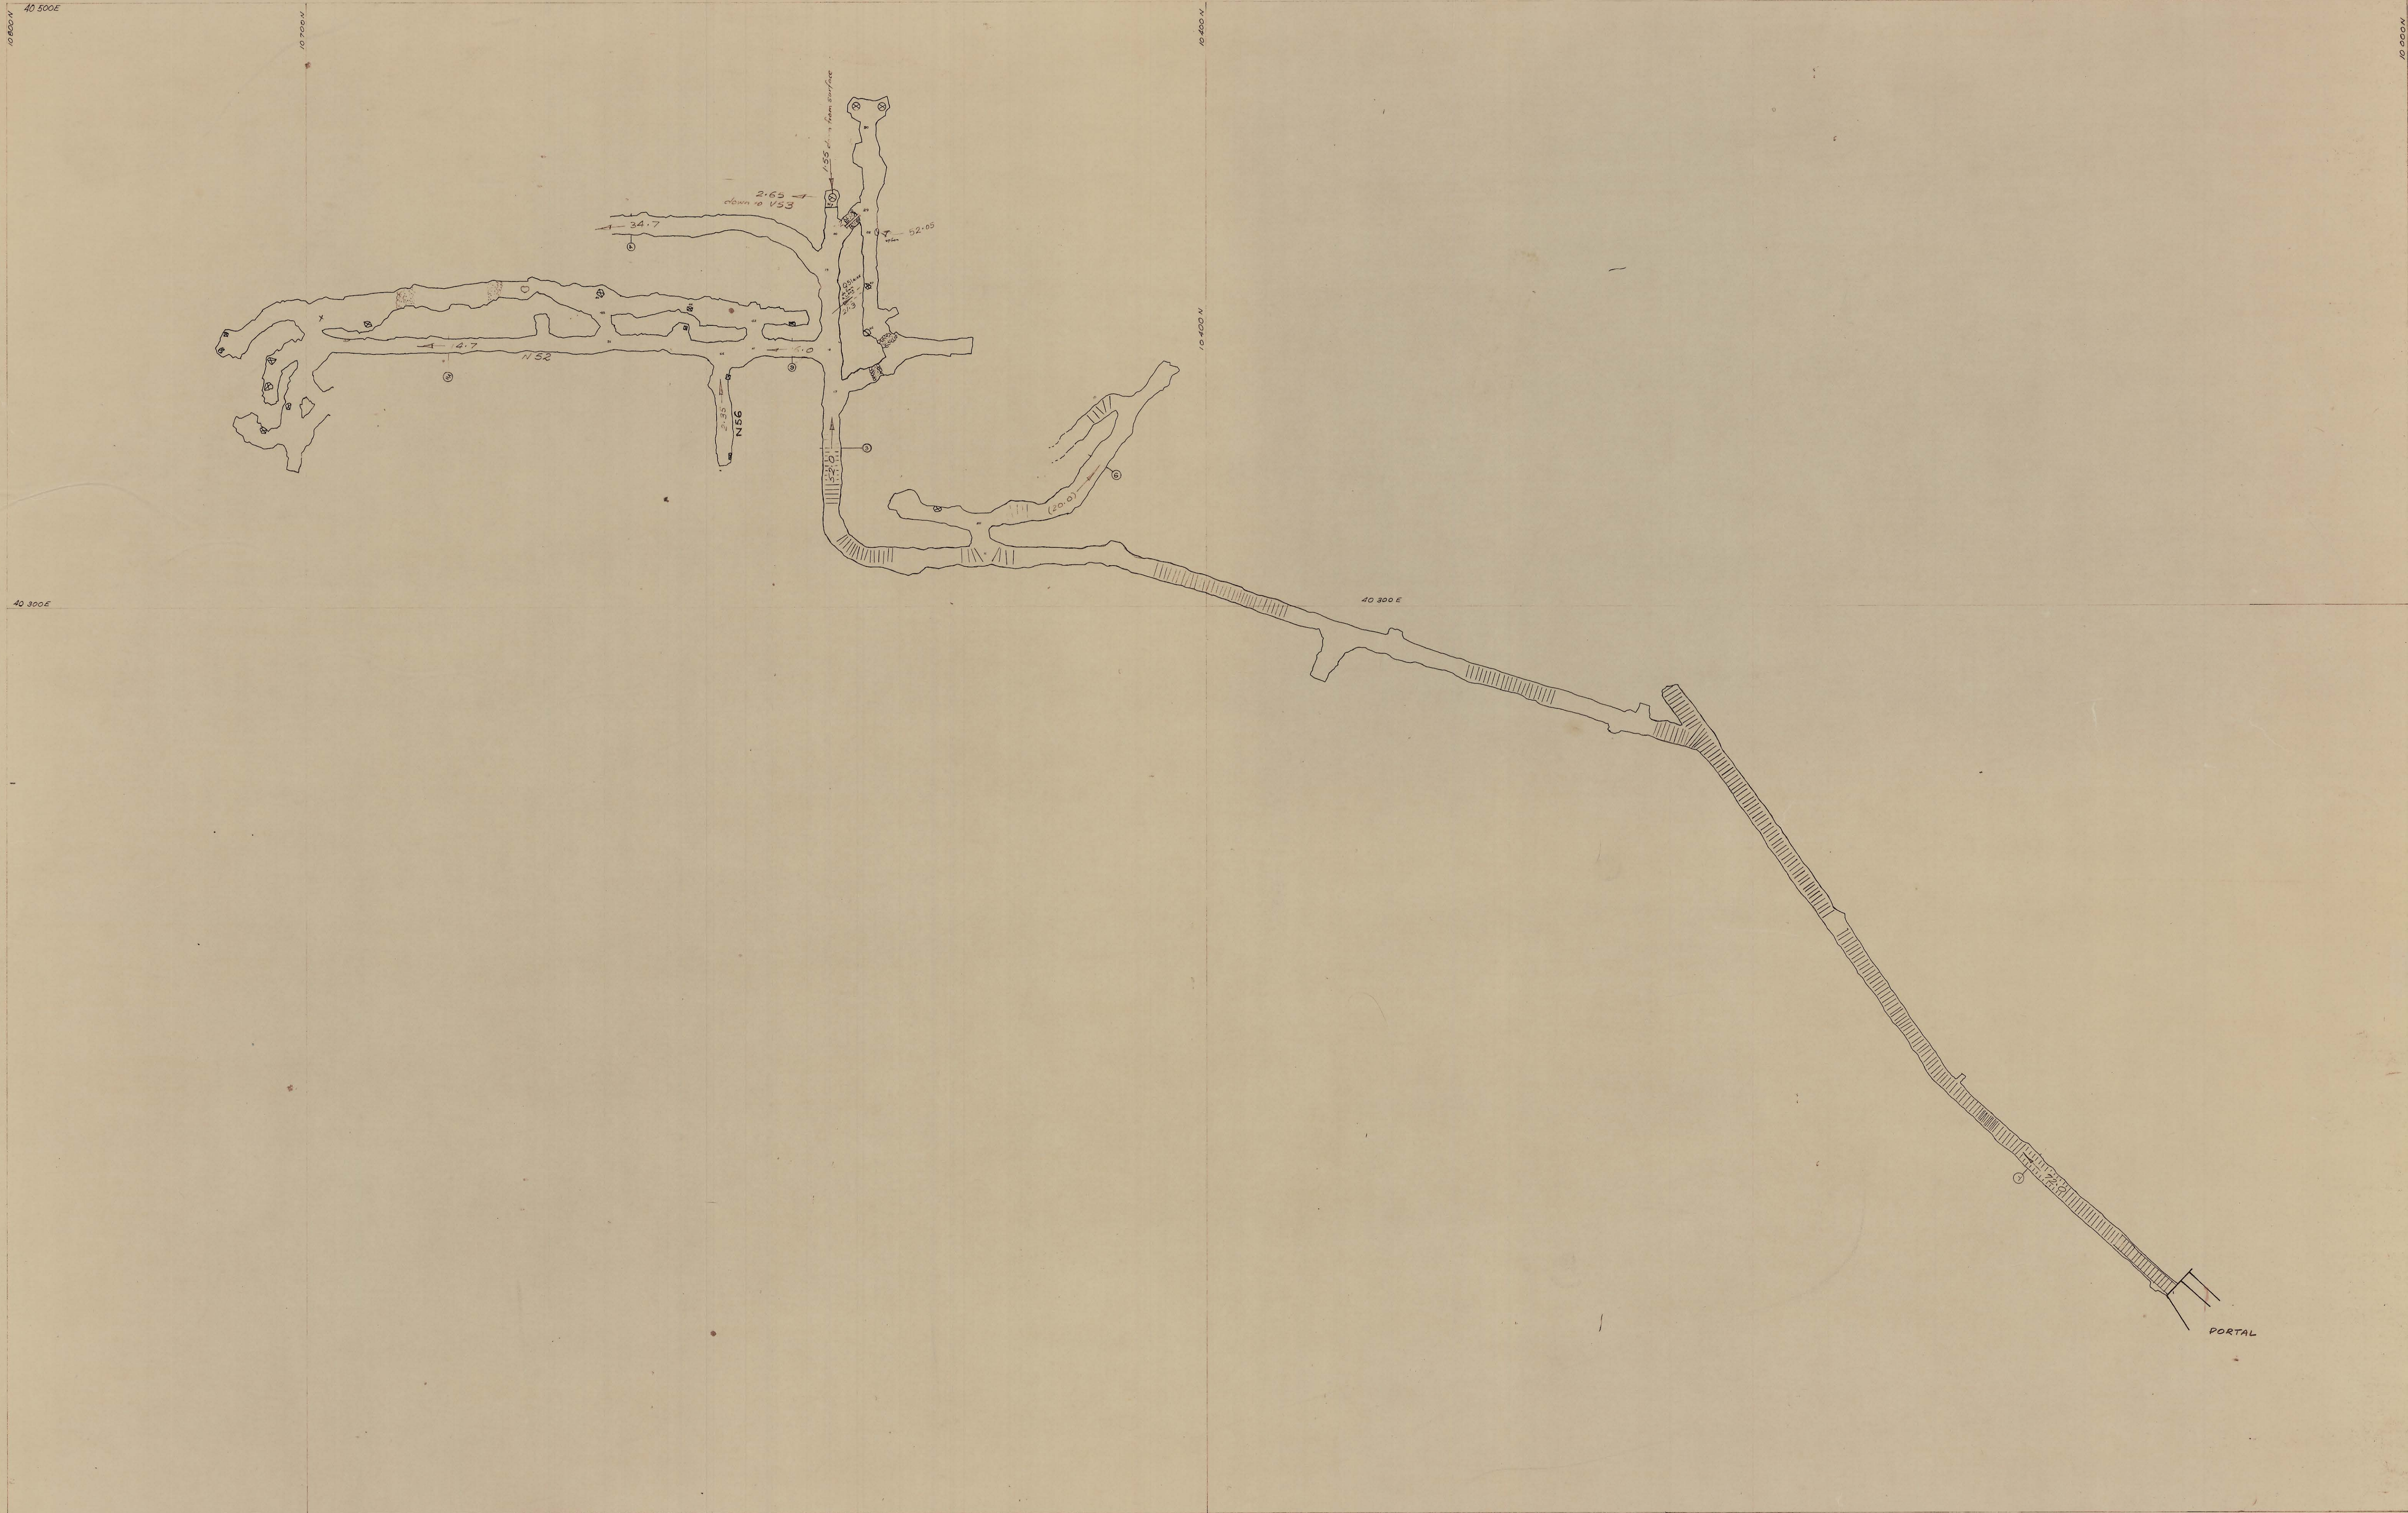

SCALE 1:1000

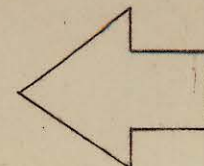

North

LOCATION	BOLD	HEAD	MINE
SUBJECT	AIRFLOW		
	Portal to Cribroom		
	JUNE 1978		

KIS KING ISLAND SCHEELITE
A DIVISION OF WARMAN INTERNATIONAL
GRASSY KING ISLAND
PLAN NUMBER 05BH05 - 100/Q1