


OSDM05-0005

1-22-43
OSDM05-0005
1:250

0374_3525

5 cm

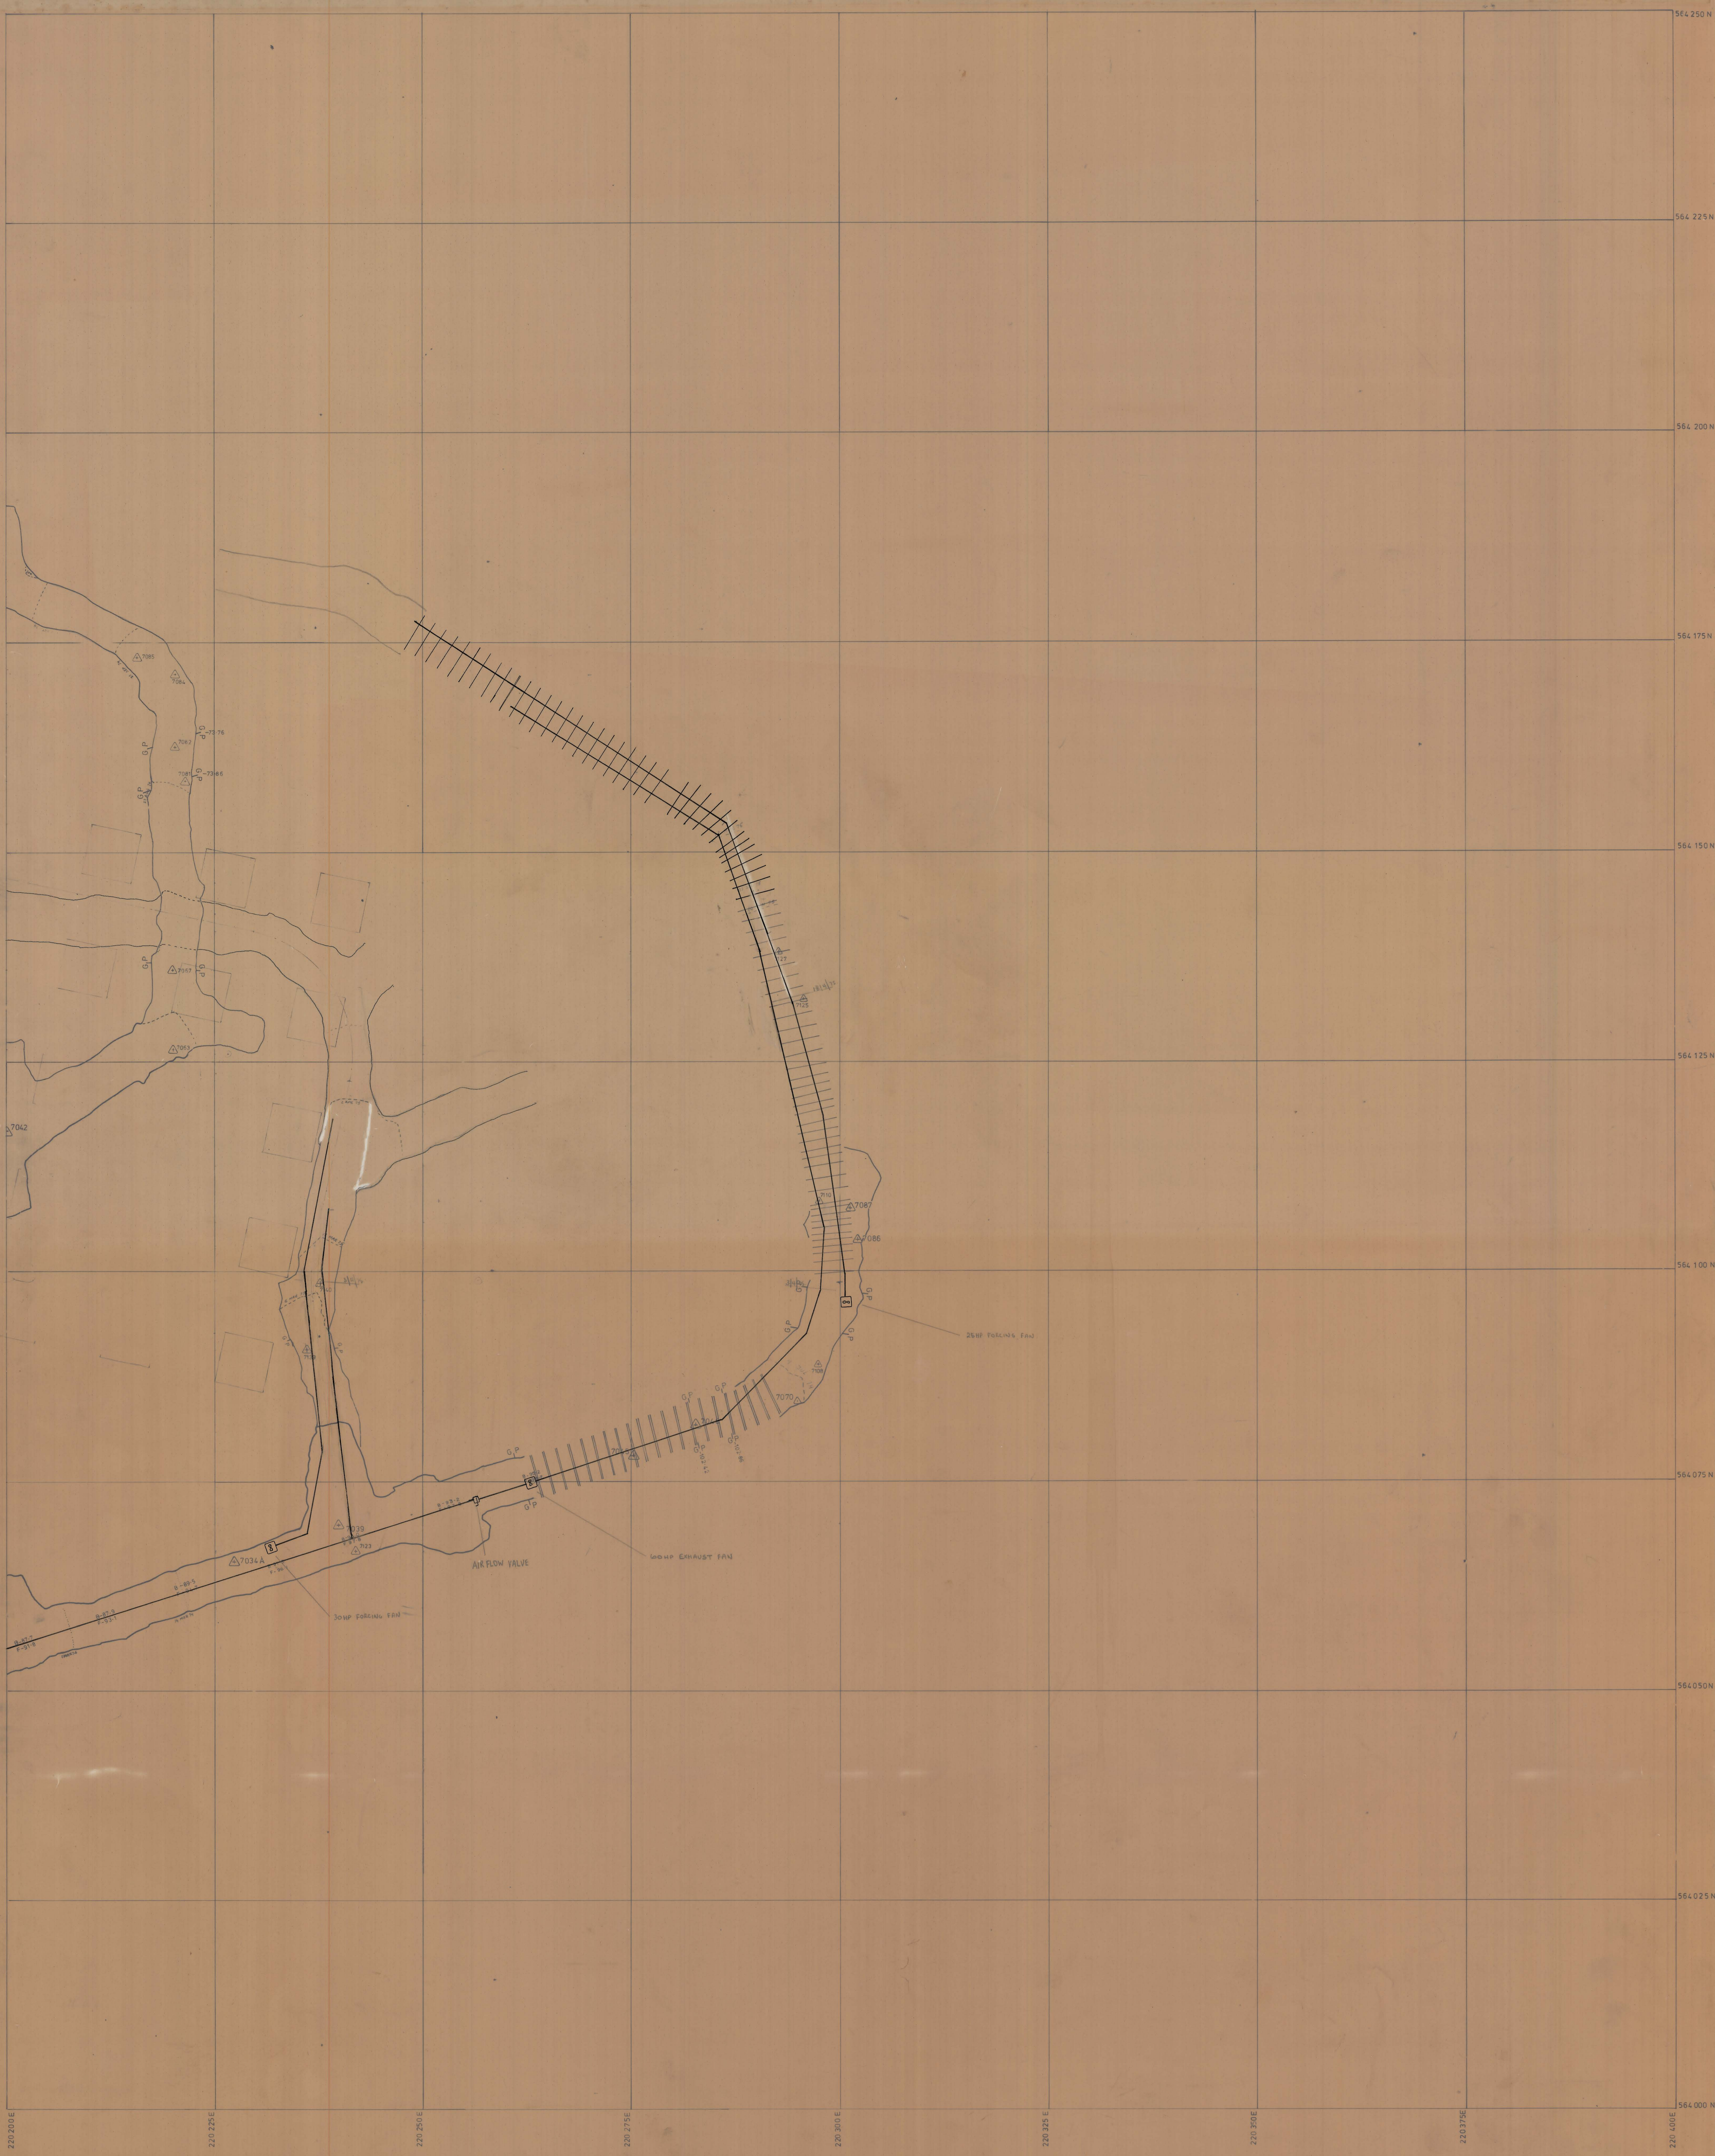

KING ISLAND SCHEELITE LTD.
DOLPHIN MINE

SCALE 1: 250

Working plan
OSDM05-0005
1/22/43

REVISED 2 - 4-75