


40 500 E

10 700 N

10 200 V

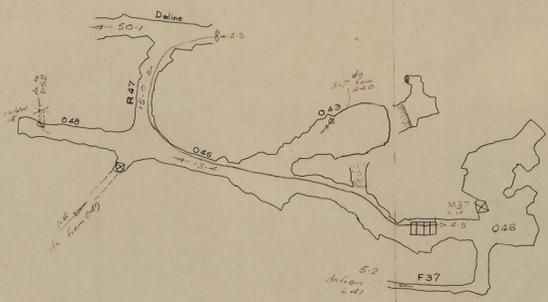

40 300 E

SCALE 1:1000	 north	LOCATION BOLD HEAD	 KING ISLAND SCHEELITE A DIVISION OF WARMAN INTERNATIONAL GRASSY KING ISLAND
		SUBJECT AIRFLOW PLAN B FAULT BLOCK	