5 cm

0374_3545

05BH05 – 100504

N 002 01

N 400 N

40 400 E

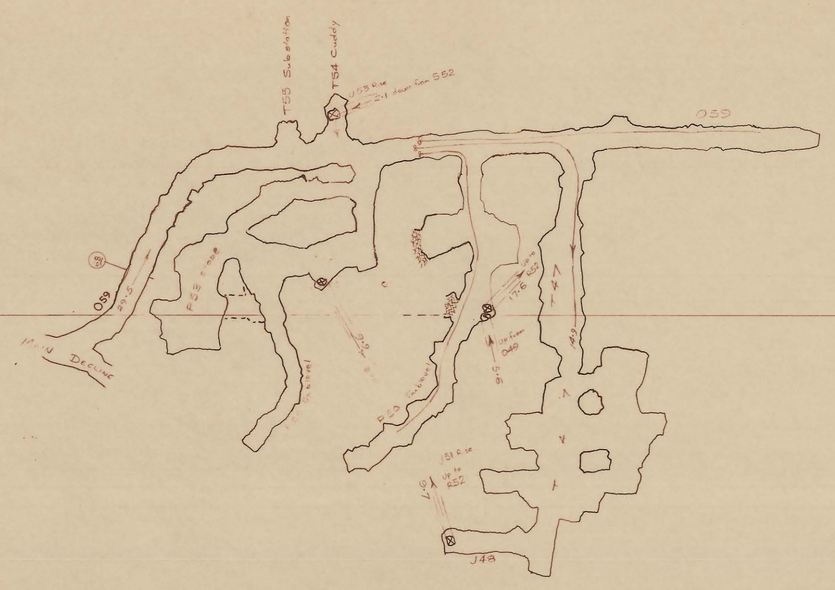
T54 Cuddy
