058H09 - 1002
0374_3547

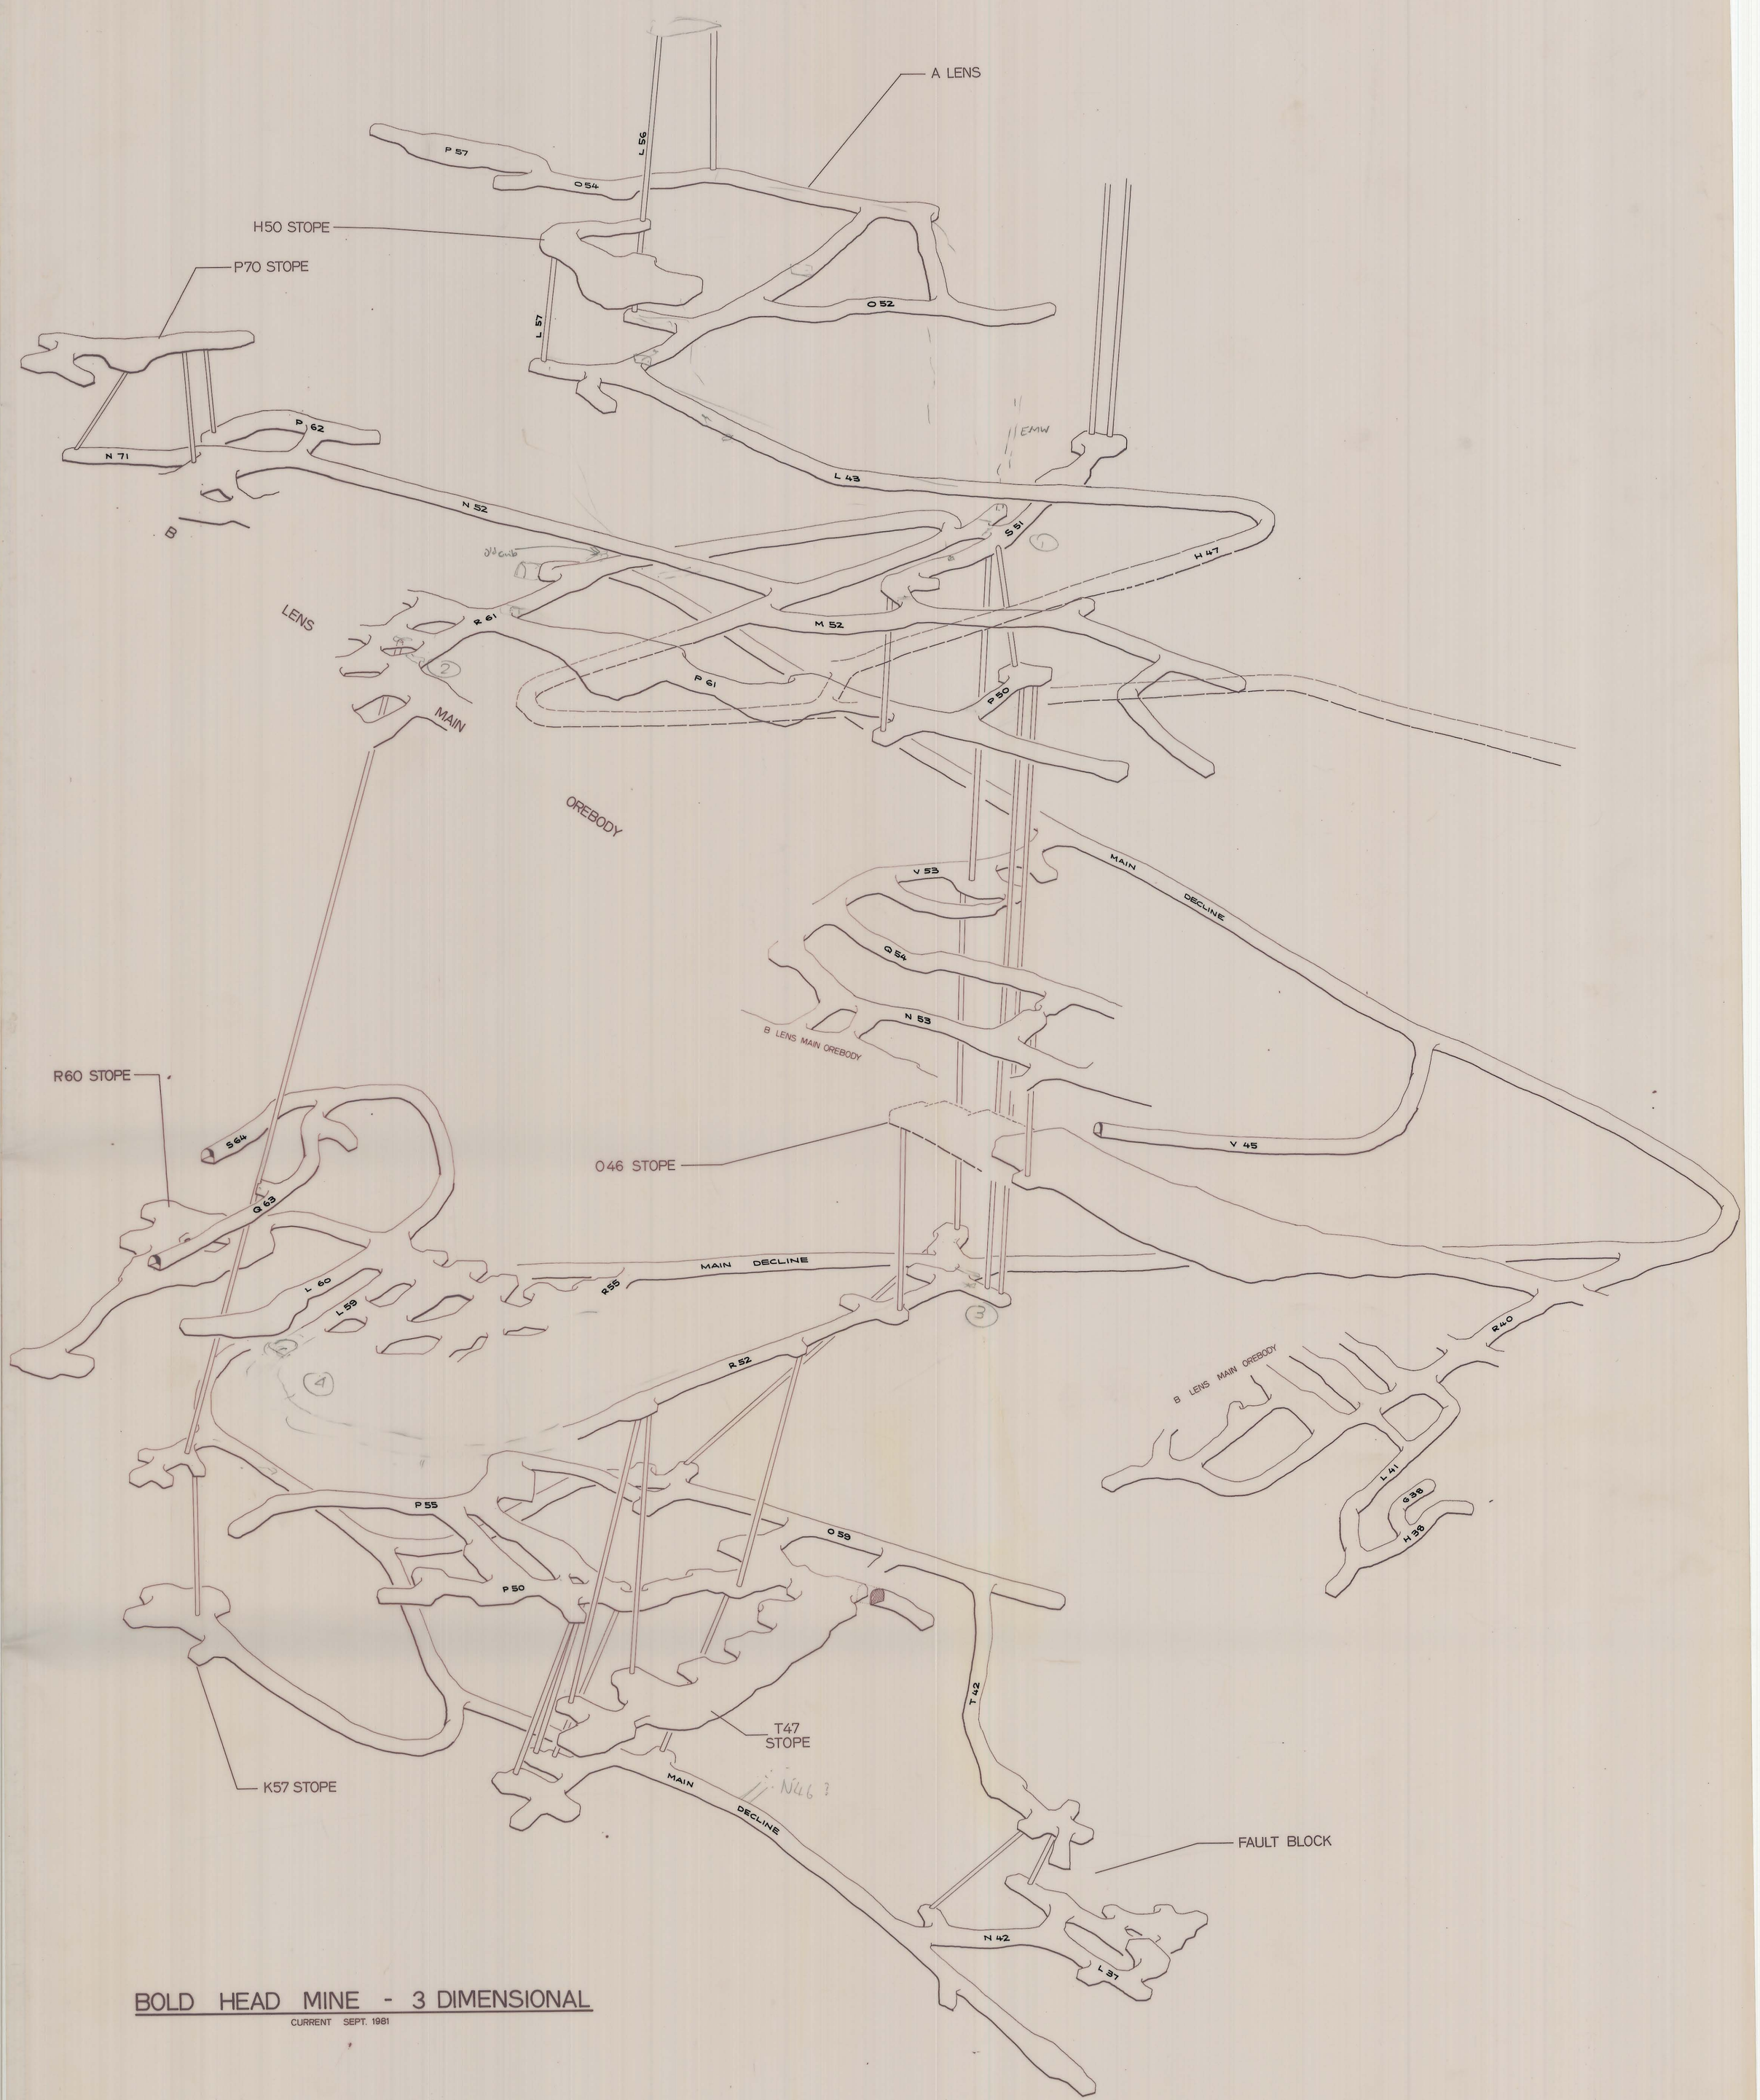

BOLD HEAD MINE - 3 DIMENSIONAL

CURRENT SEPT. 1981

5 cm