

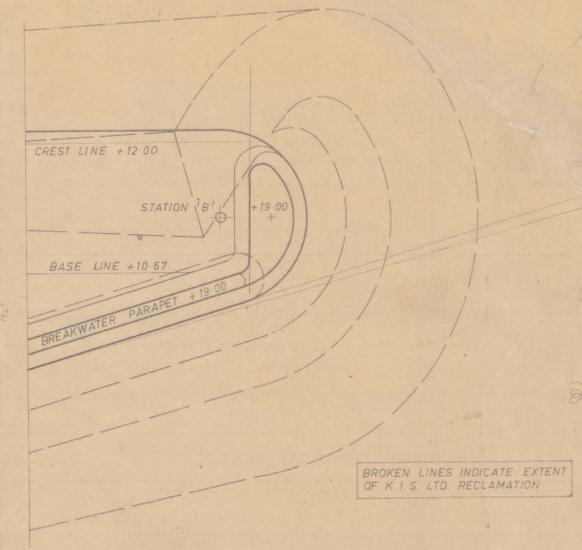
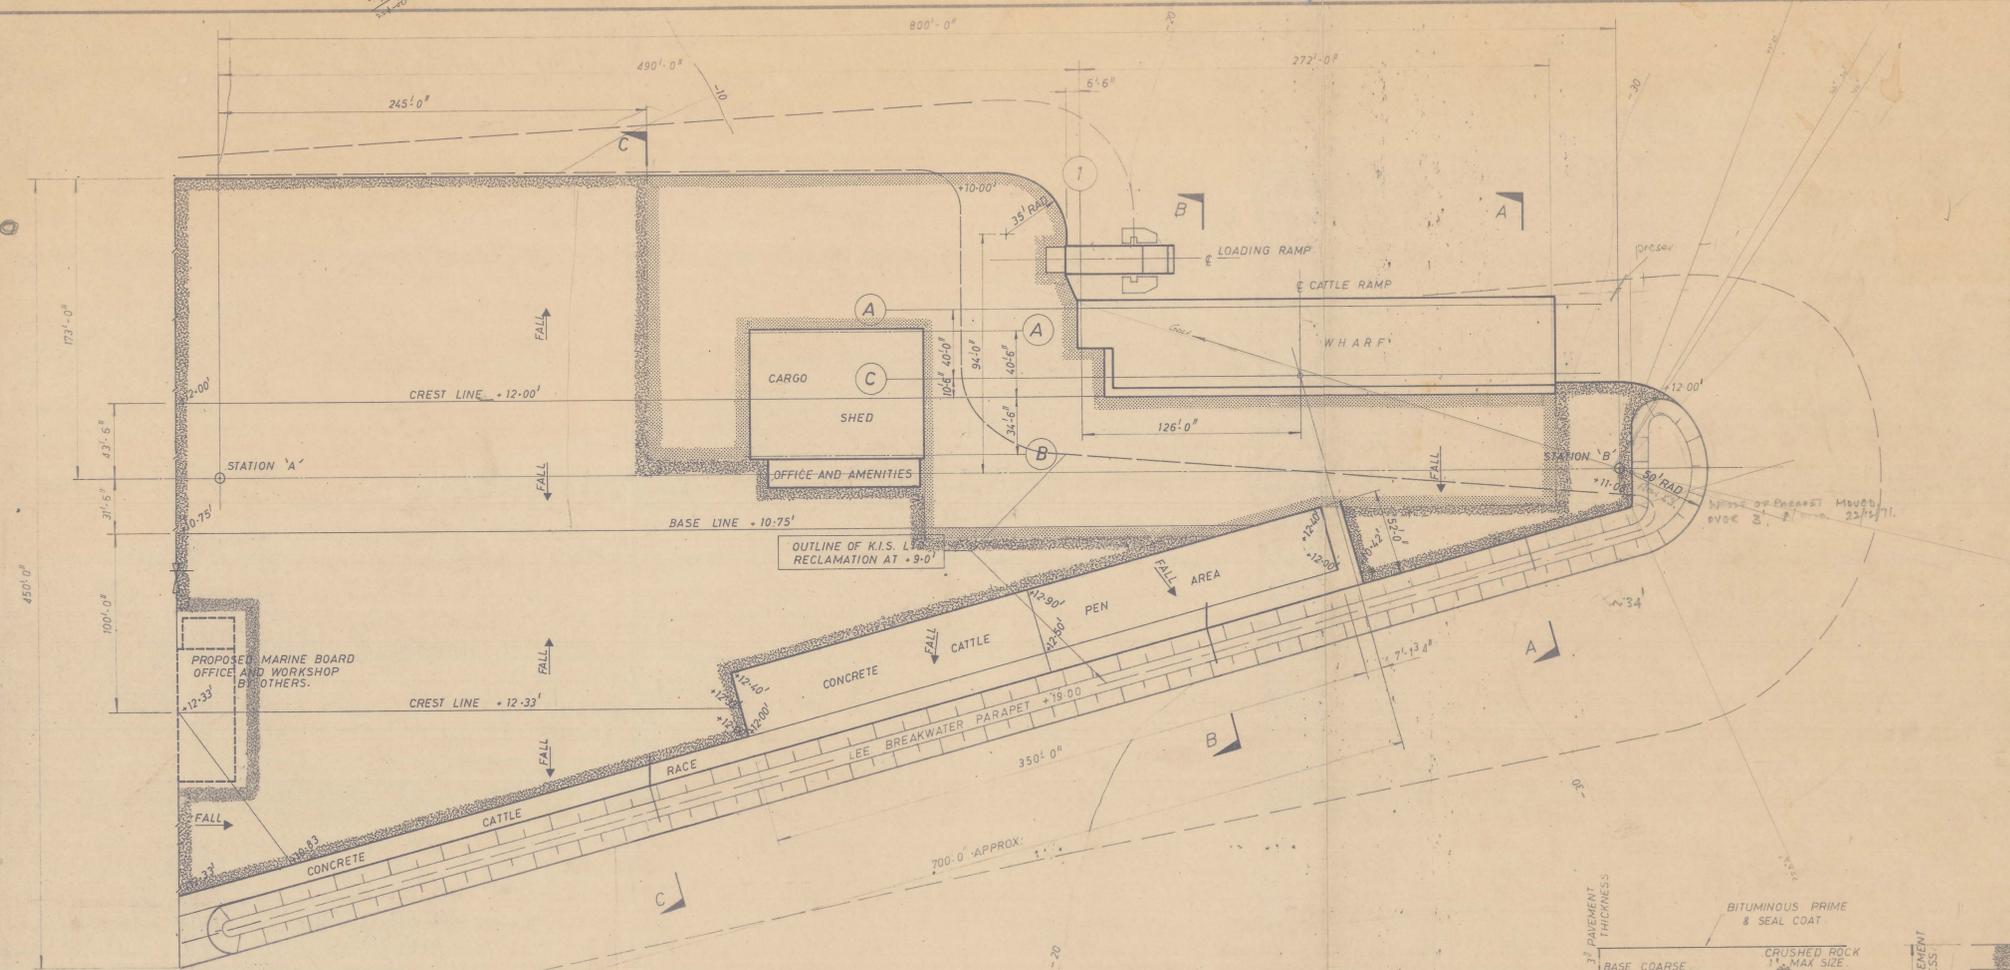


0374_3601

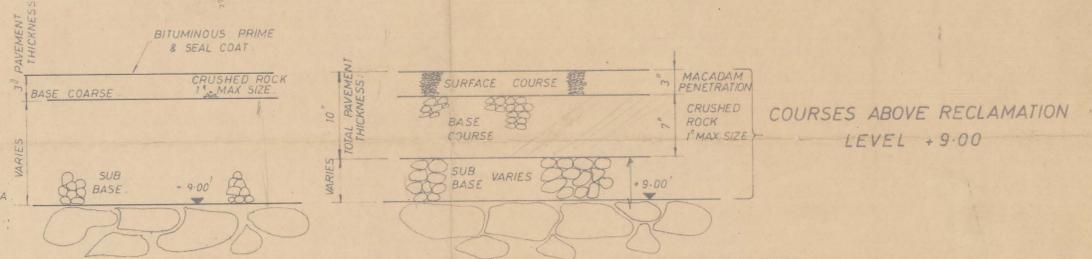


PAVEMENT PLAN
SCALE: 40'-0" TO 1"


RECLAMATION HEAD DETAIL
SCALE 40'-0" TO 1"

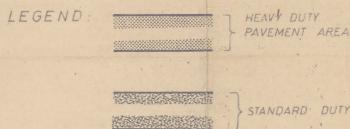


- GENERAL NOTES:
1. FOR DRAINAGE AND PIT DETAILS REFER TO DRG NO 2070/104
 2. FULL DETAILS OF BREAKWATER PROFILE TO BE CONSTRUCTED BY K.I.S. LTD. SHOWN DRG NO 2070/14C
 3. ALL WORK ABOVE R.L. +9.00' TO BE DONE BY CONTRACTOR. WORK BELOW THIS LEVEL DONE BY K.I.S. LTD.

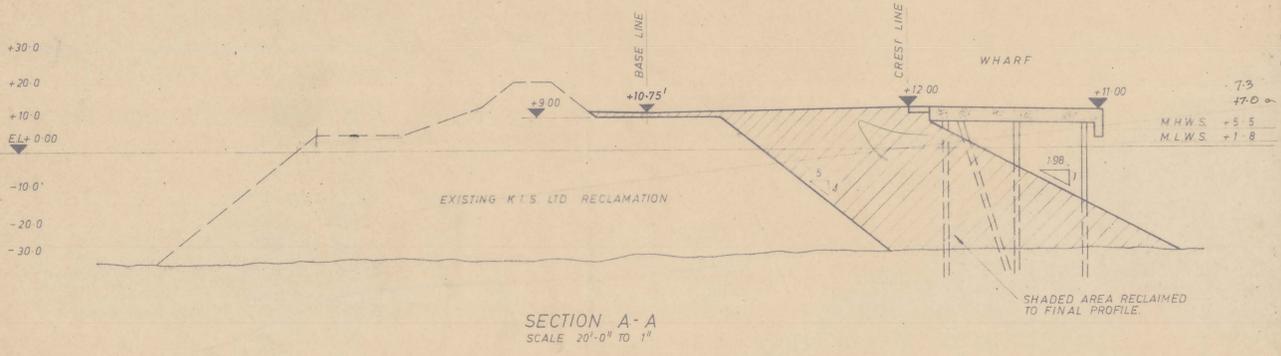

SECTION A-A
SCALE: 20'-0" TO 1"

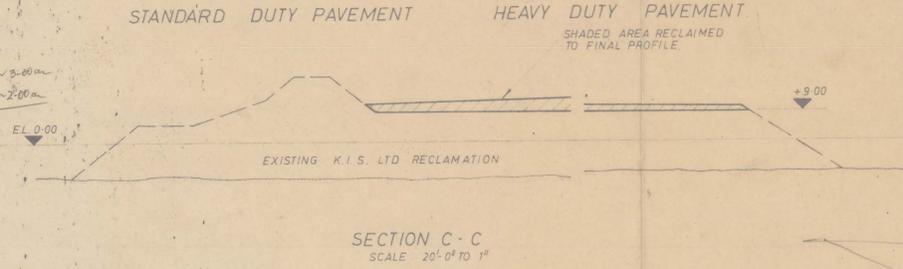

SECTION C-C
SCALE: 20'-0" TO 1"

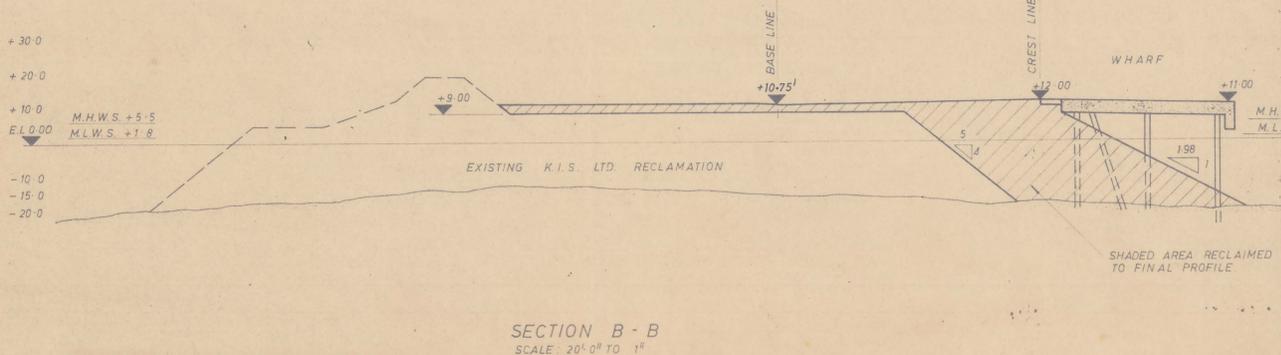

SECTION B-B
SCALE: 20'-0" TO 1"

REV.	DATE	DESCRIPTION
D	15/10/71	PAVING NEAR MARINE BOARD WORKSHOP AMENDED
C	17/9/71	OFFICE/AMENITIES, RACE PAVING & LOCAL REGRADING.
B	2/7/71	WORKING DRAWING
A	5.5.71	DRAINAGE TRENCHES ADDED TO CARGO SHED.

KING ISLAND SCHEELITE LTD
PORT AT LITTLE GRASSY BAY

RECLAMATION AND PAVEMENT
DETAILS

MAUNSELL & PARTNERS PTY. LTD.
CONSULTING ENGINEERS

SCALE: AS SHOWN
DATE: FEB 1971
DATE OF ISSUE: N.W.
D.B.
K.A.B.

DRG. No. 2070/103^D
WORKING DRAWING

1-11-7 (4)