



5 cm

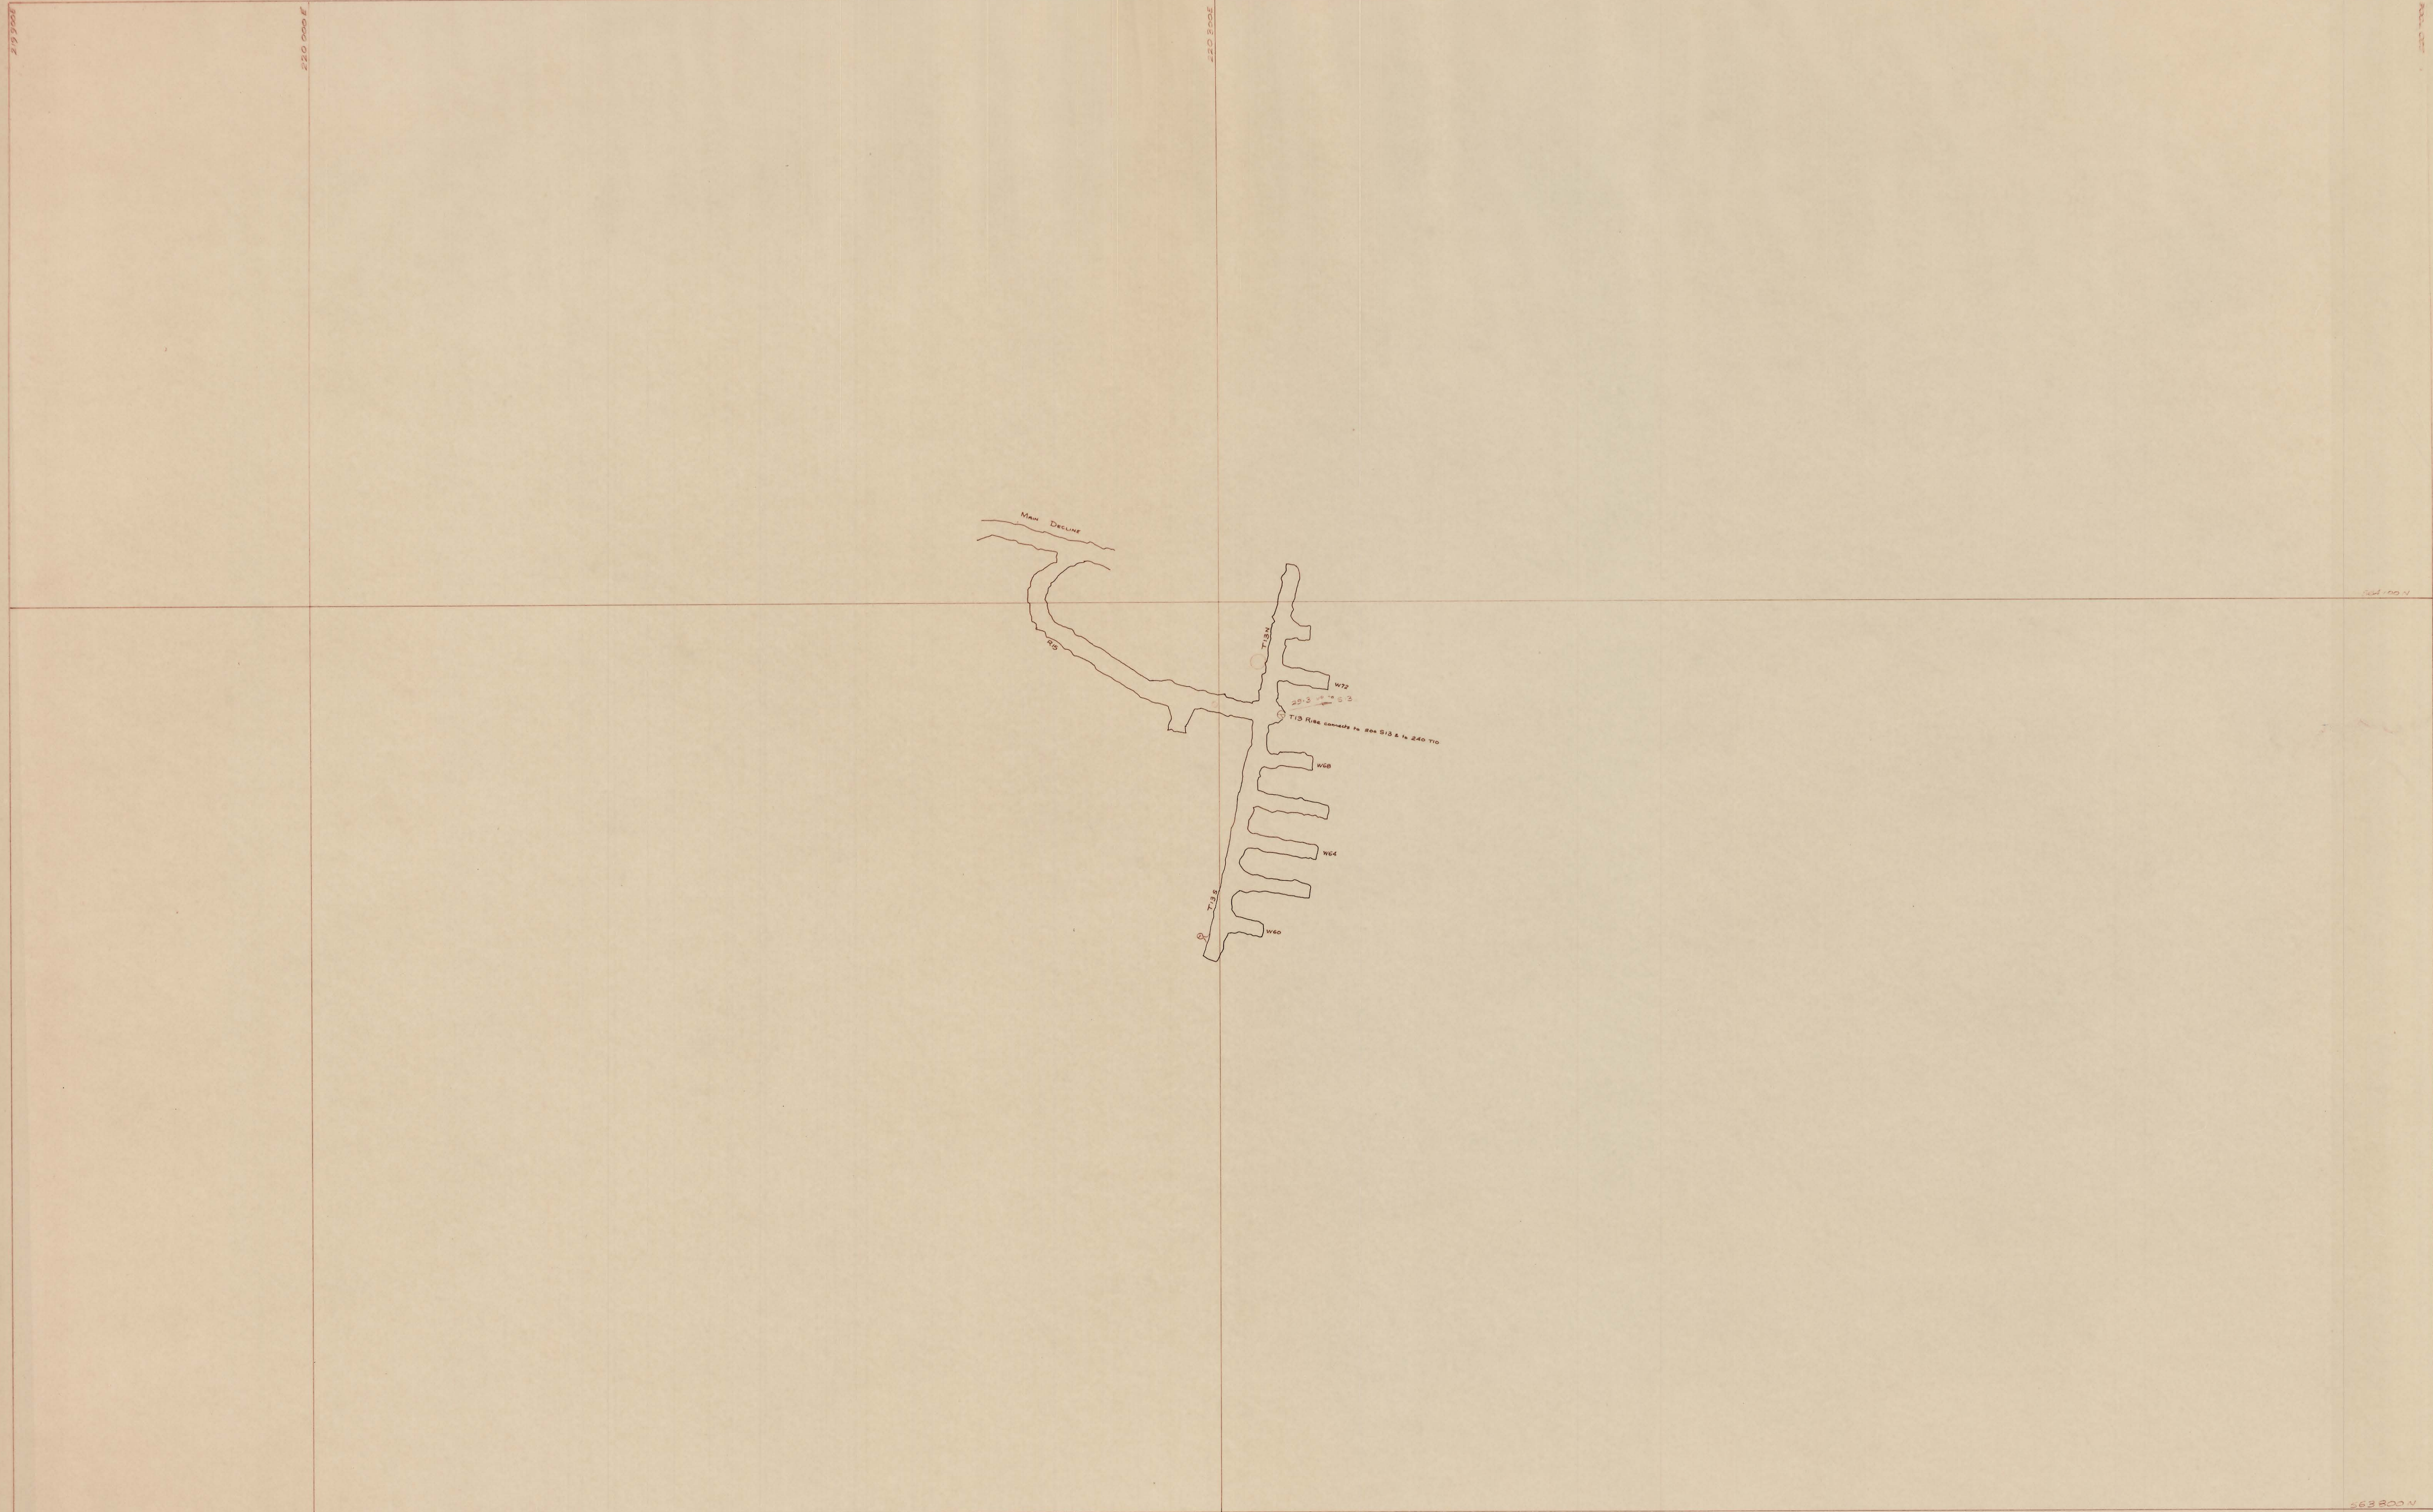

SCALE 1

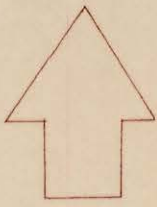

north

LOCATION

SUBJECT



GRASSY

KING ISLAND

PLAN NUMBER