


LINE 16
SCALE 1in = 50ft
FROM QC-70 AS OF 1.7.70

5 cm

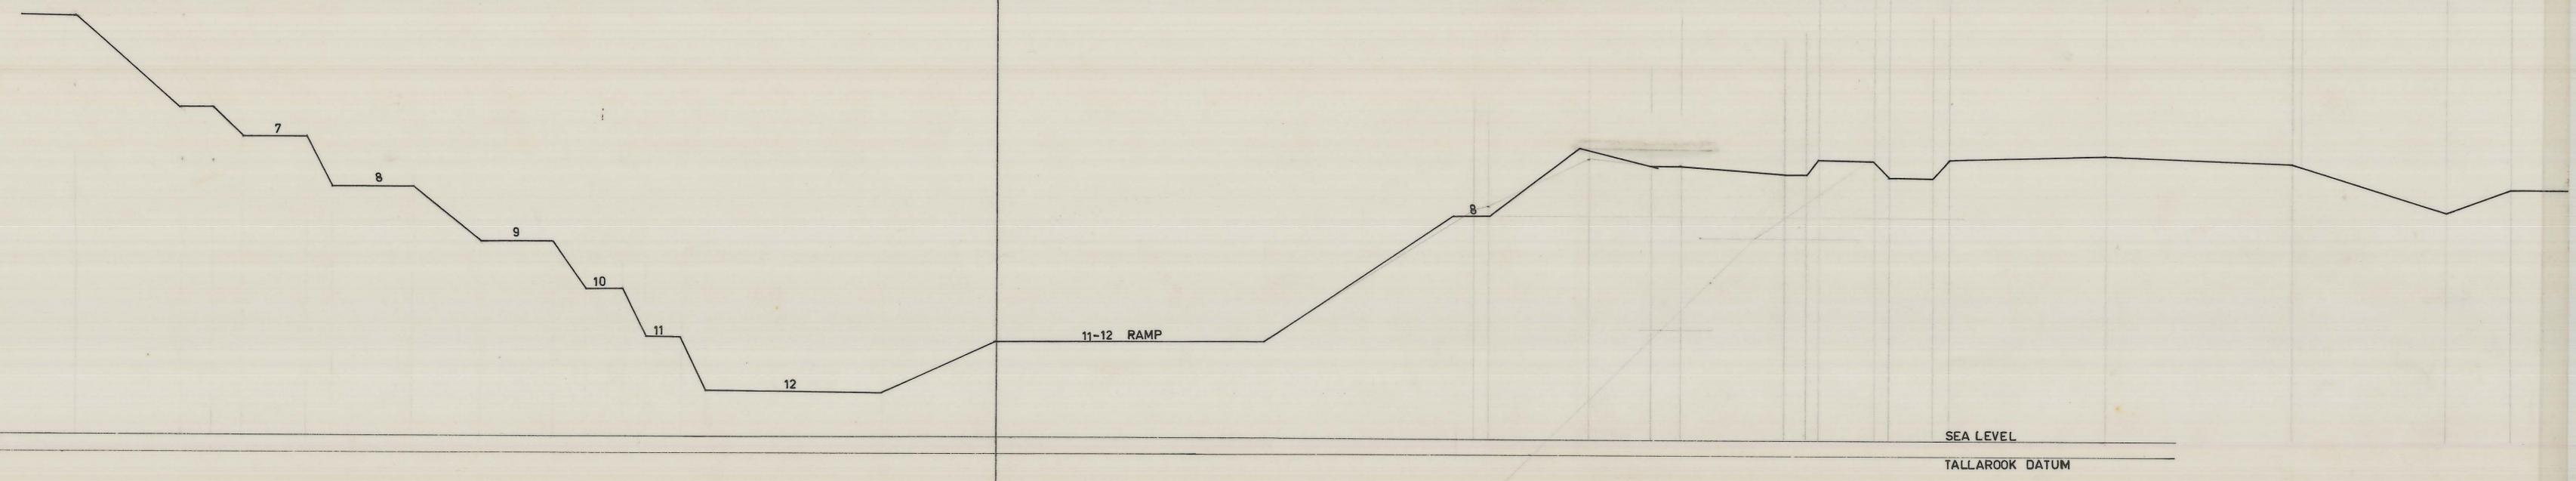

100 000 N

1-13-23

0374_3627