


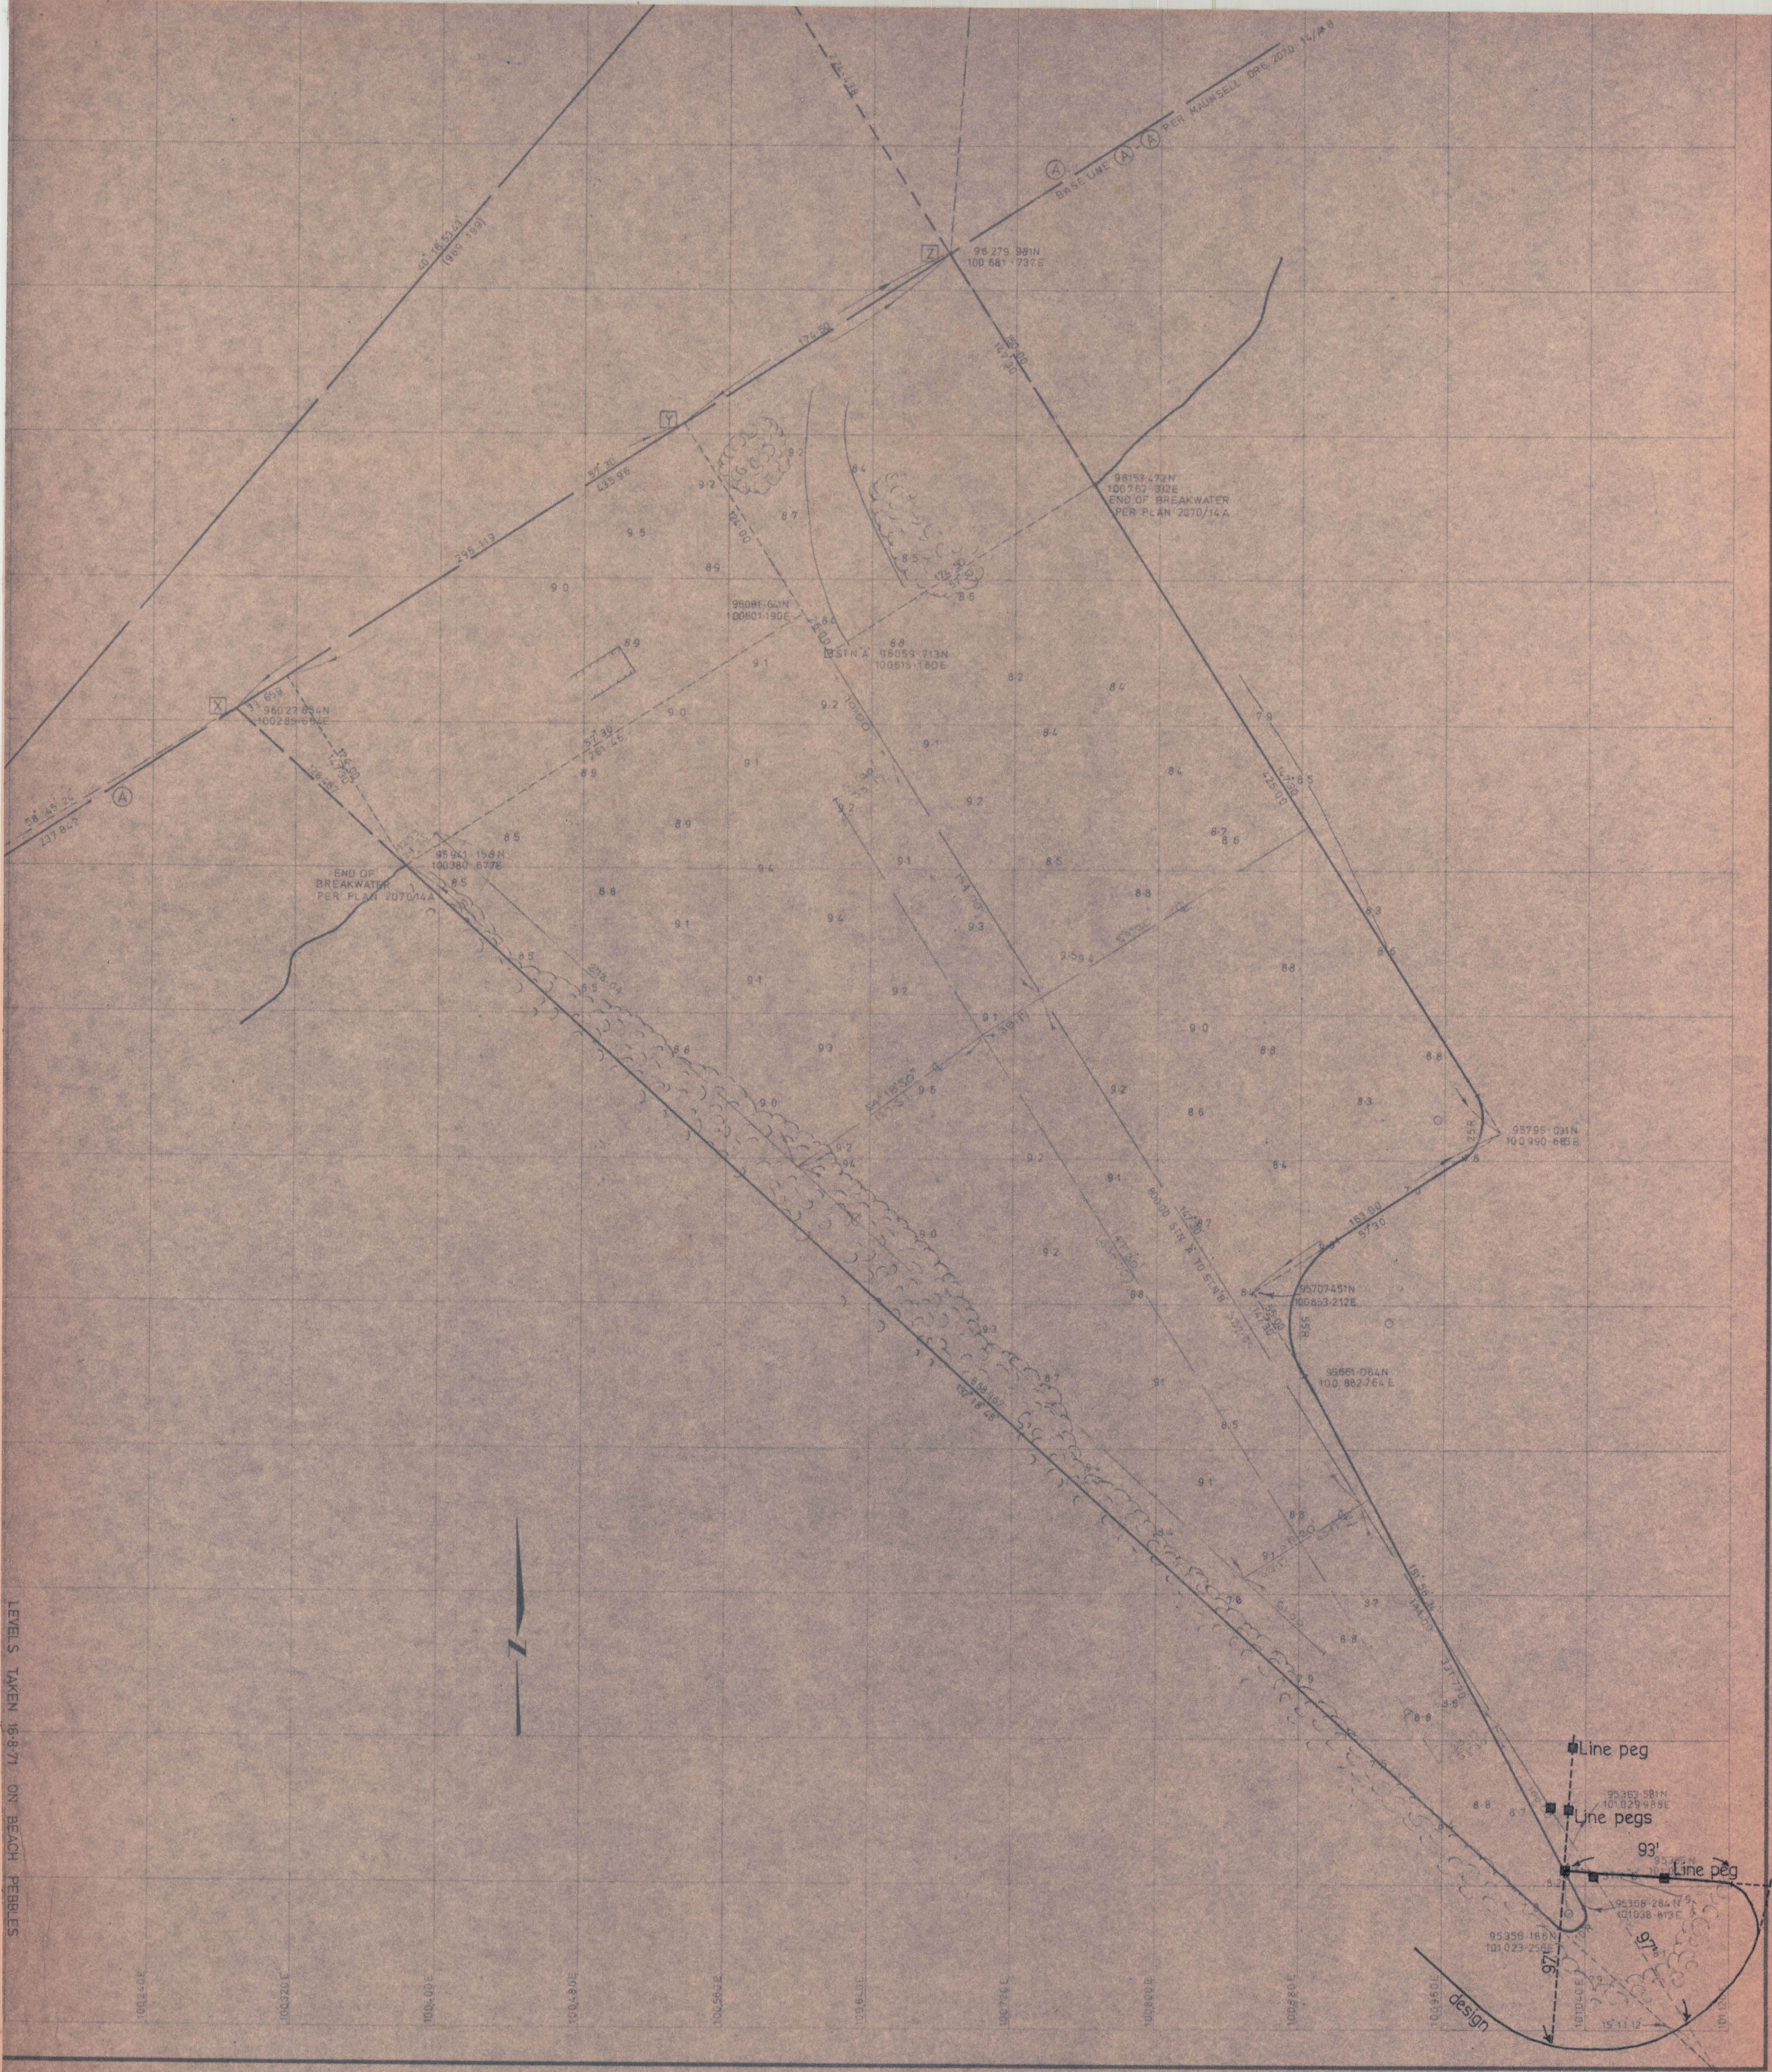

LEVELS TAKEN 10-8-71 ON BEACH PEBBLES