


5 cm

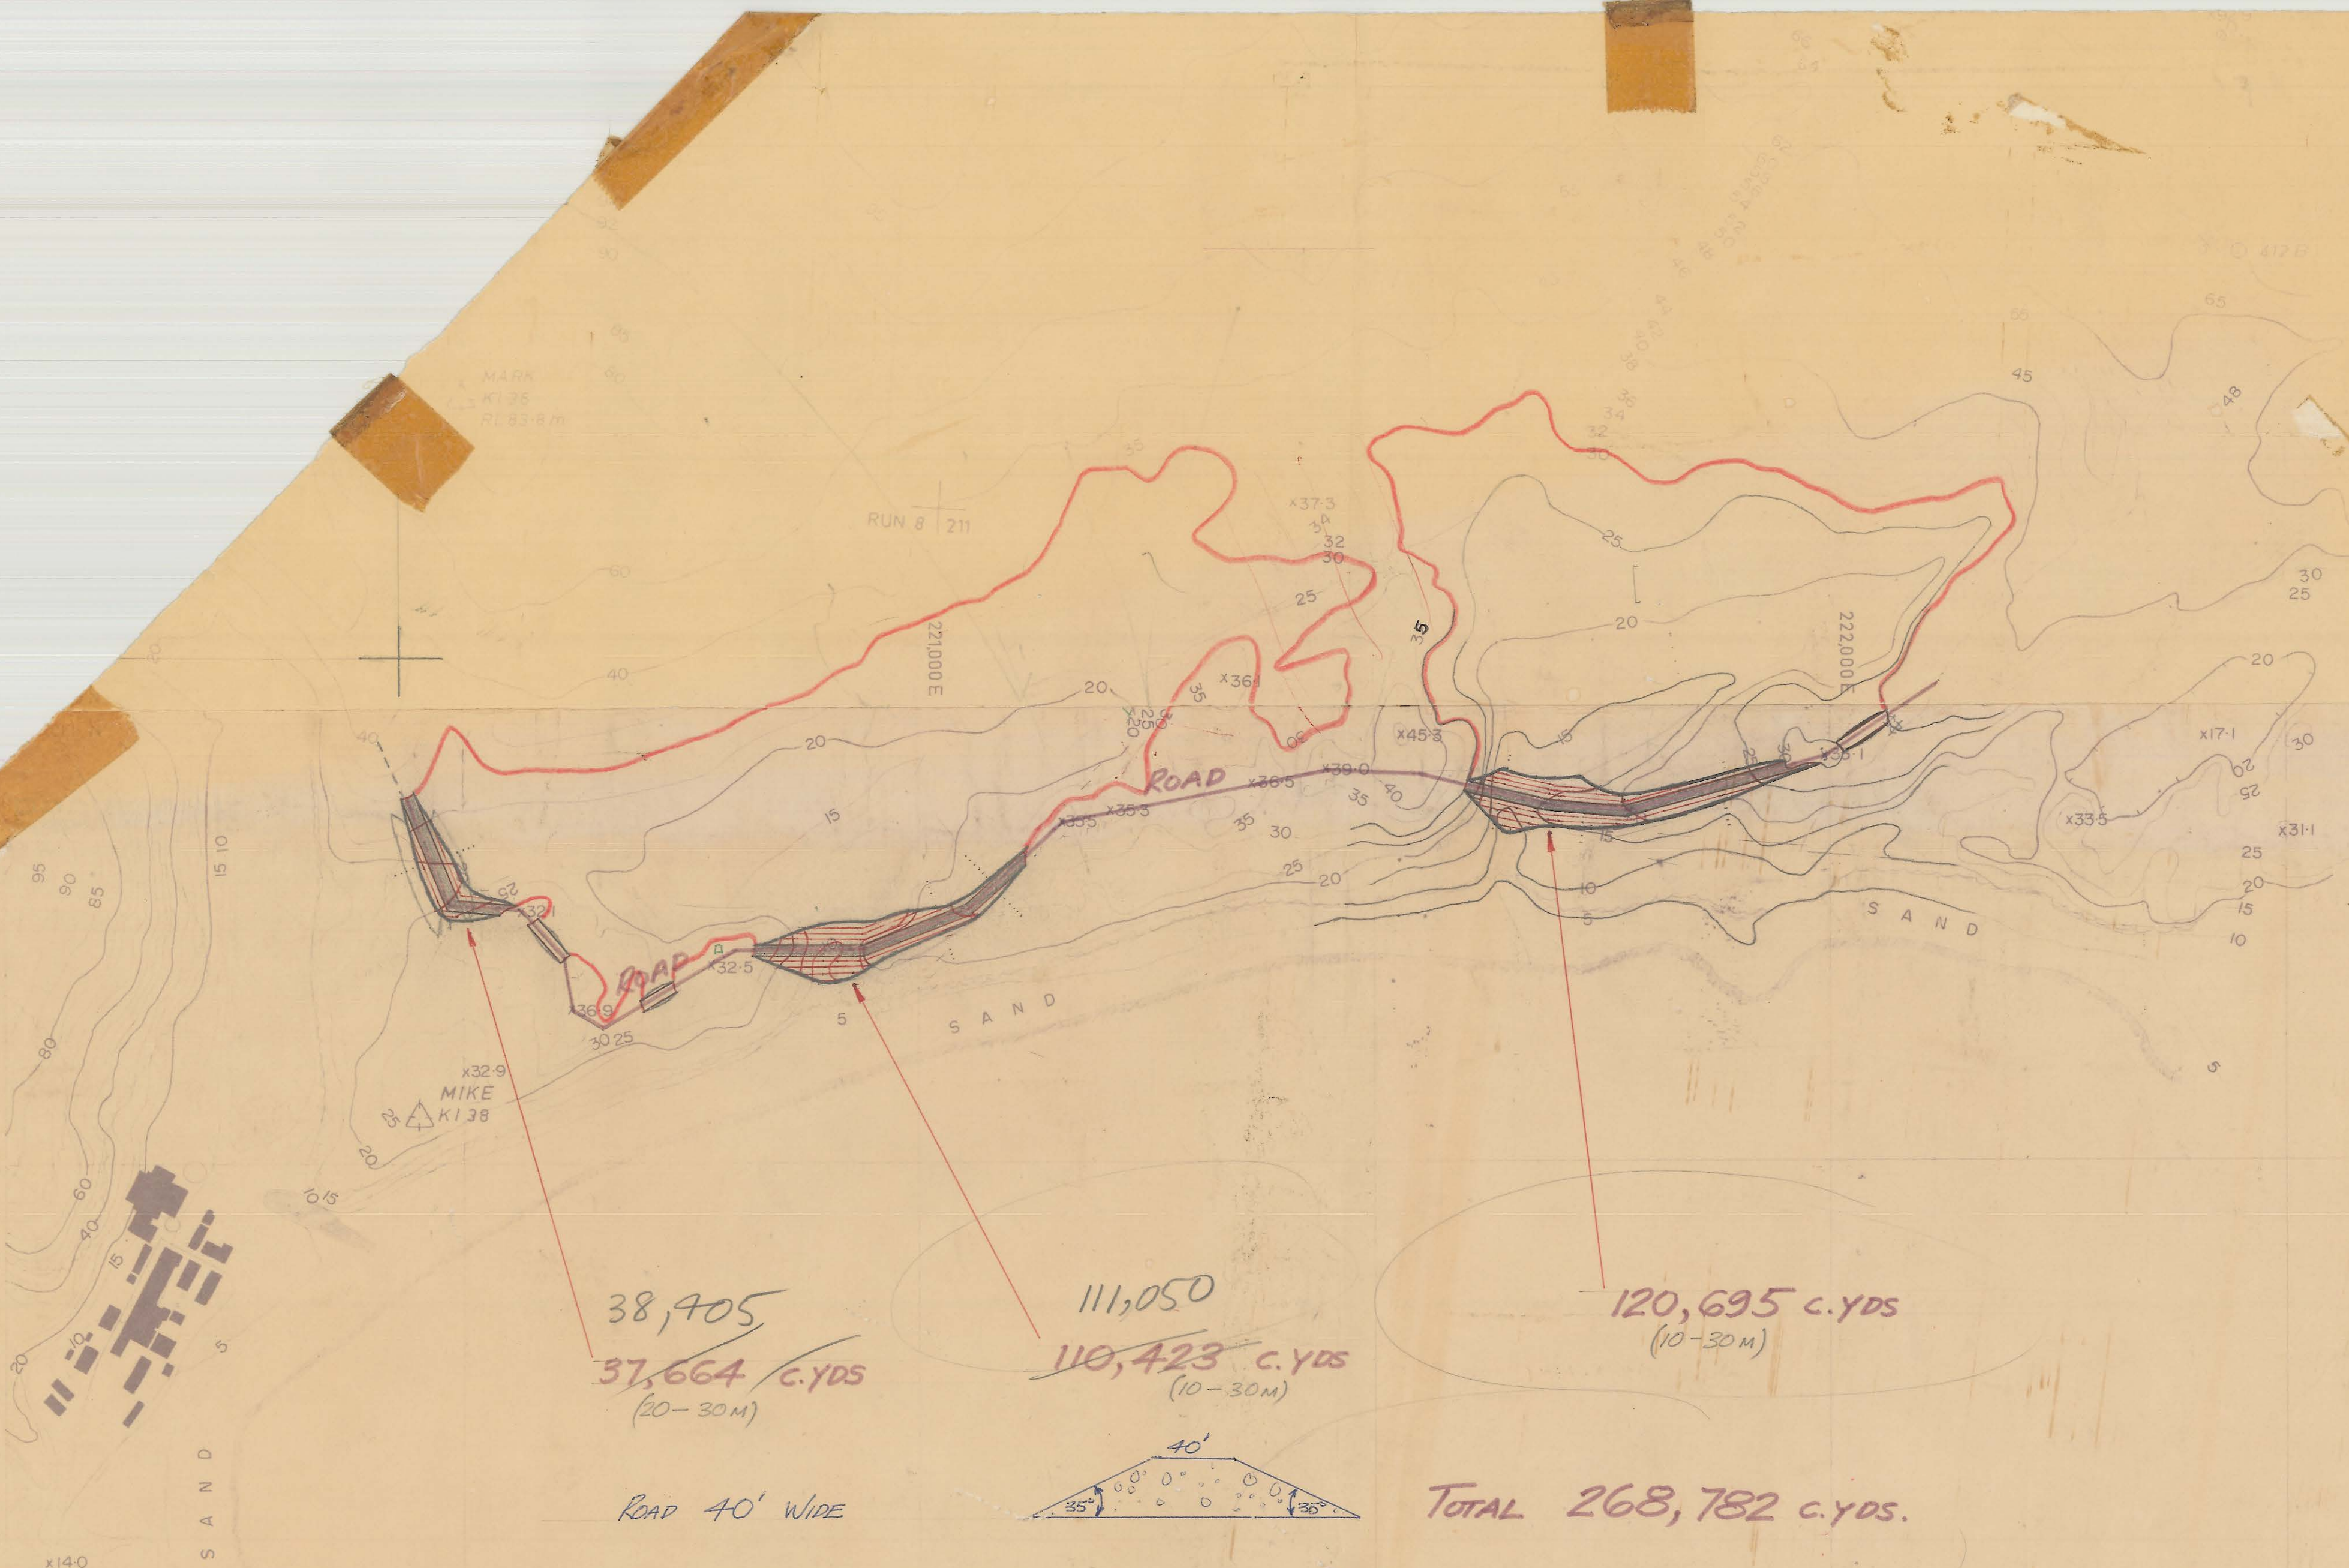

K.I.S. DRAWING No.	
102	
SCALE	DATE OF RECEIPT

Failing down
DEC 1970

1-10-5

0374_3640