5 cm

0374_3672

WHARF PARAPET

Scale : 20 ft to an inch

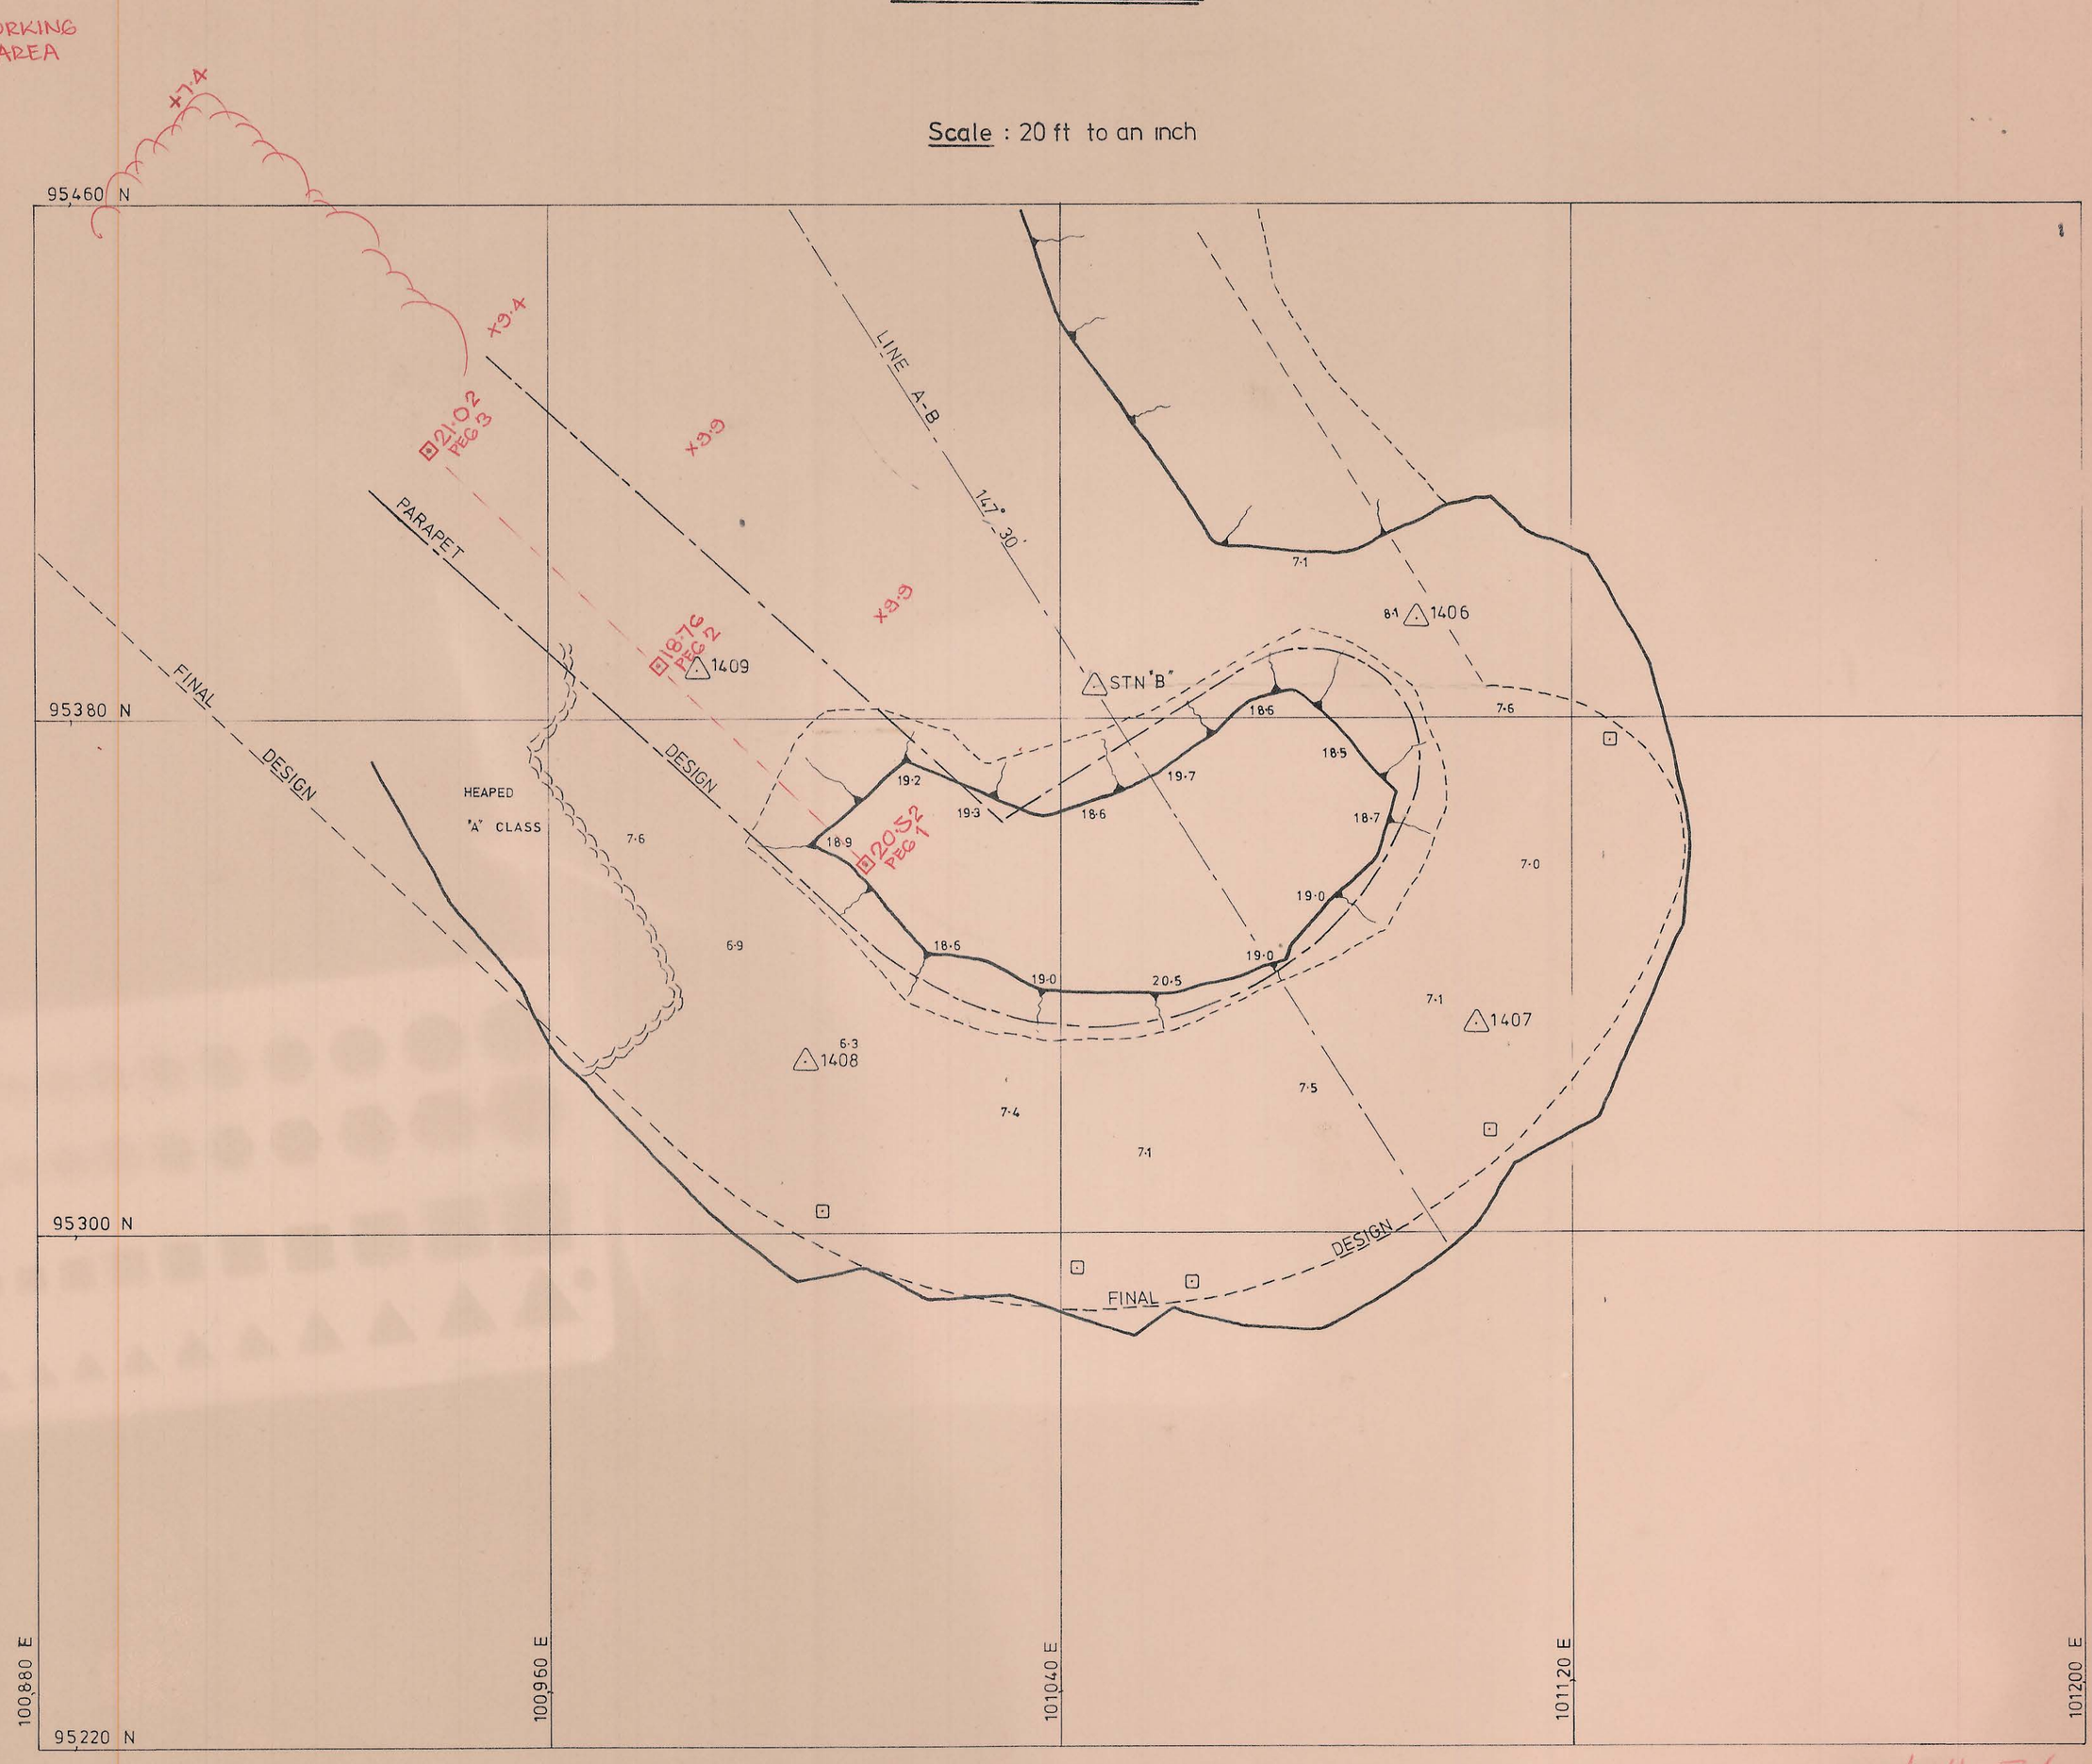

F-11-31

8.2.72 AT PEGS 1,2 & 3 BONING RODS PLACED AT R.L. 23.0

ADDITIONS IN RED 7.2.72

SURVEYED : 24-1-72

P.D.M.