
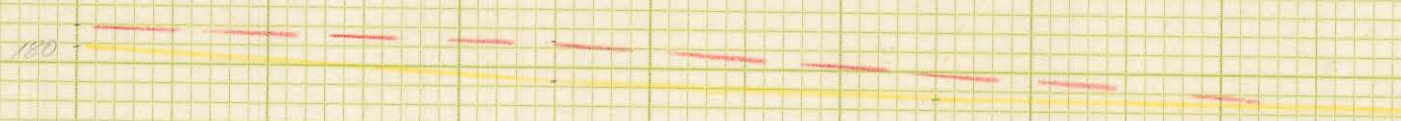
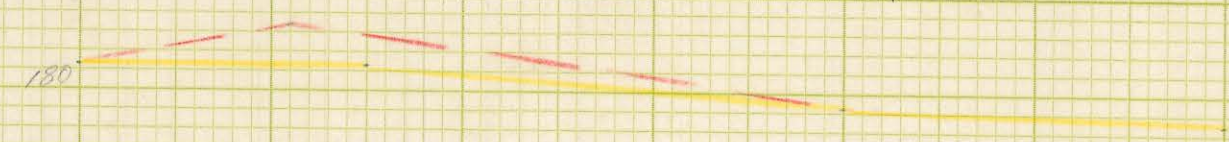
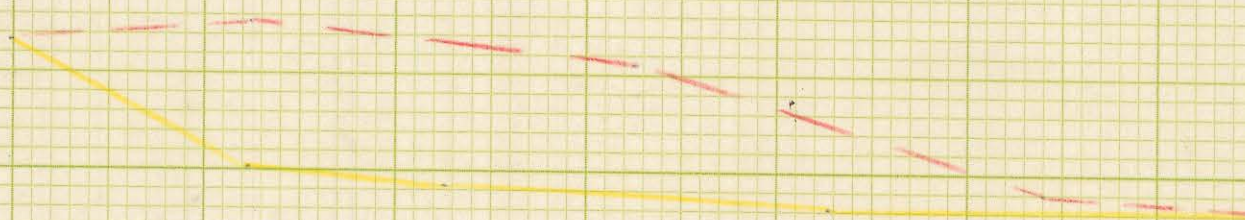
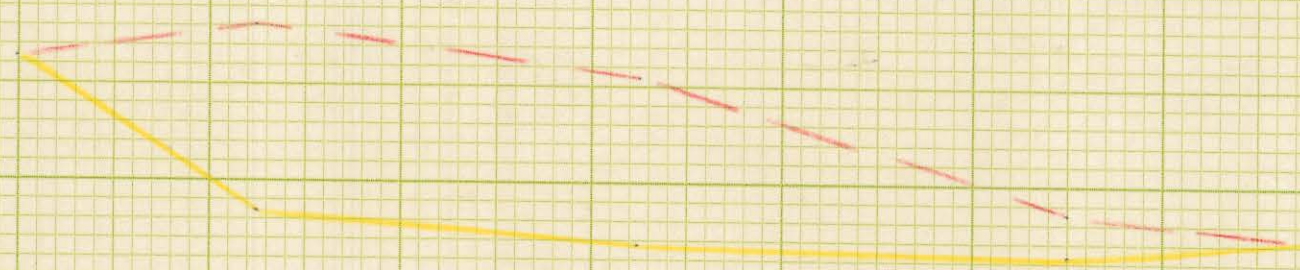
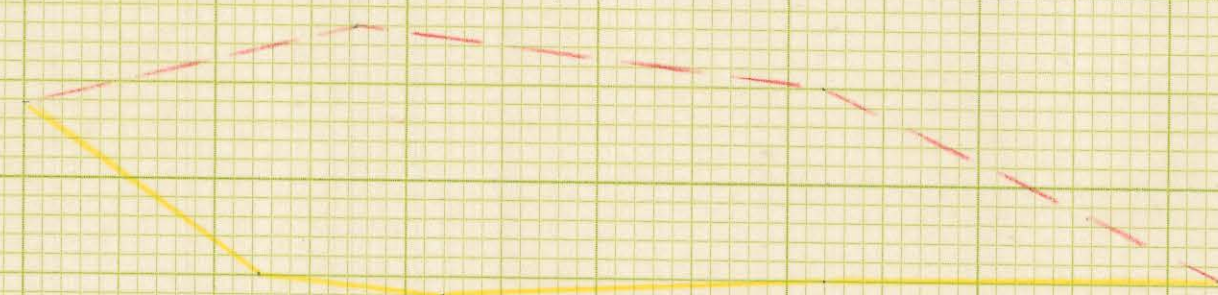
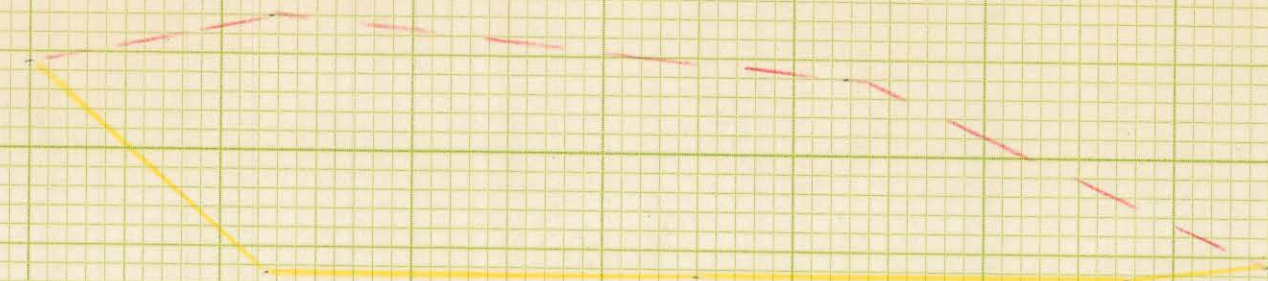
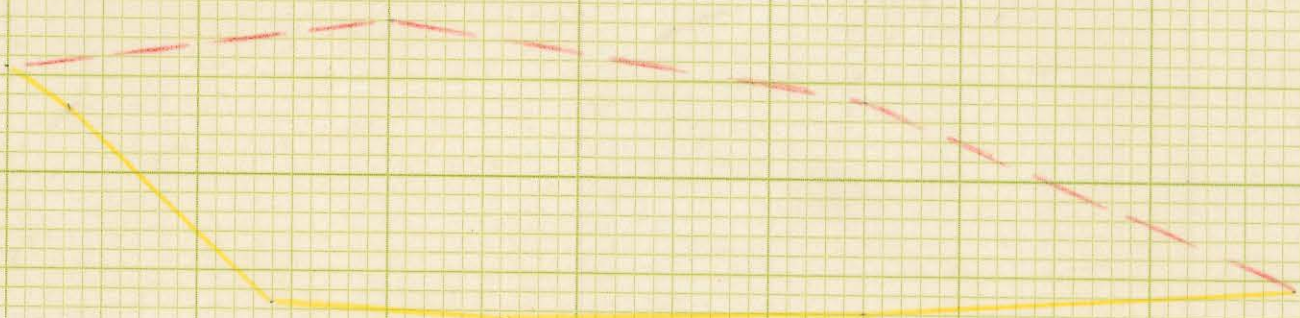
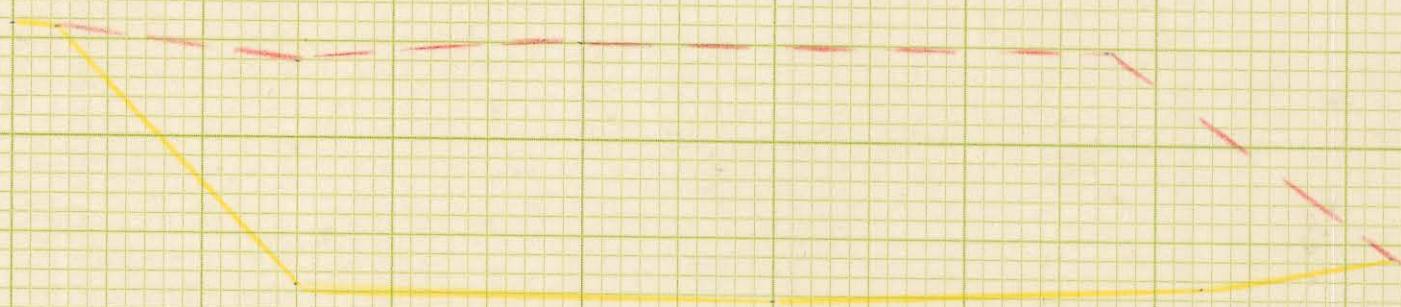
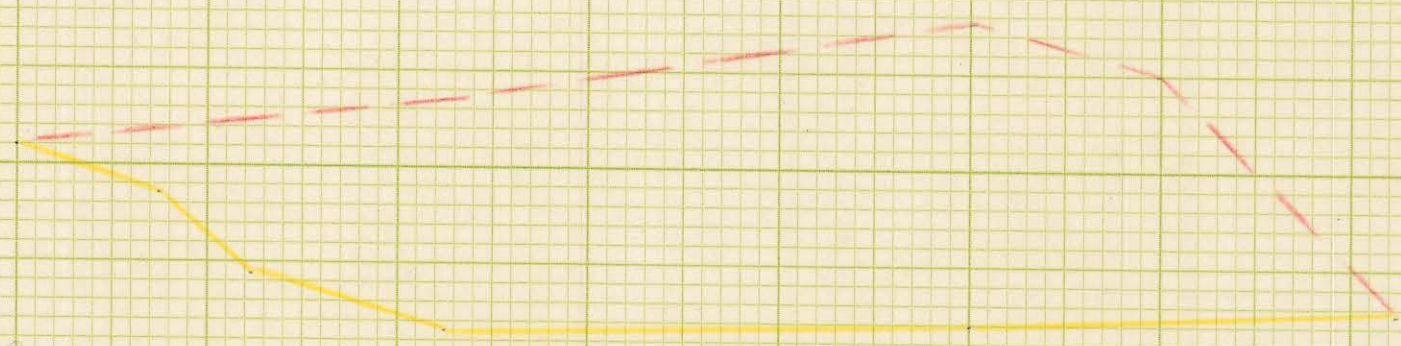
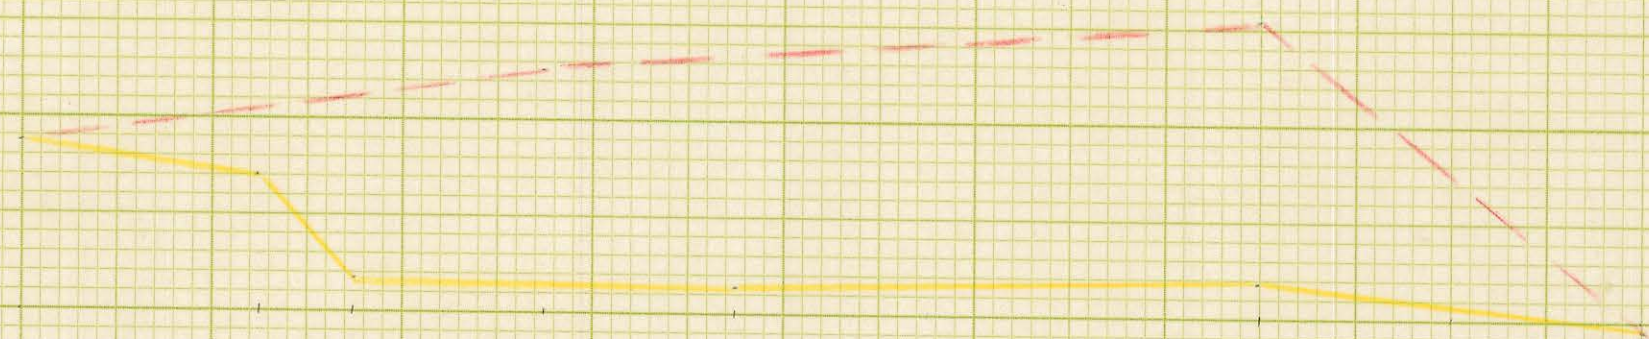
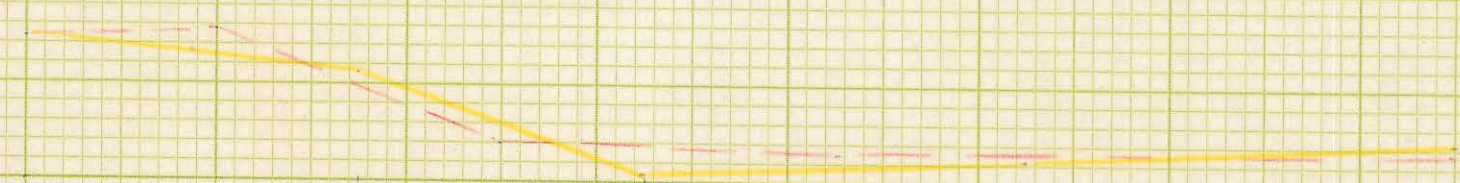


CROSS SECTIONS OF NO. 1 AREA SAND DUMP

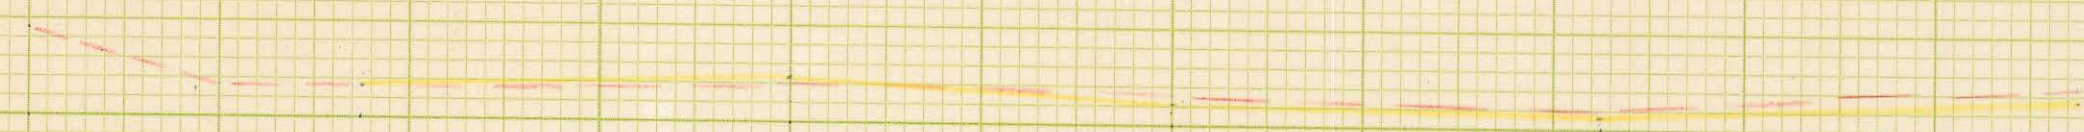

LEGEND --- Original level
 --- Level of 23-9-70

SCALE 1" = 20'

5 cm