5 cm

0374_3684 a

FOLD

HEWLETT-PACKARD
9280-0180
FOR USE ON HEWLETT-PACKARD RECORDERS

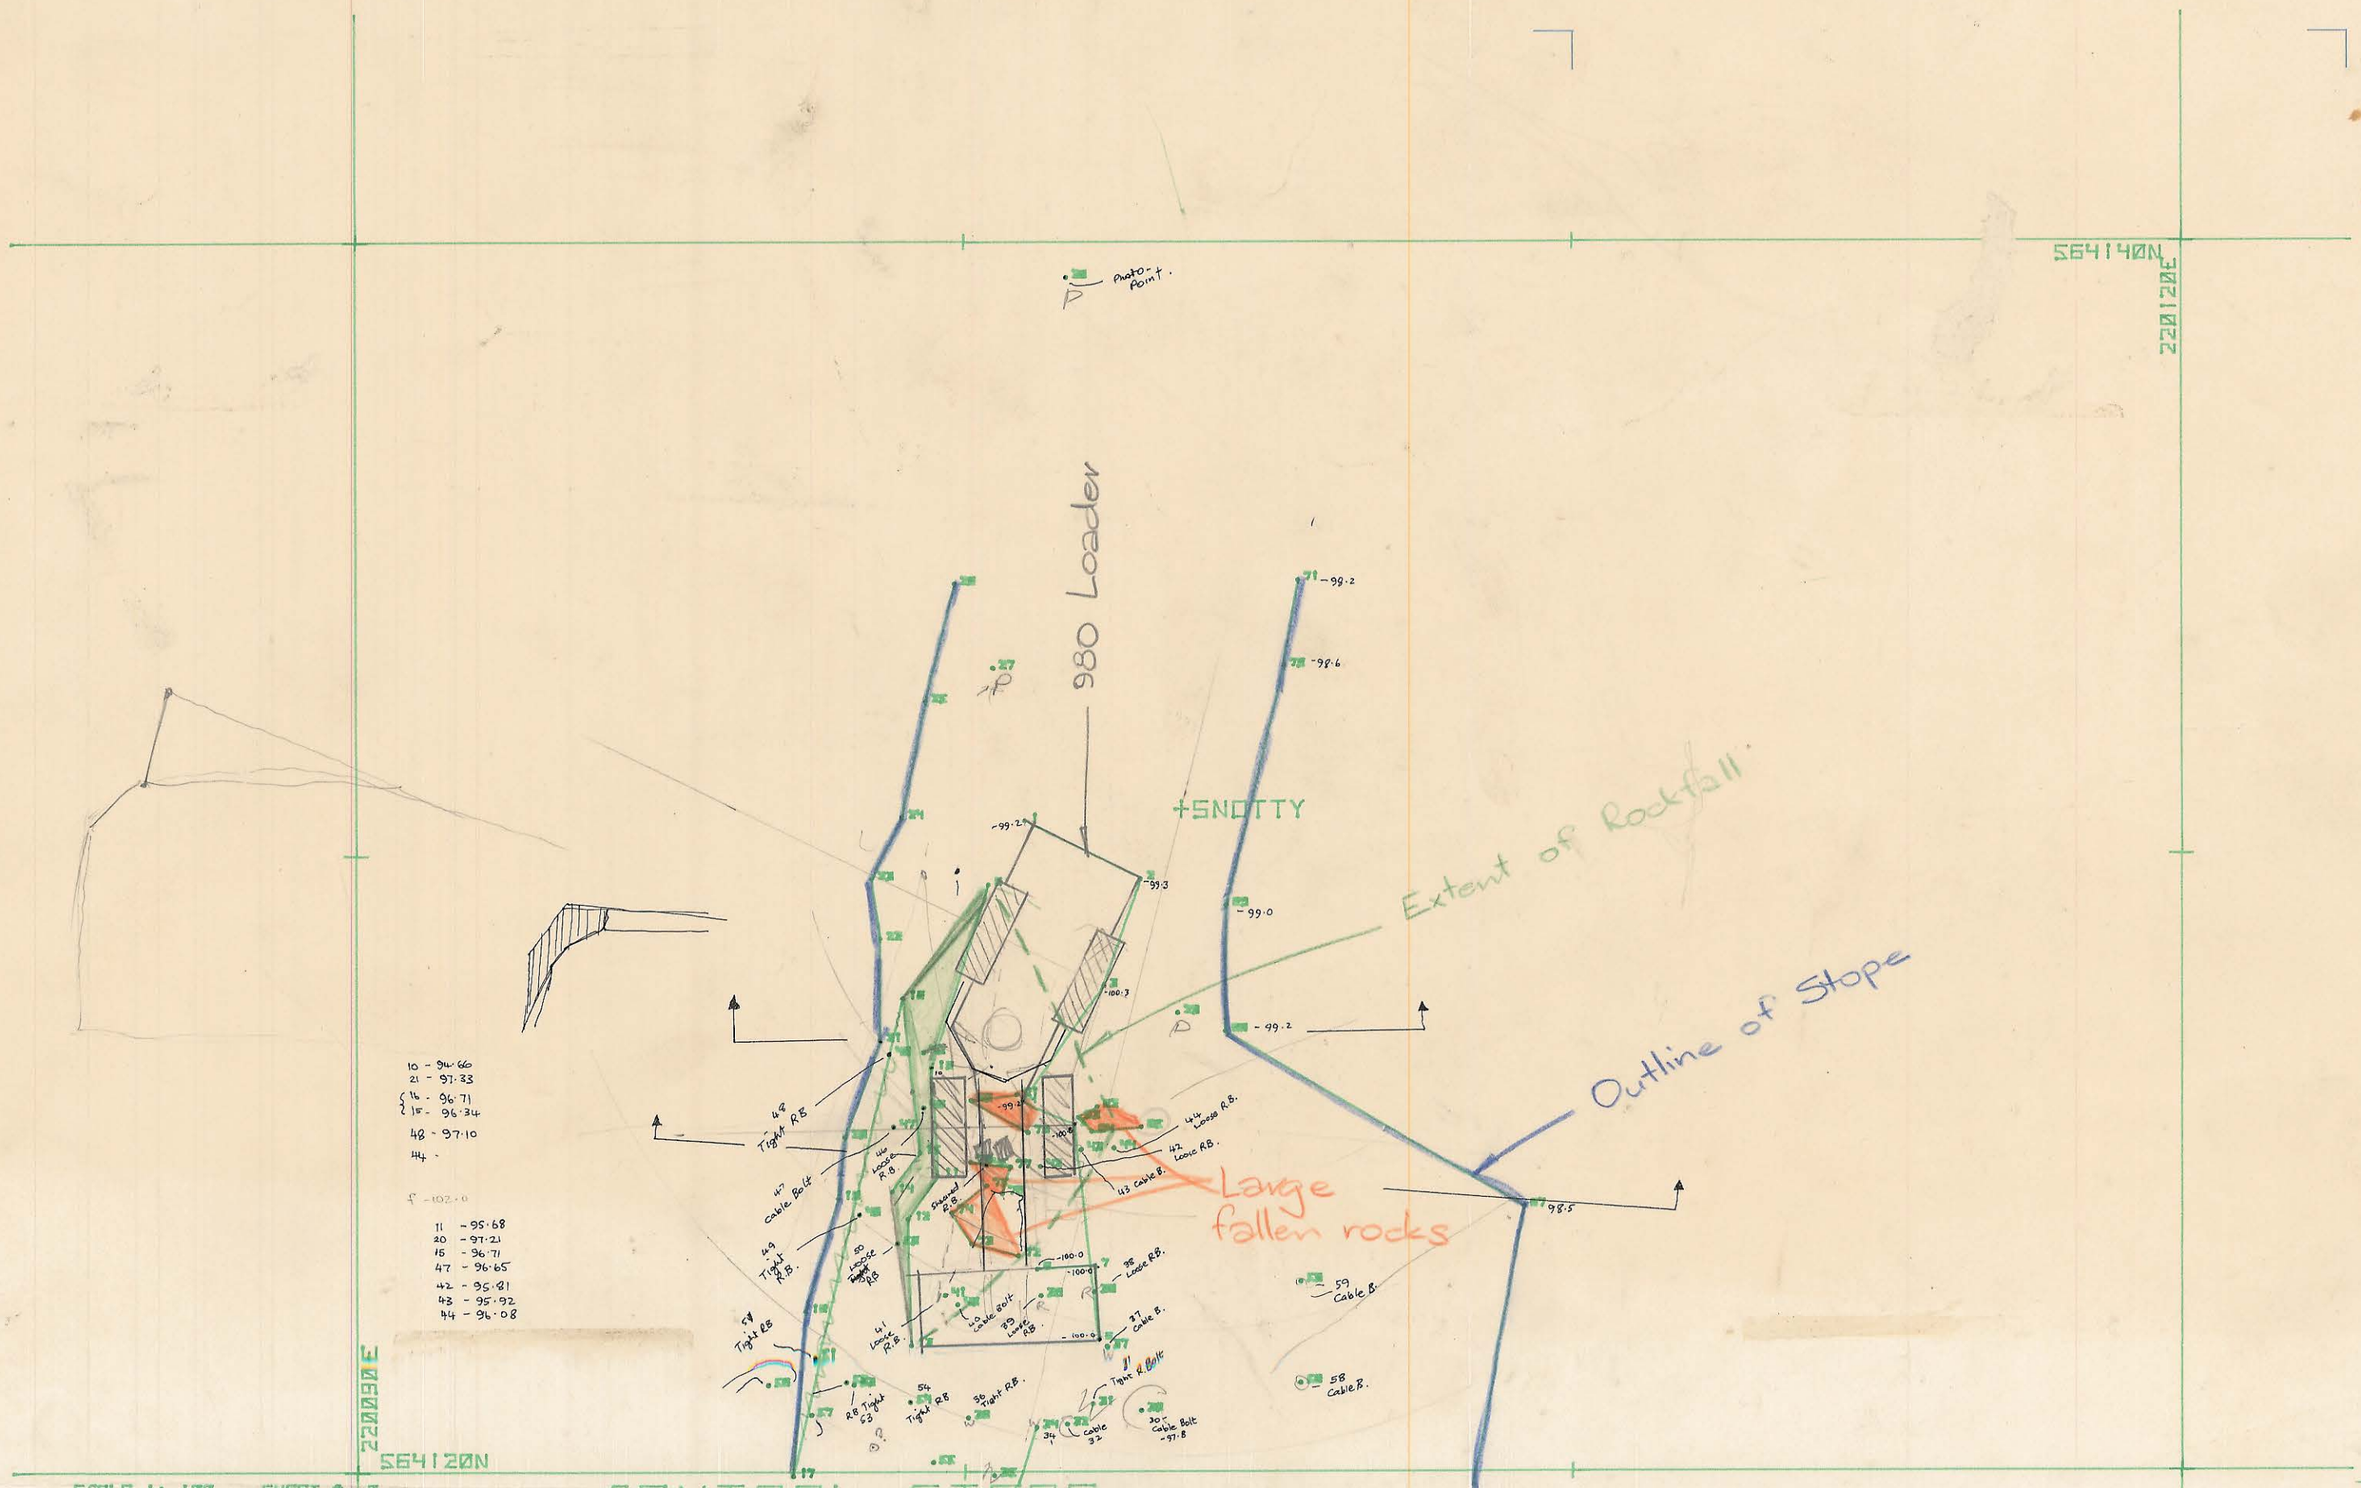

FOLD