


FOLD

HEWLETT-PACKARD
9280-0180
FOR USE ON HEWLETT-PACKARD RECORDERS

2201022
564130N

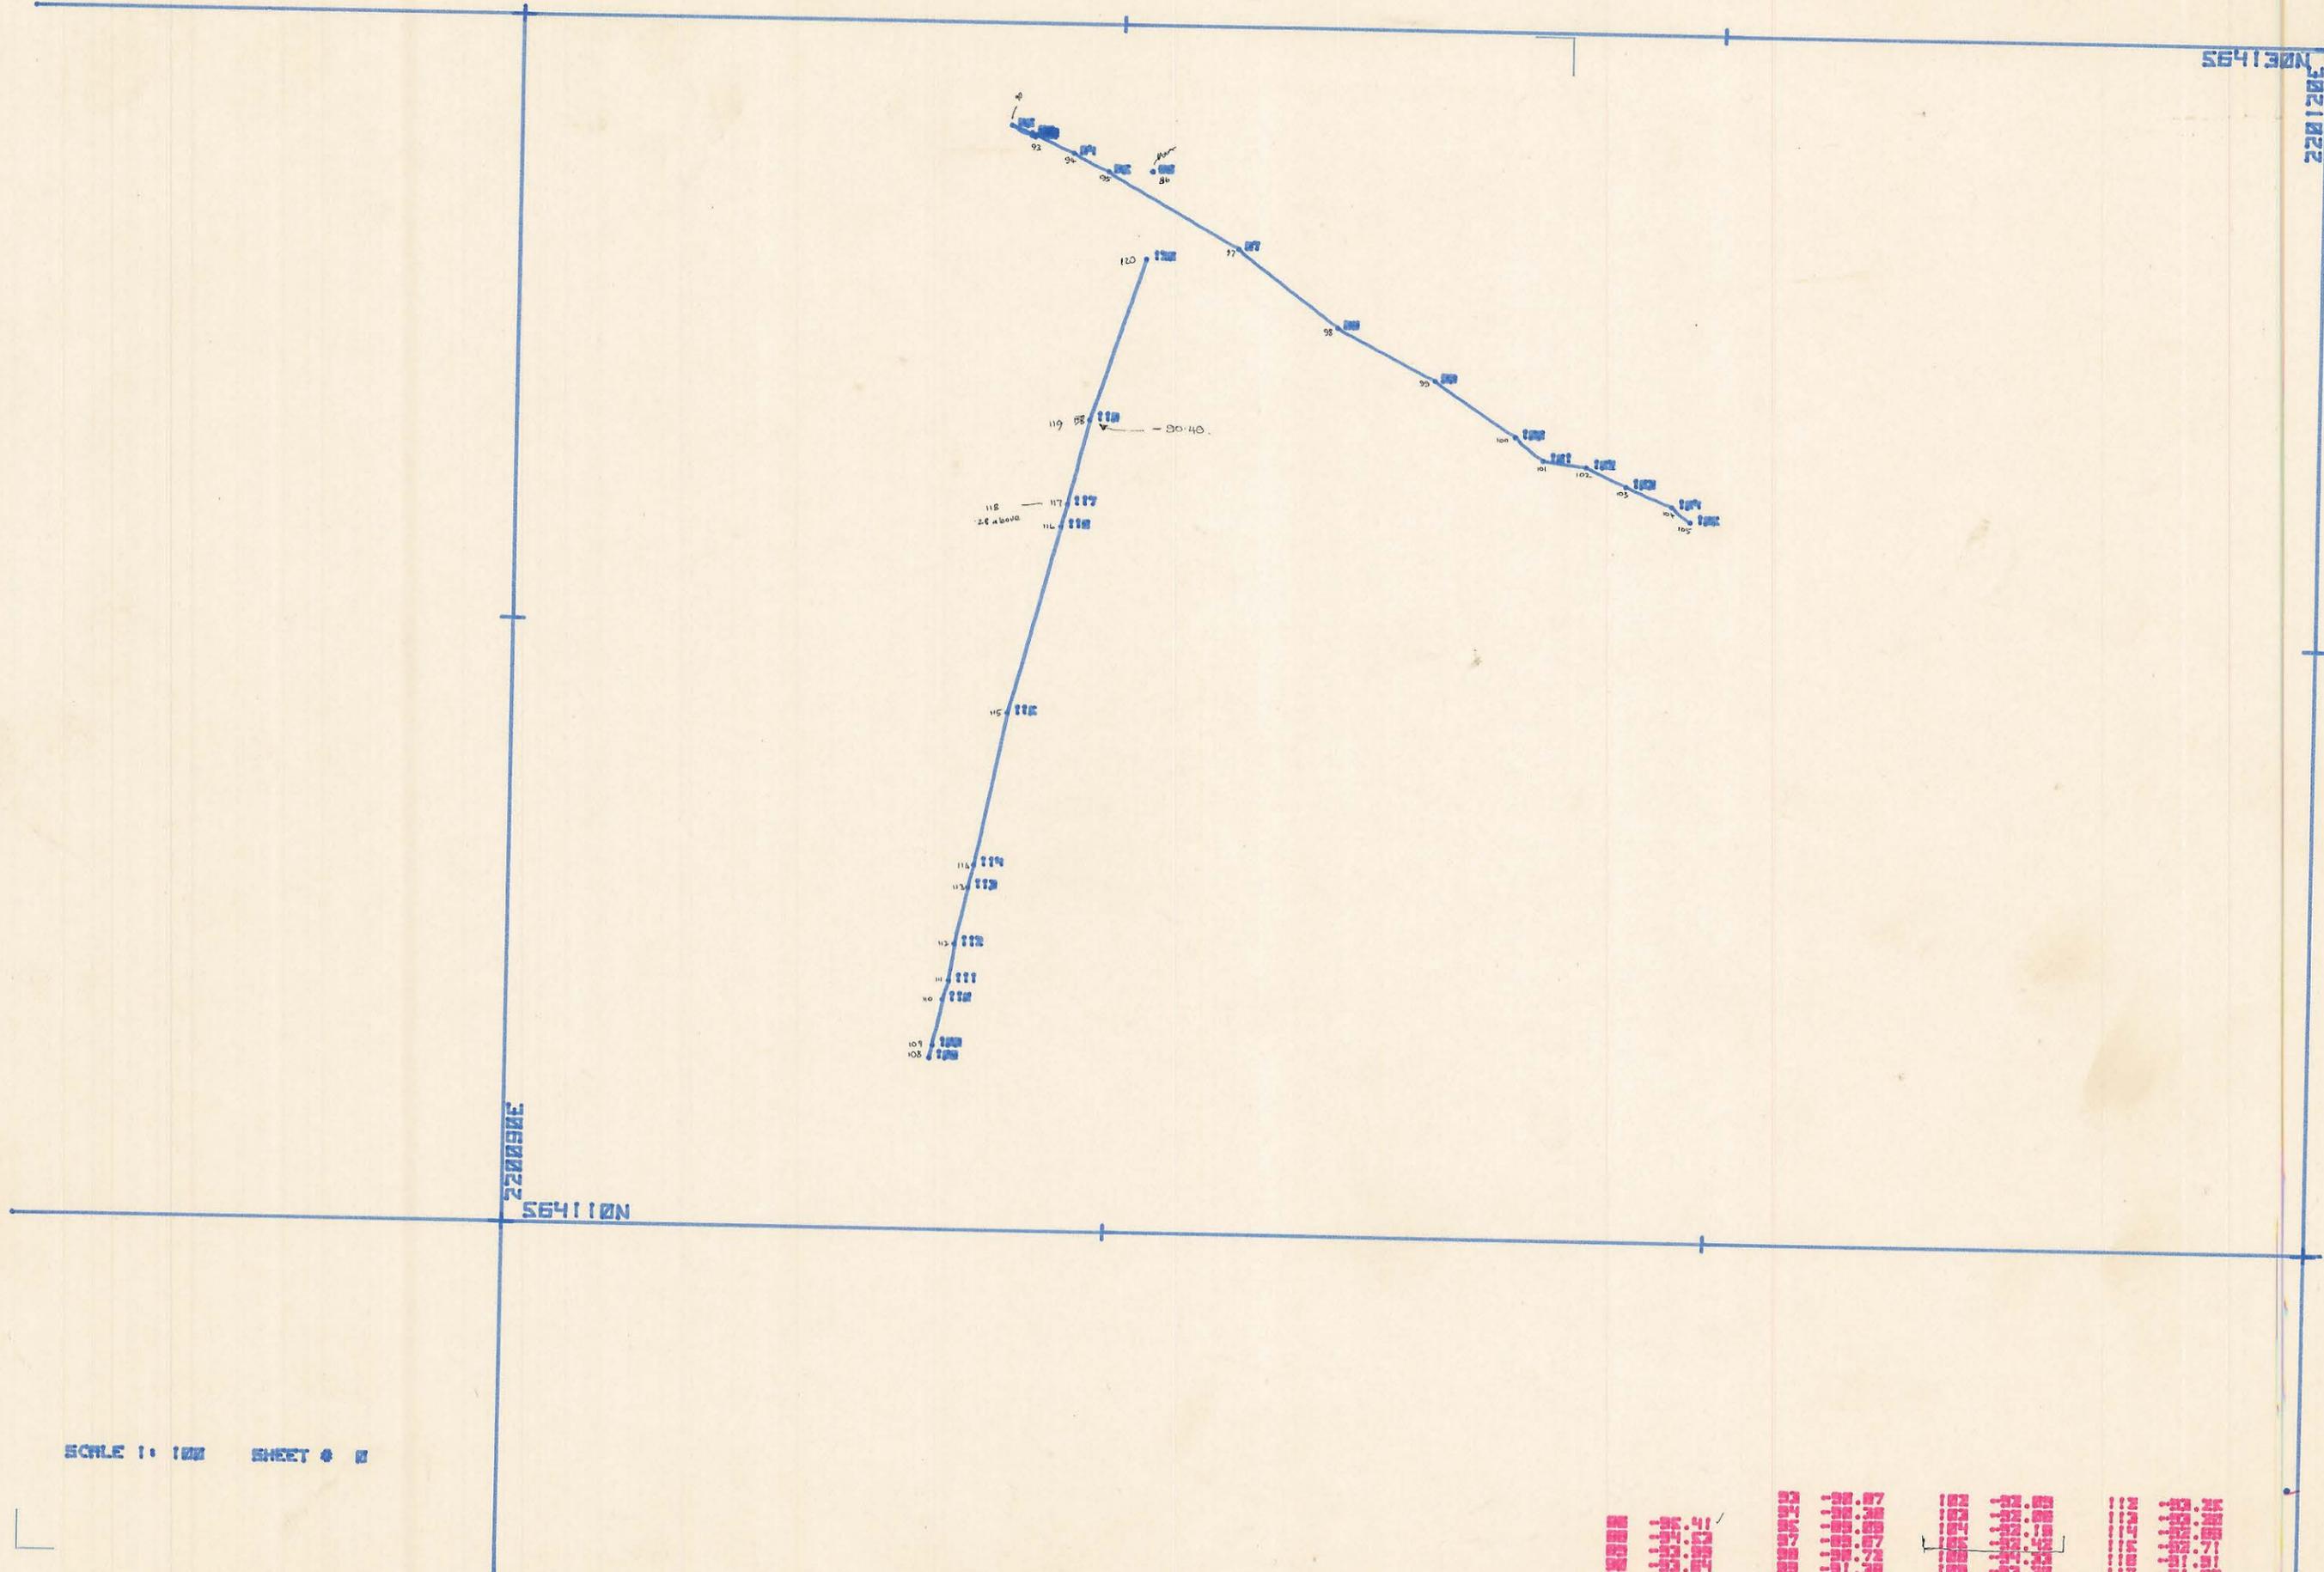


FOLD

