5 cm

0374_3690

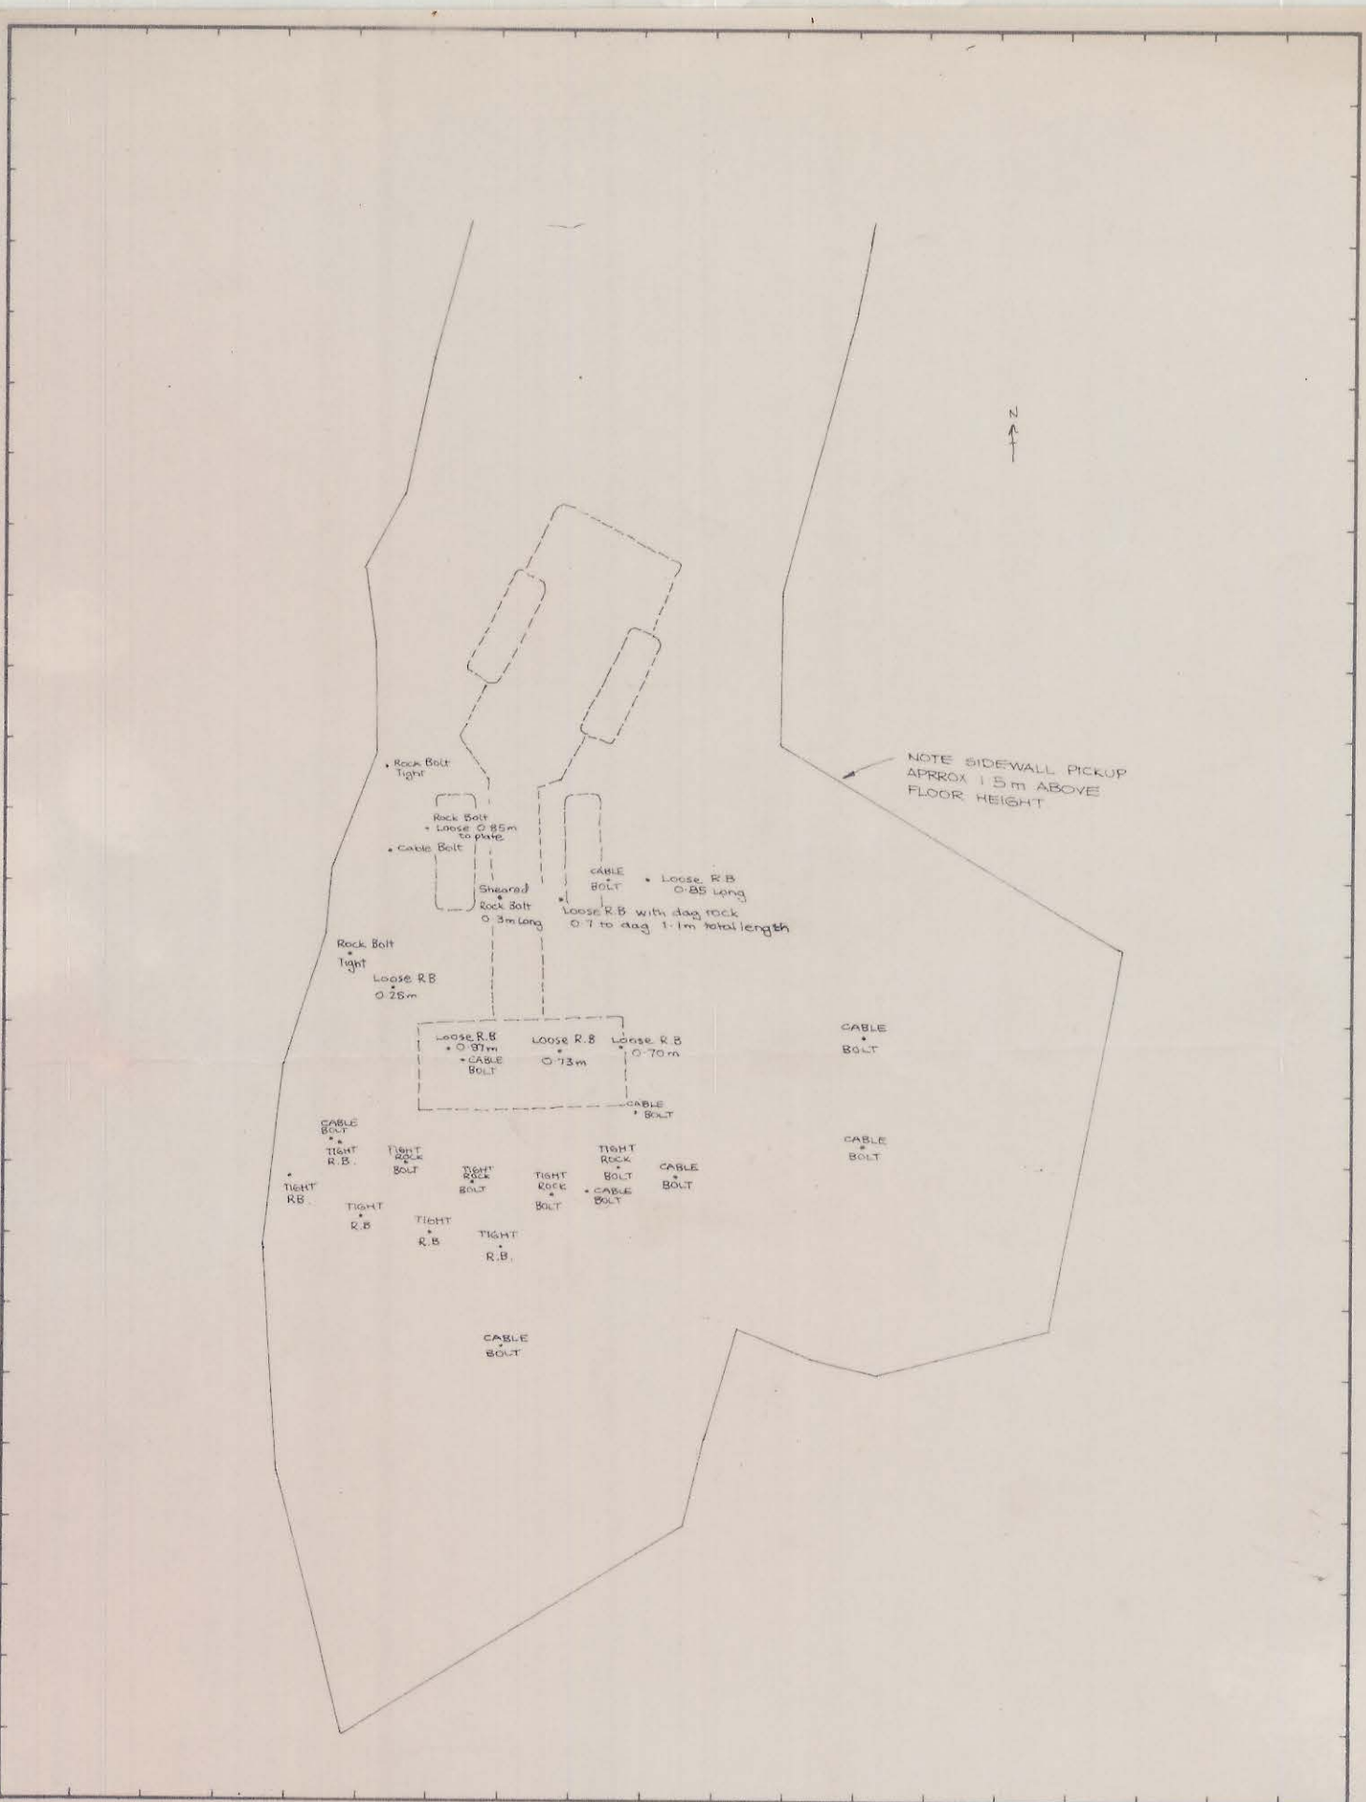

REF. PLAN	GEOLOGY			1 : 100 SCALE	KIS KING ISLAND SCHEELITE GRASSY KING ISLAND
	SURVEY			PLAN OF ROOF SUPPORT AROUND ACCIDENT SITE	
	PLANNING				
	ROCK MEC.				
	GRADE CON.				
	DRAFTING			DRAWING NUMBER	
	T.S.S.				