To be completed when additional sheets are annexed:
Detailed drawings of the parcels shown in the above plan are contained in the additional sheet/s annexed hereto and signed by us.

Surveyor .....

Council Clerk .....

To be filled in by Surveyor	
Survey Commenced	13th February 1968
Survey Finished	14th February 1968
Error of Close	(see below.)

Office Examination	
Plot Checked	
Mathematically Checked	
Examined as to Boundaries	
Entered on Card	

Surveyor's Declaration

I, Johnstone Heyworth of Surrey Hills, in Victoria, registered surveyor, hereby certify that this plan;

1 Has been made from surveys executed by me, under my personal supervision, inspection & field check, and that both plan & survey are correct & have been made in accordance with the Land Surveyors' Byelaws 1966

2 Complies with all statutory provisions relating to anything appearing thereon, and

3 Does not require the approval of the local authority

Dated the Third of March 1969

Registered Surveyor.

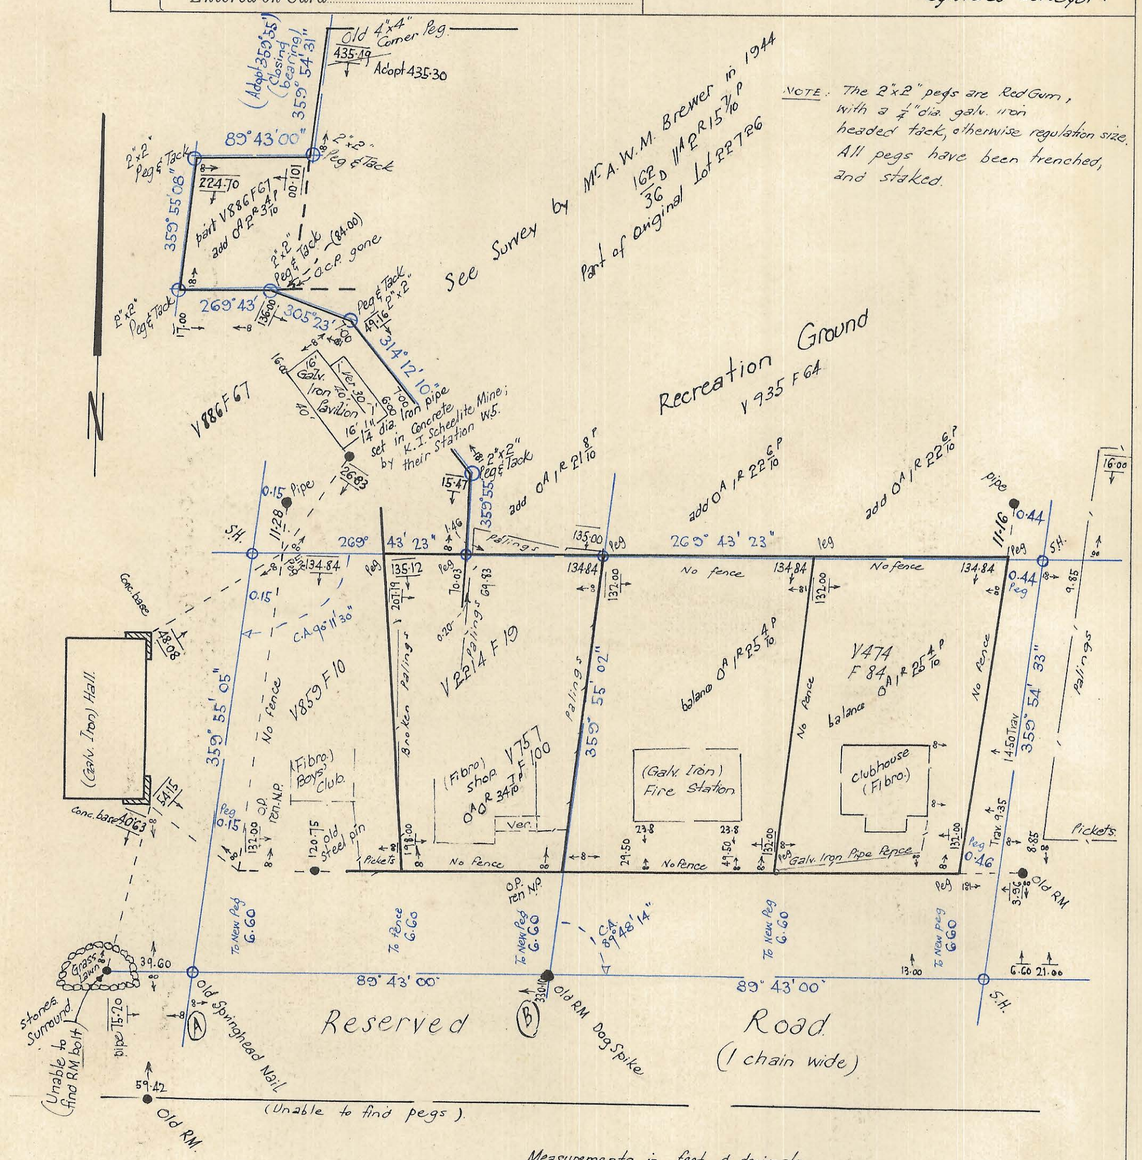

Field Notes of Survey

Owner Various

Title Reference .....

Areas of Parcels			
Lot Number	Area	Lot Number	Area
1	0A 1R 22 6/10		
2	0 1 22 6/10		
3	0 1 21 8/10		
4	0 2 3 4/10		
Total		Total	

PLAN OF SURVEY

of land situated in the

KING ISLAND

PARISH OF KITTAWA

Grantee: Part of Lot 22726, 483A 2R 12P to Perpetual Trustees

Scale 80 FEET to an inch

For Office Use

Registered Number

Filed by:

on ..... at .....

Receipt No. .....

Receiving Clerk .....

Effective from .....

Recorder of Titles / Registrar of Deeds

NO INFORMATION TO BE WRITTEN WITHIN THIS SPACE

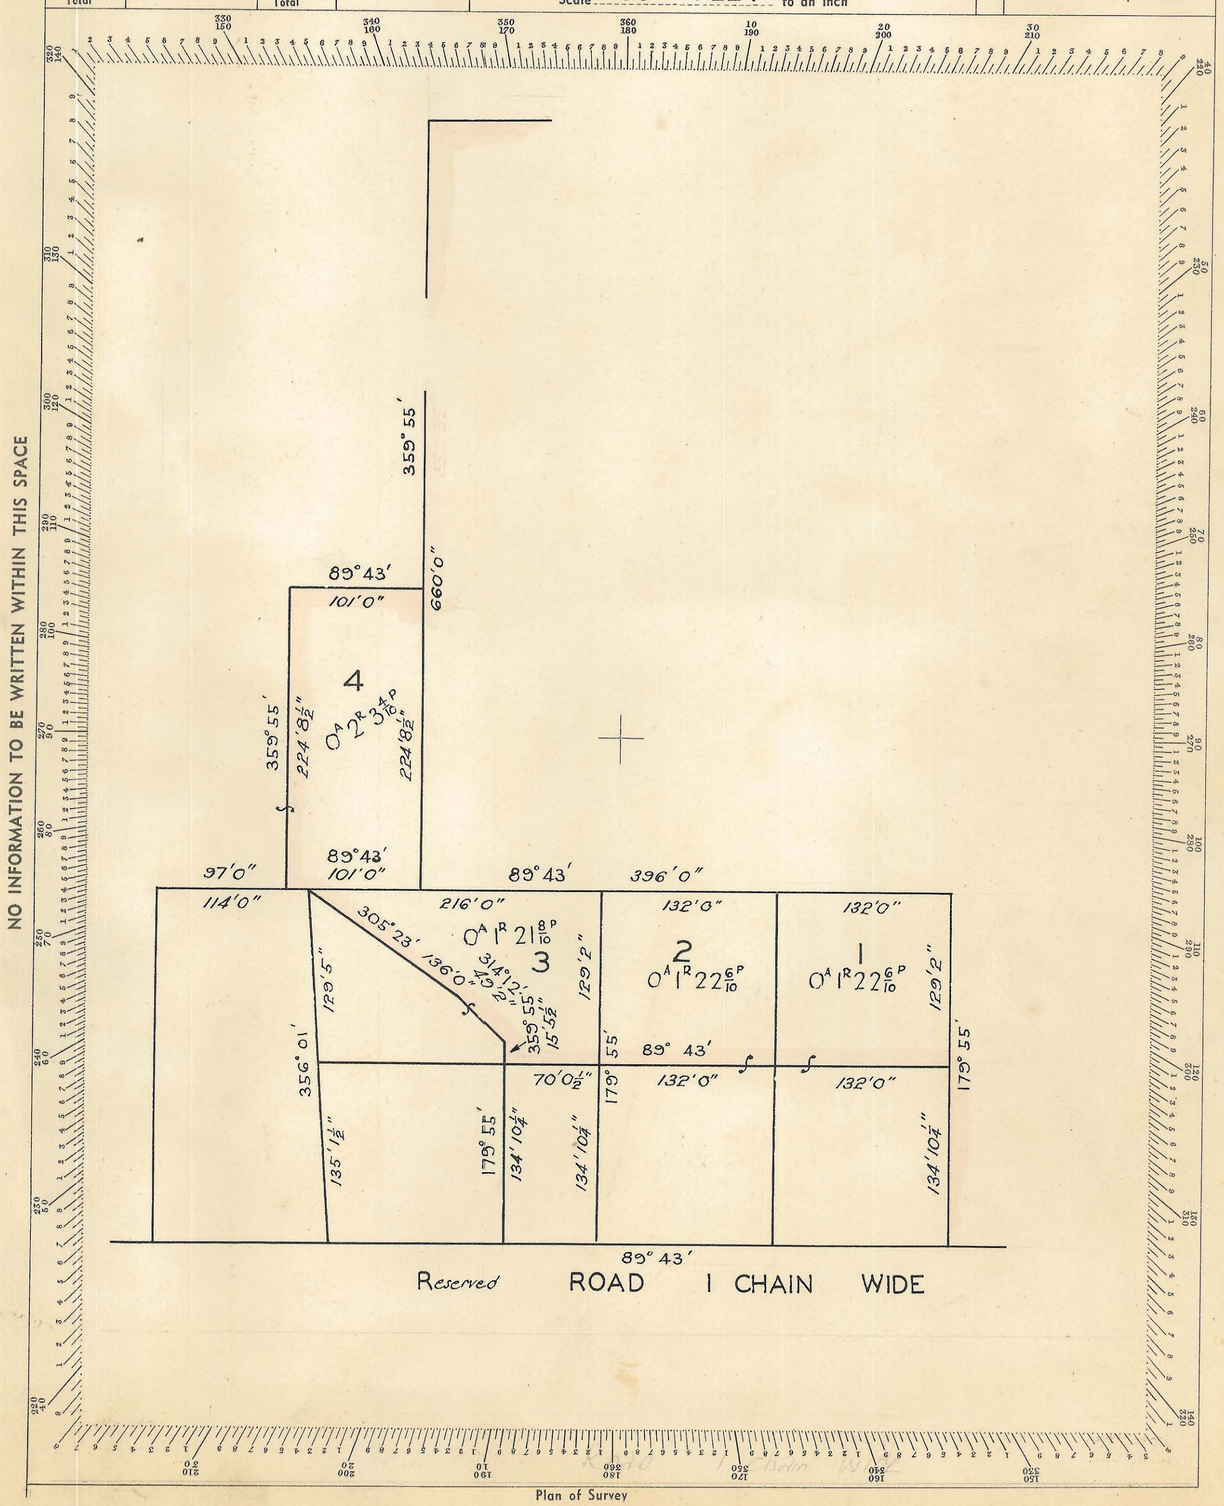

Plan of Survey