5 cm
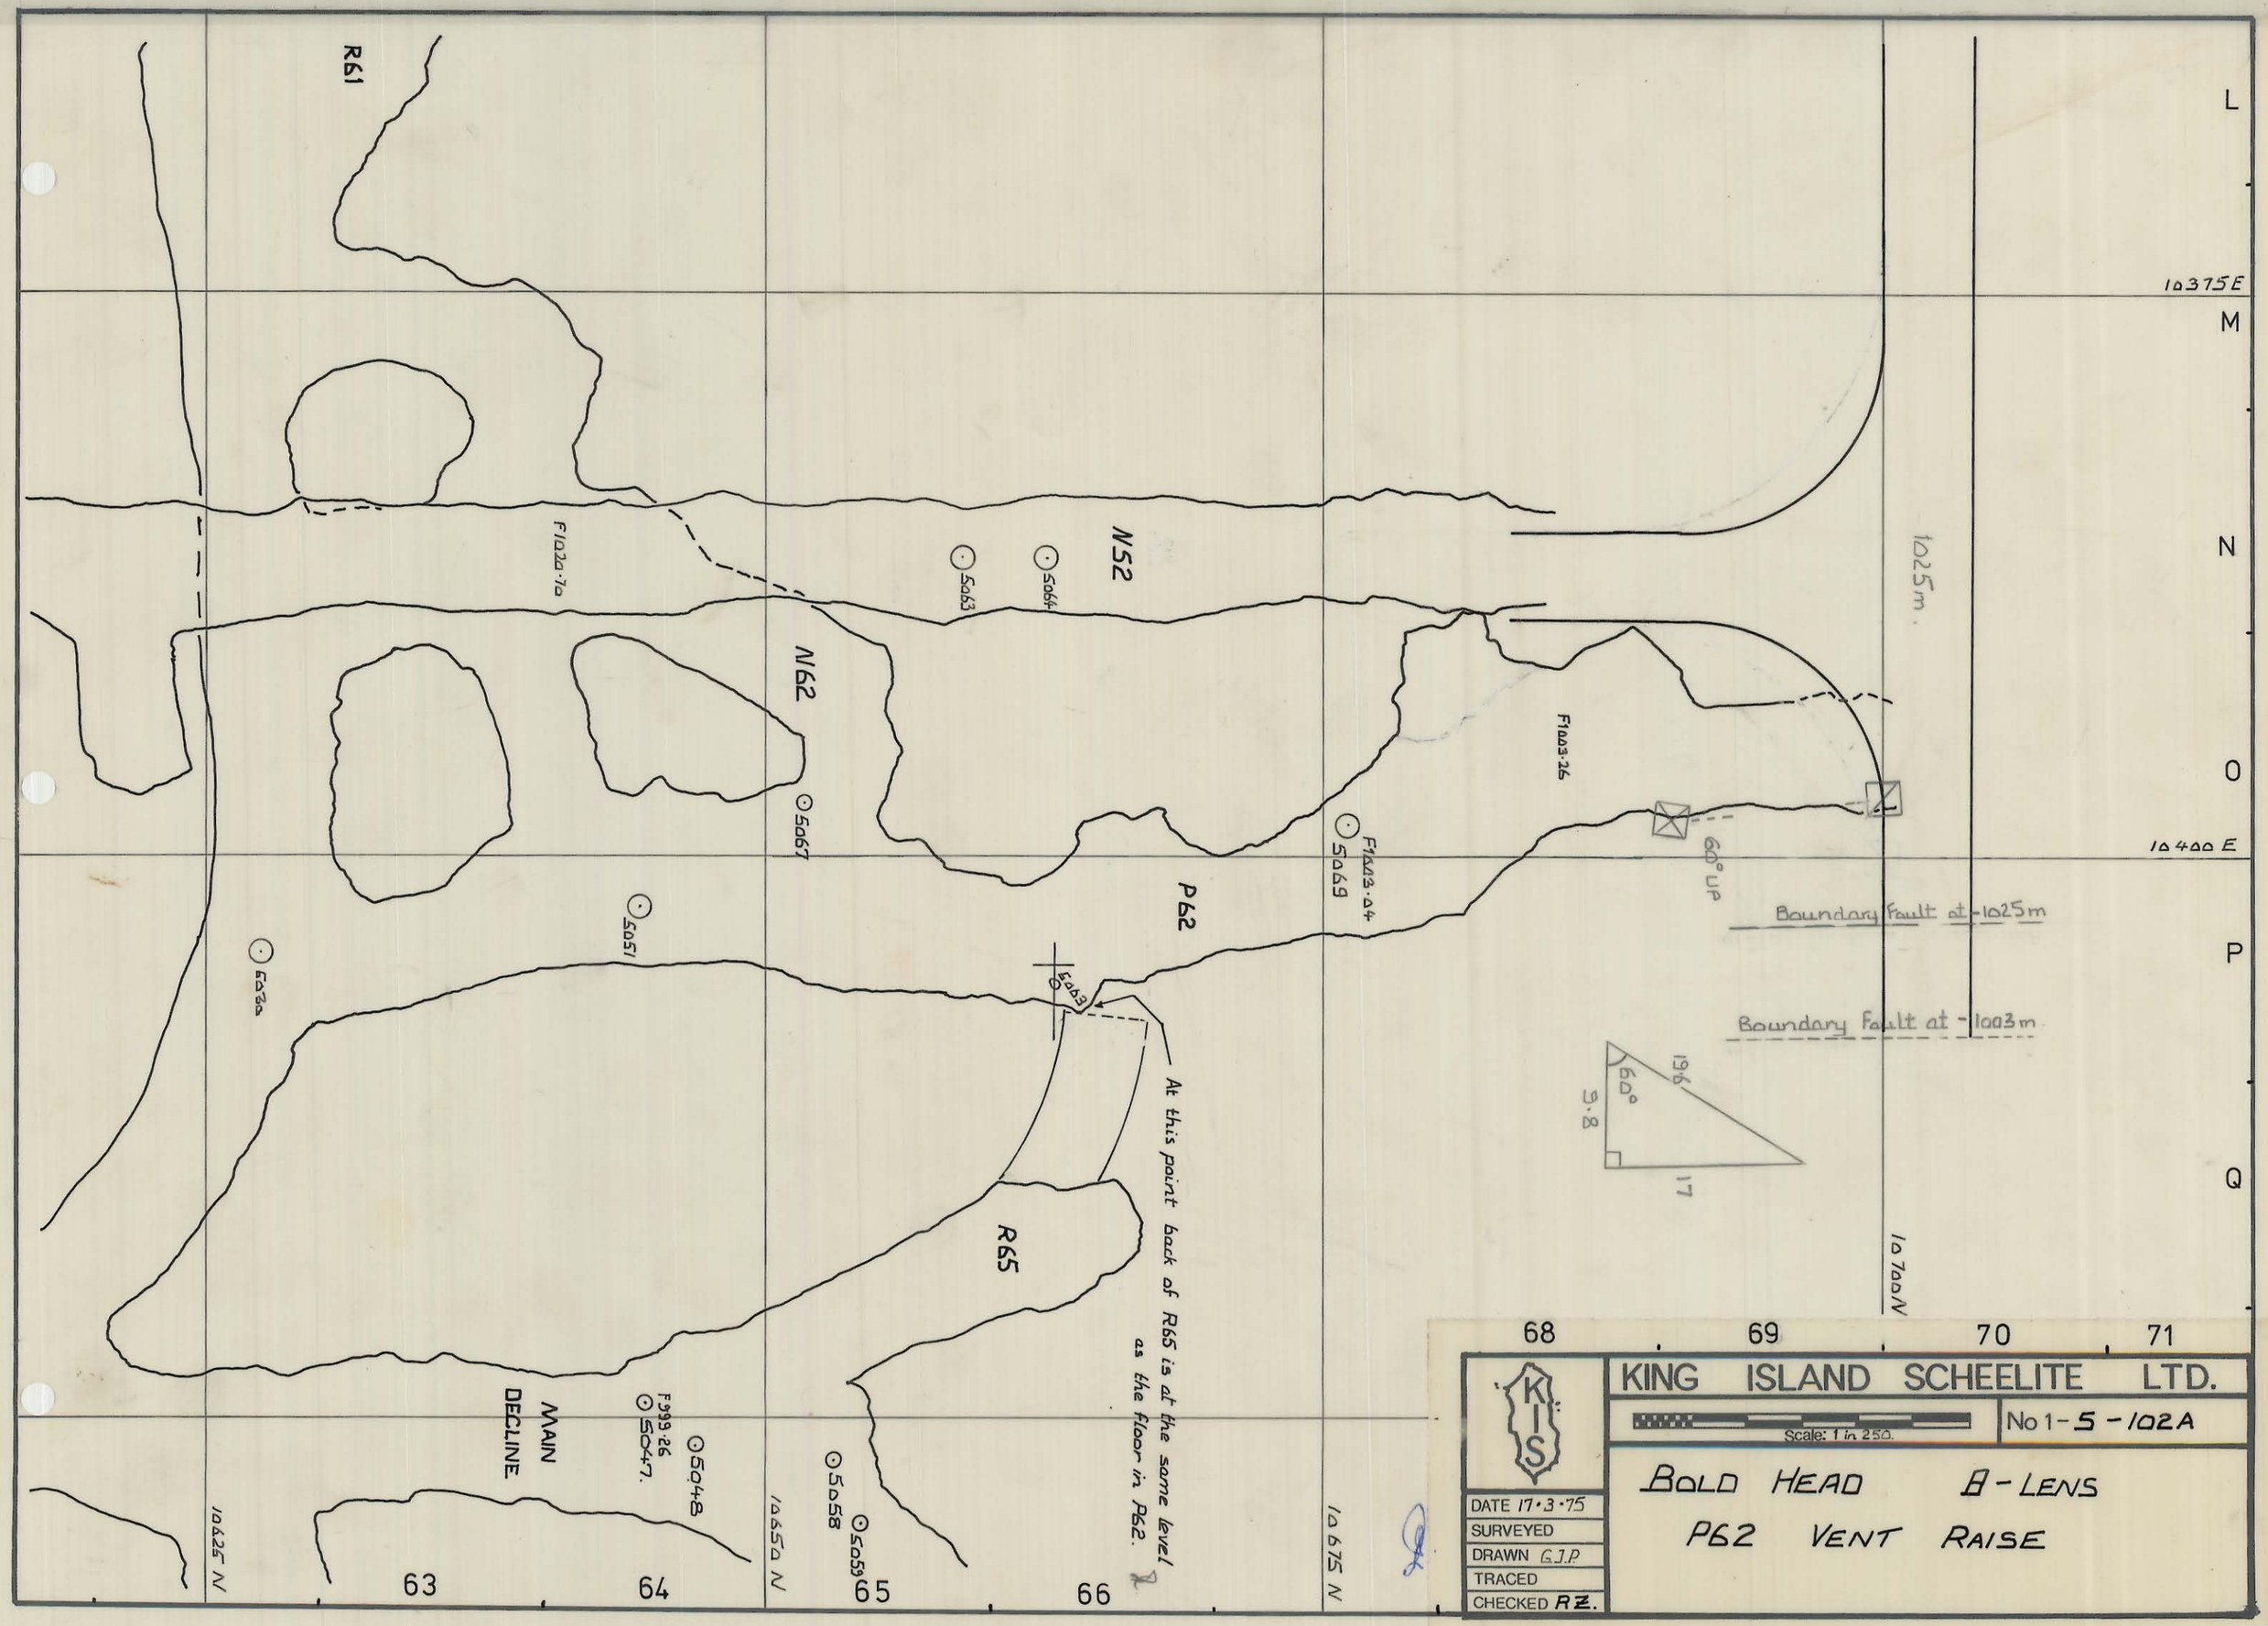
0374_3759