


5 cm

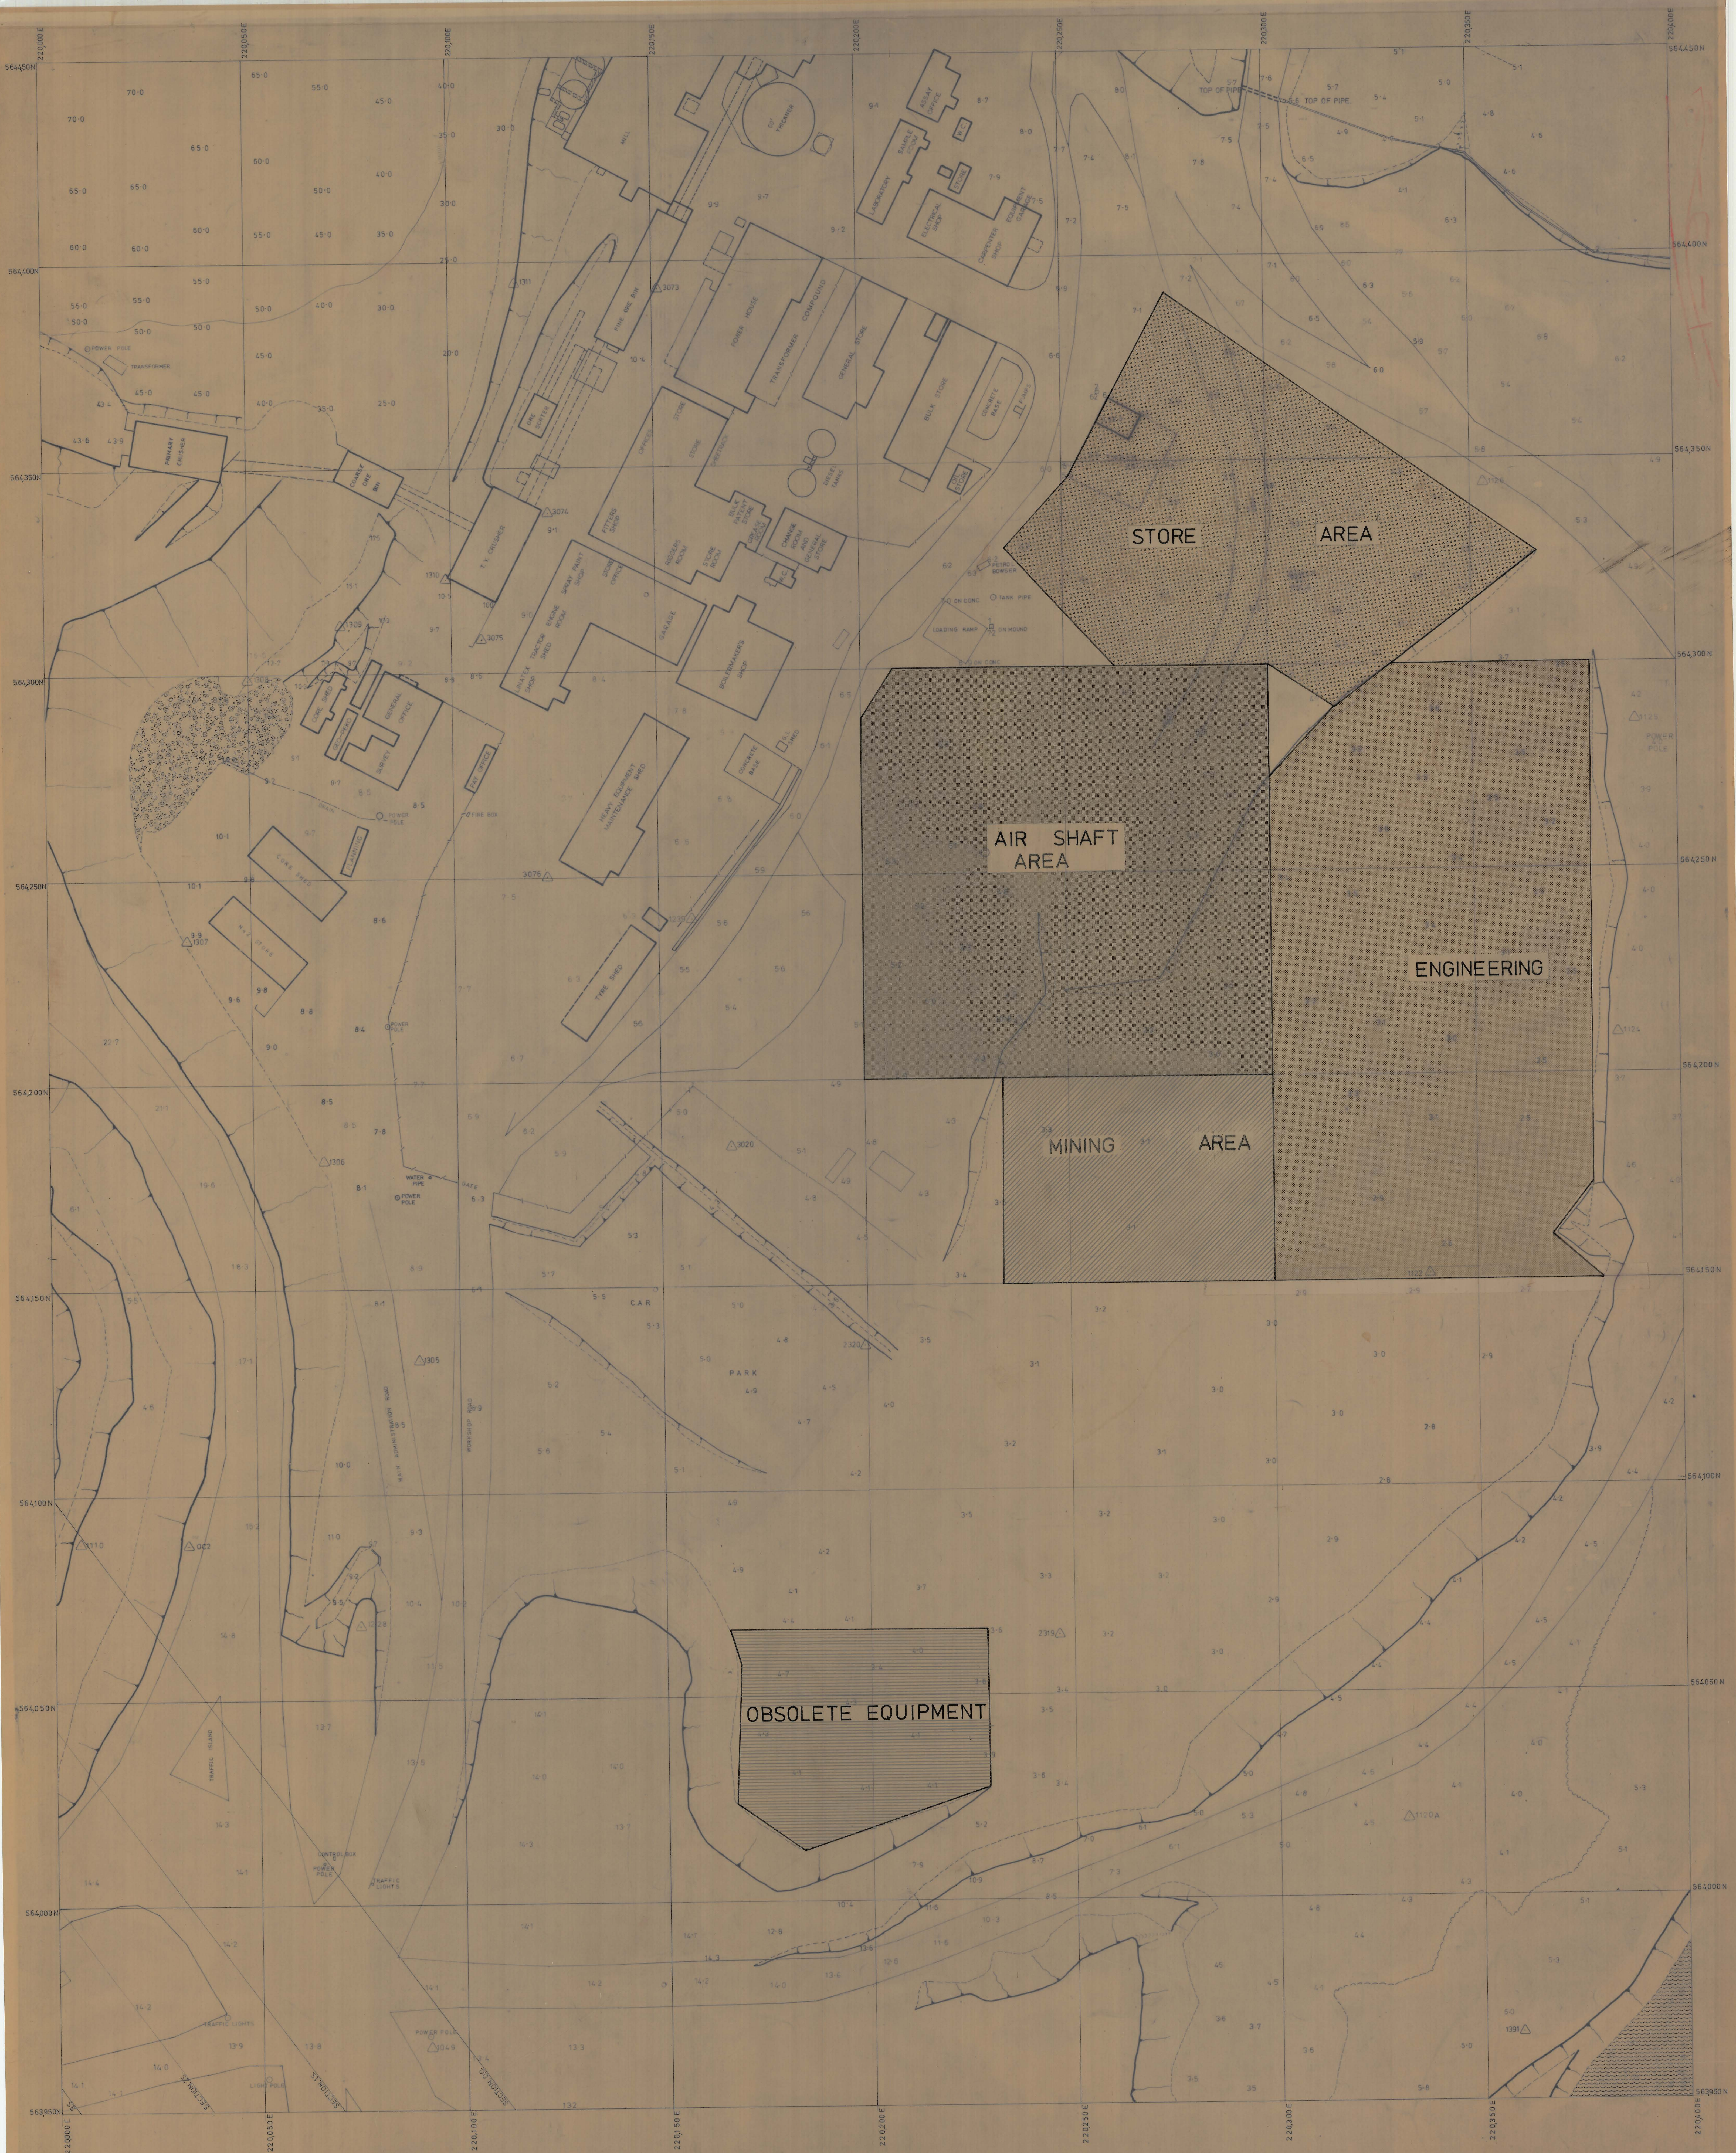

KING ISLAND SCHEELITE LTD.

No.1 AREA OPEN CUT

SCALE 1:500

C-1 C-2 C-3