0374_3808

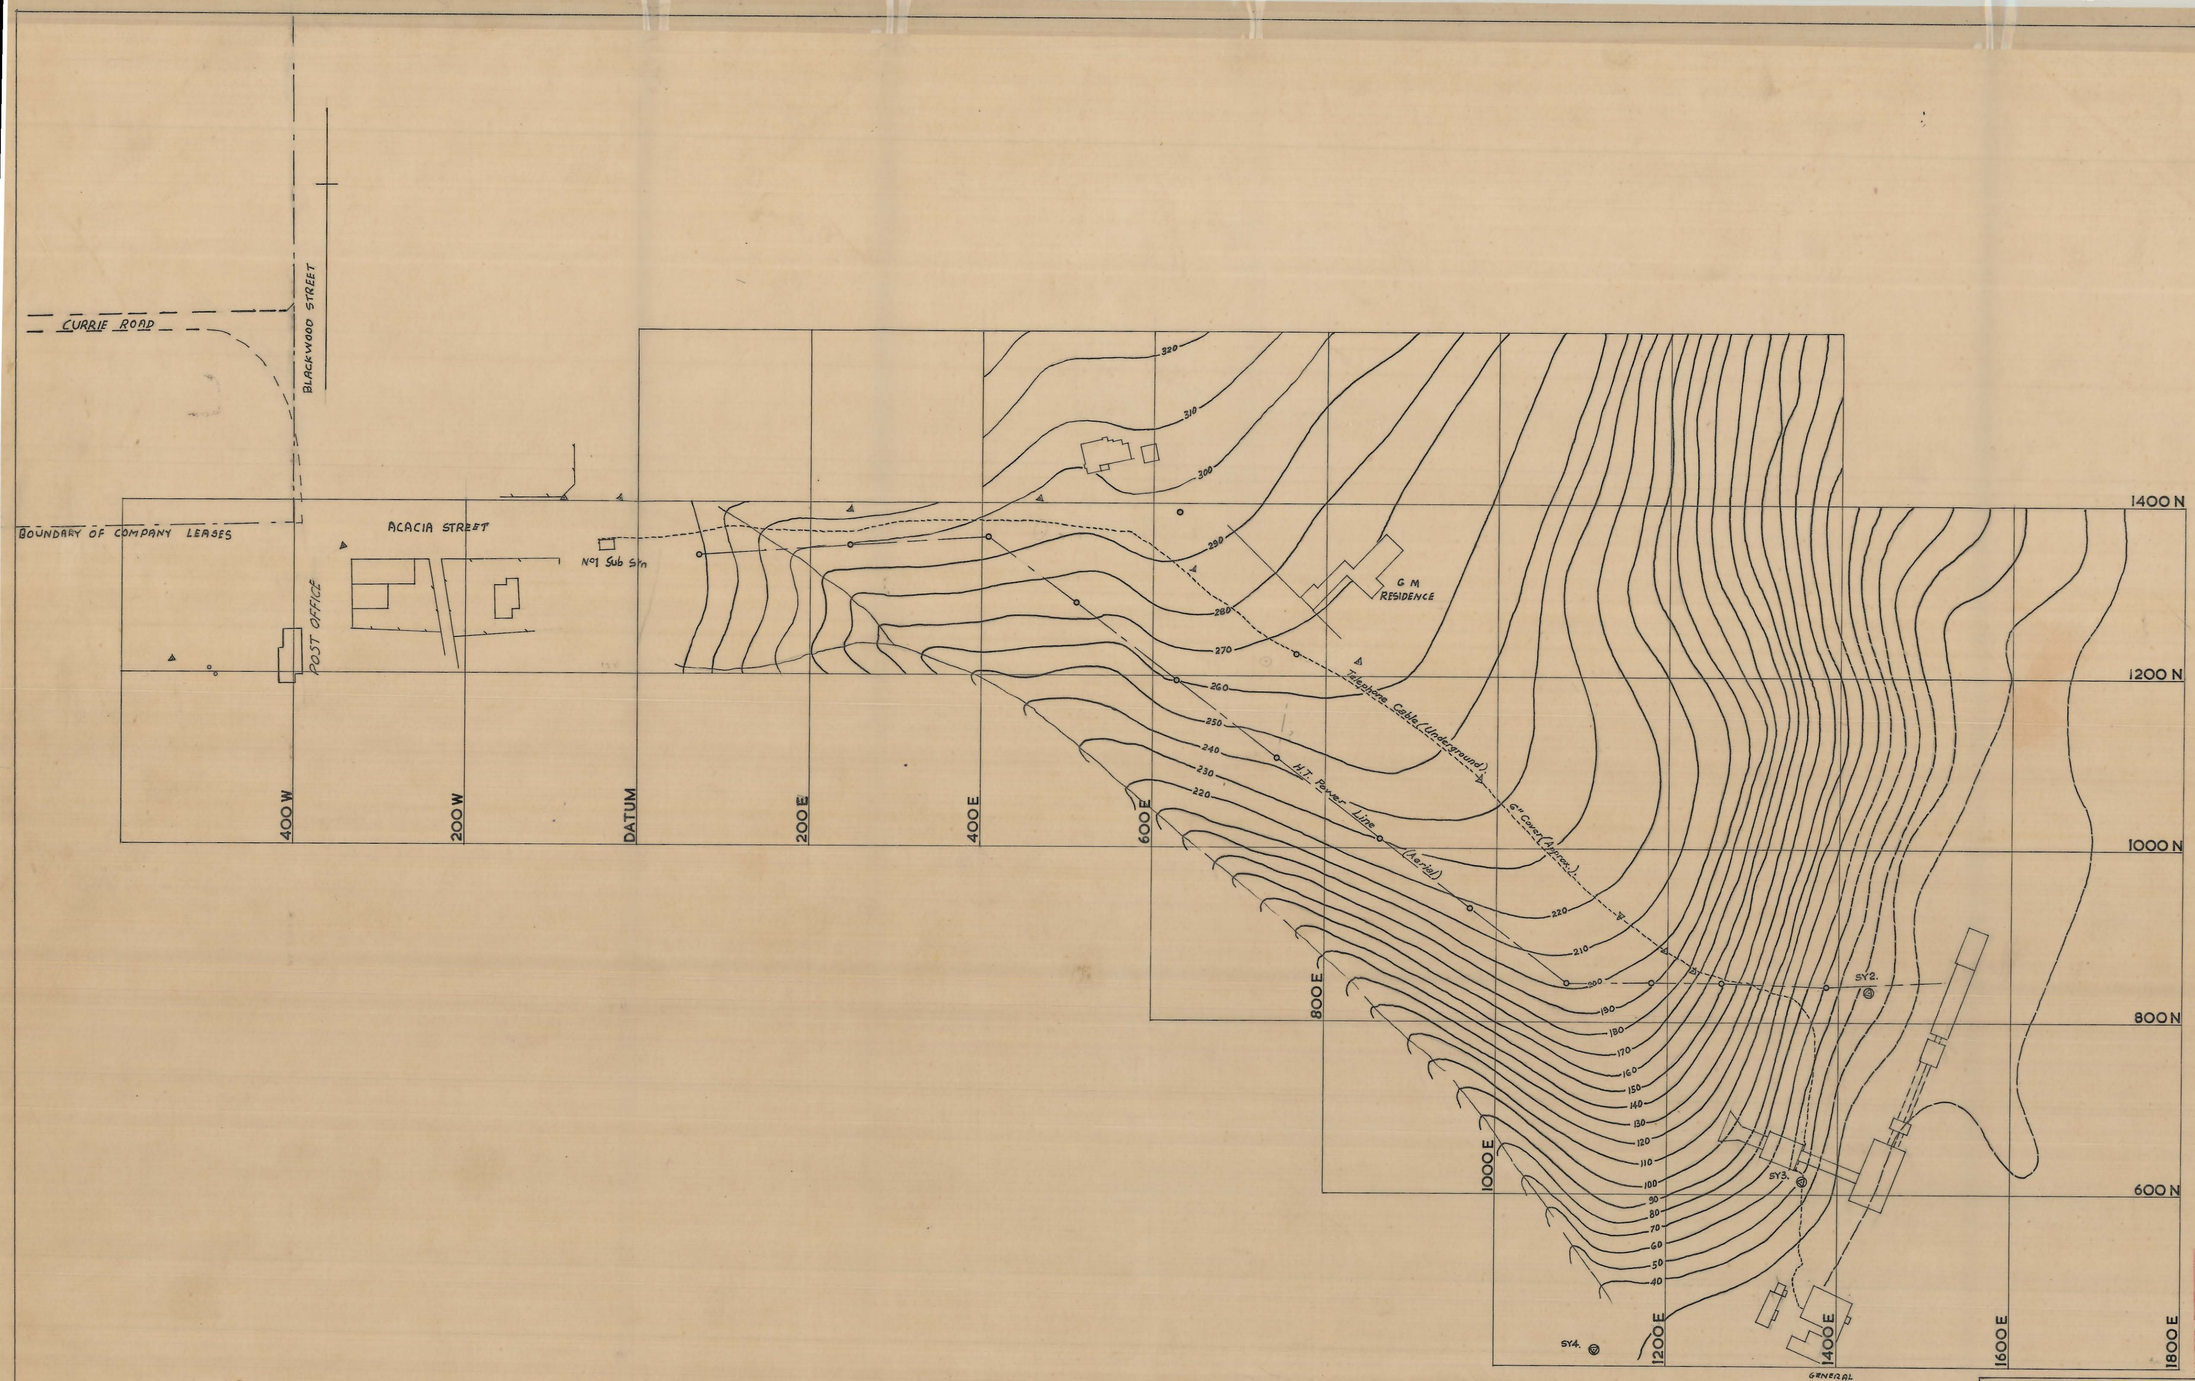

K.I.S. DRAWING No. 1 K 25

SCALE | DATE OF RECEIPT

KING ISLAND SCHEELITE 1947 LTD

LOCATION OF

TELEPHONE CABLE & HIGH TENSION POWER LINE

FROM MINE TO SUB-STATION NUMBER ONE

SCALE: 100 FEET TO AN INCH		QS 95
	DRAWN	
	TRACED	
	DATE	4th 10.'57