0374_3851

5 cm

15GD03-X017

Field Notes of Survey for Grassy Progress Association 7/6/57

KING ISLAND

PARISH OF KITTAWA.

Part of Lot 22726, 483 A 2 R 12 P, The Perpetual Executors + Trustees Ass^n of Aust. Ltd and Thos McCormack, Purs.

NEW SERIES TITLES		
LOT/AREA	VOL.	FOL.
10 1. 26	3134	46

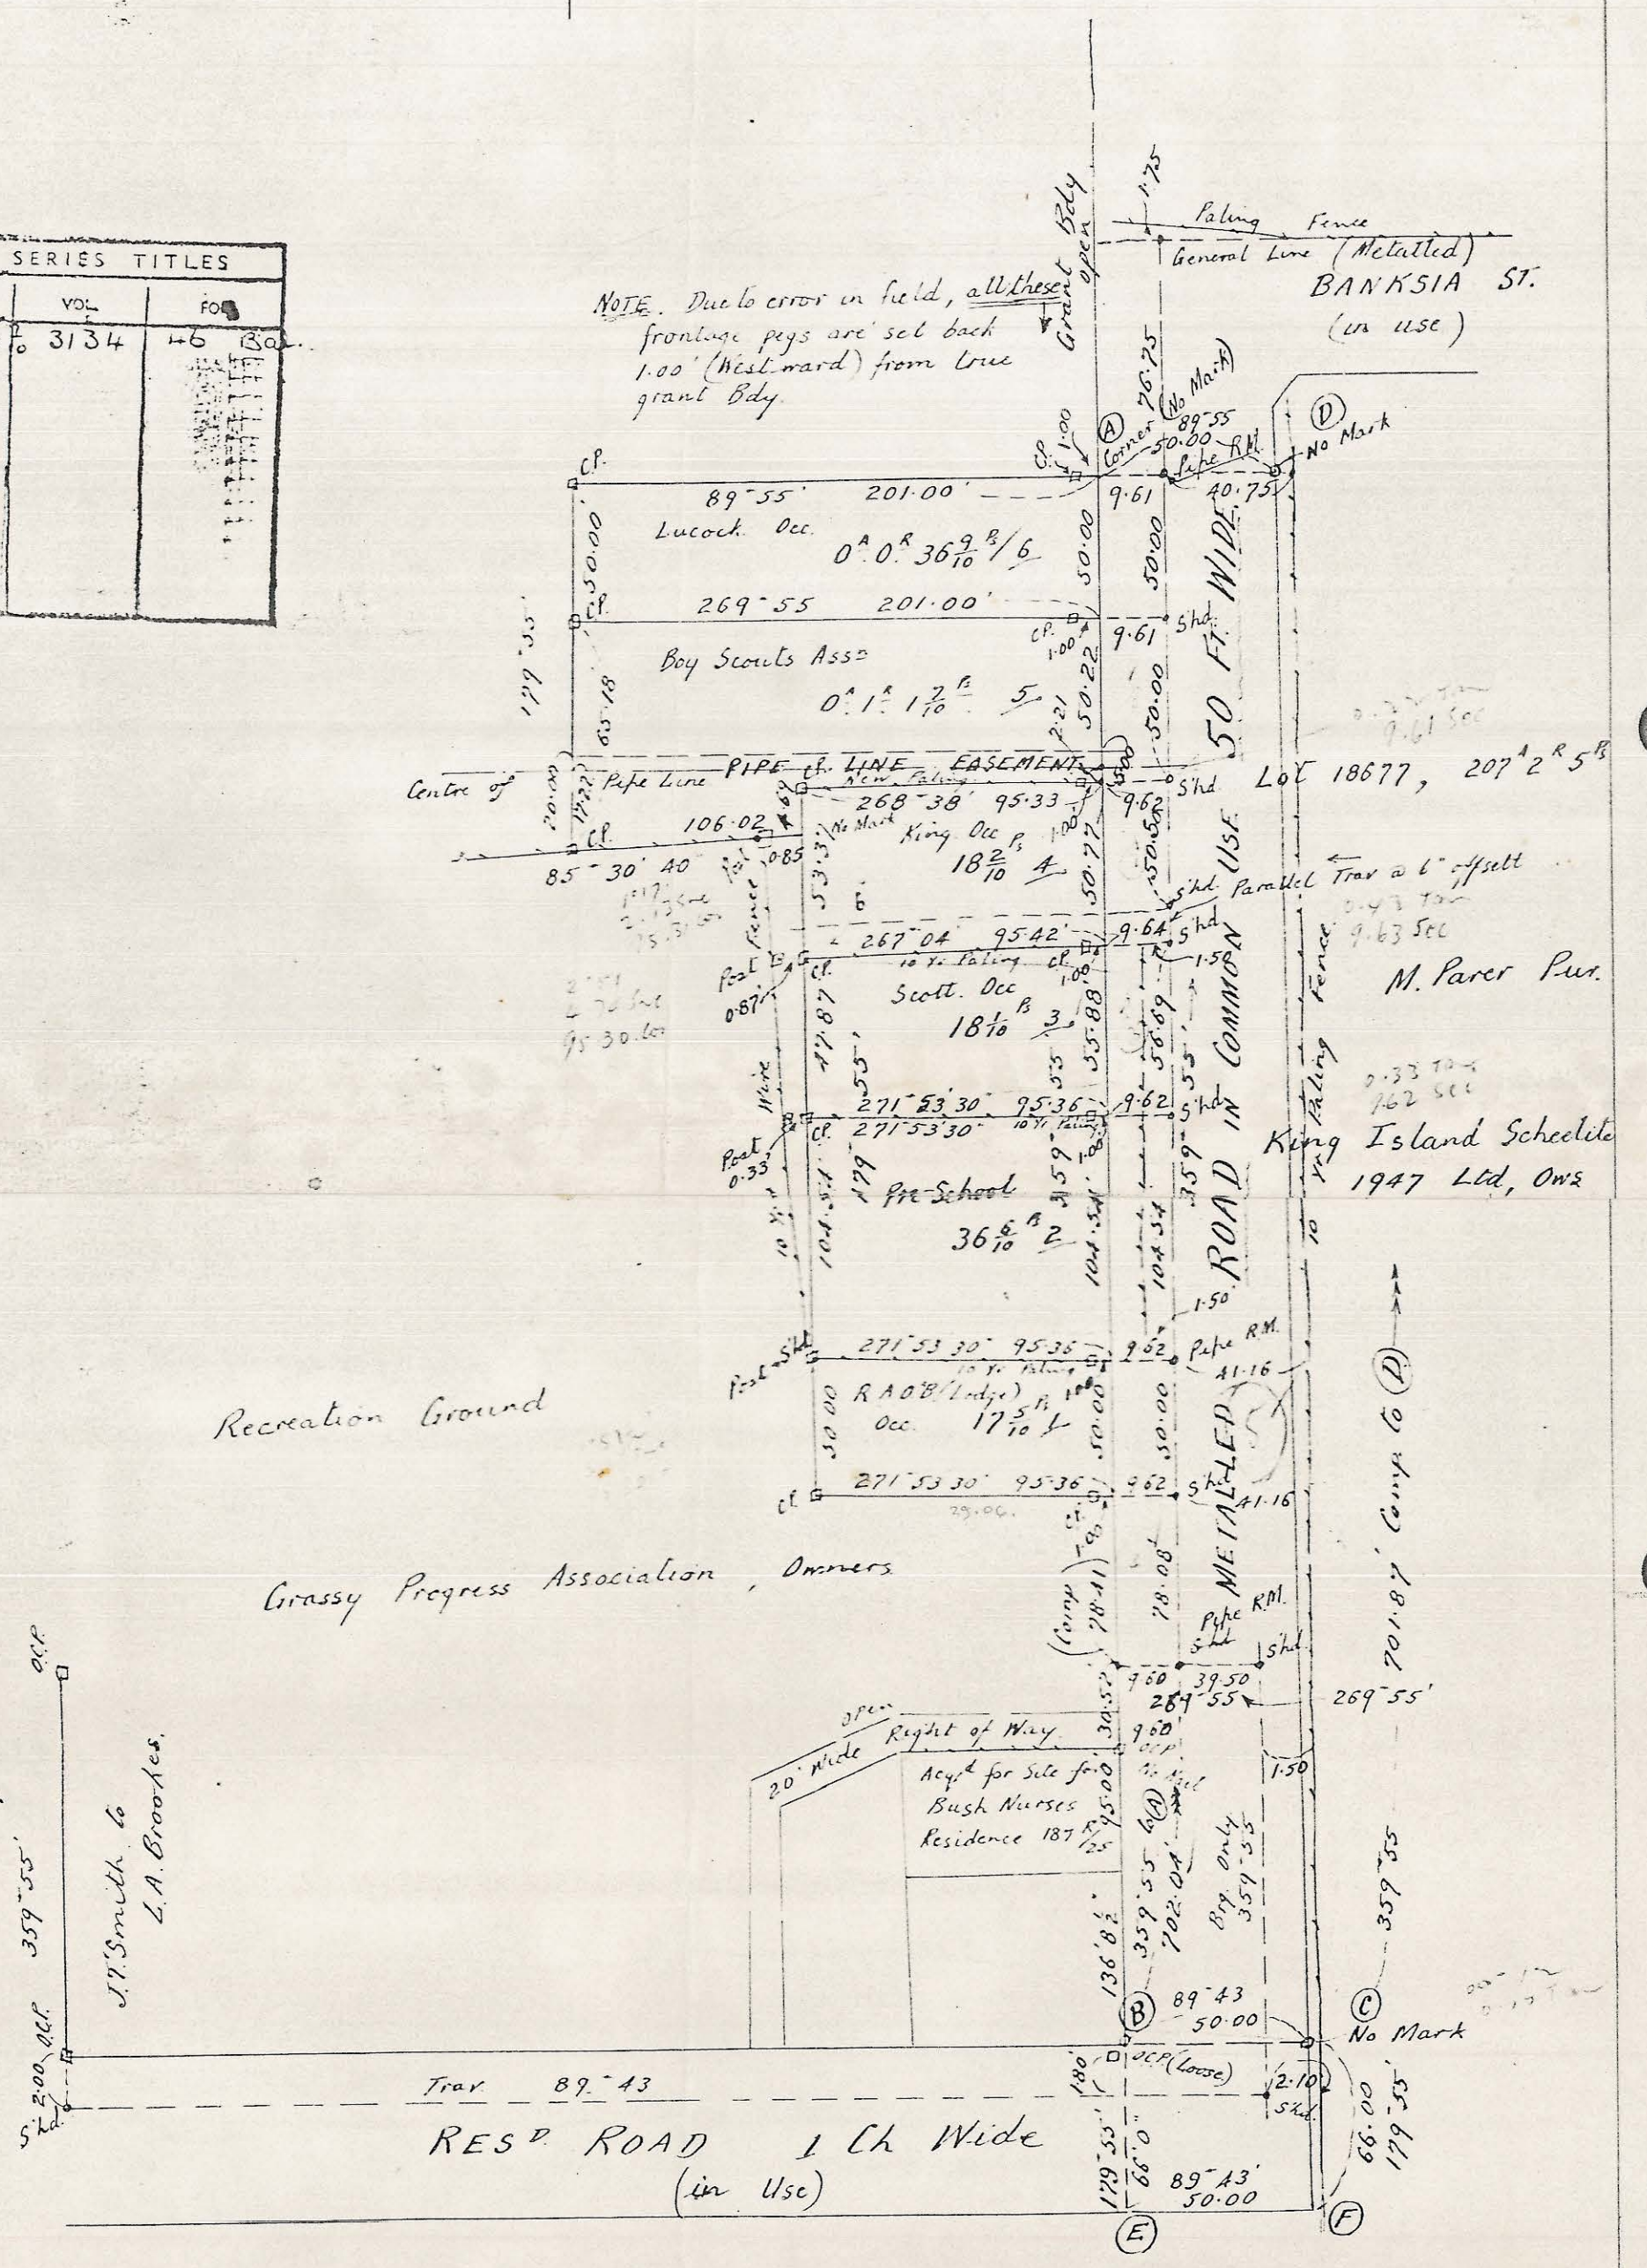

NO INFORMATION TO BE WRITTEN WITHIN THIS SPACE

15GD03-X017