


PLAN OF OPENING AND CLOSING ROADS
PARISH OF KITTAWA AT GRASSY
KING ISLAND

Scale: five chains to an inch

Roads coloured red are to be closed
Road coloured blue is to be opened with a right to extract minerals
from any area of its location

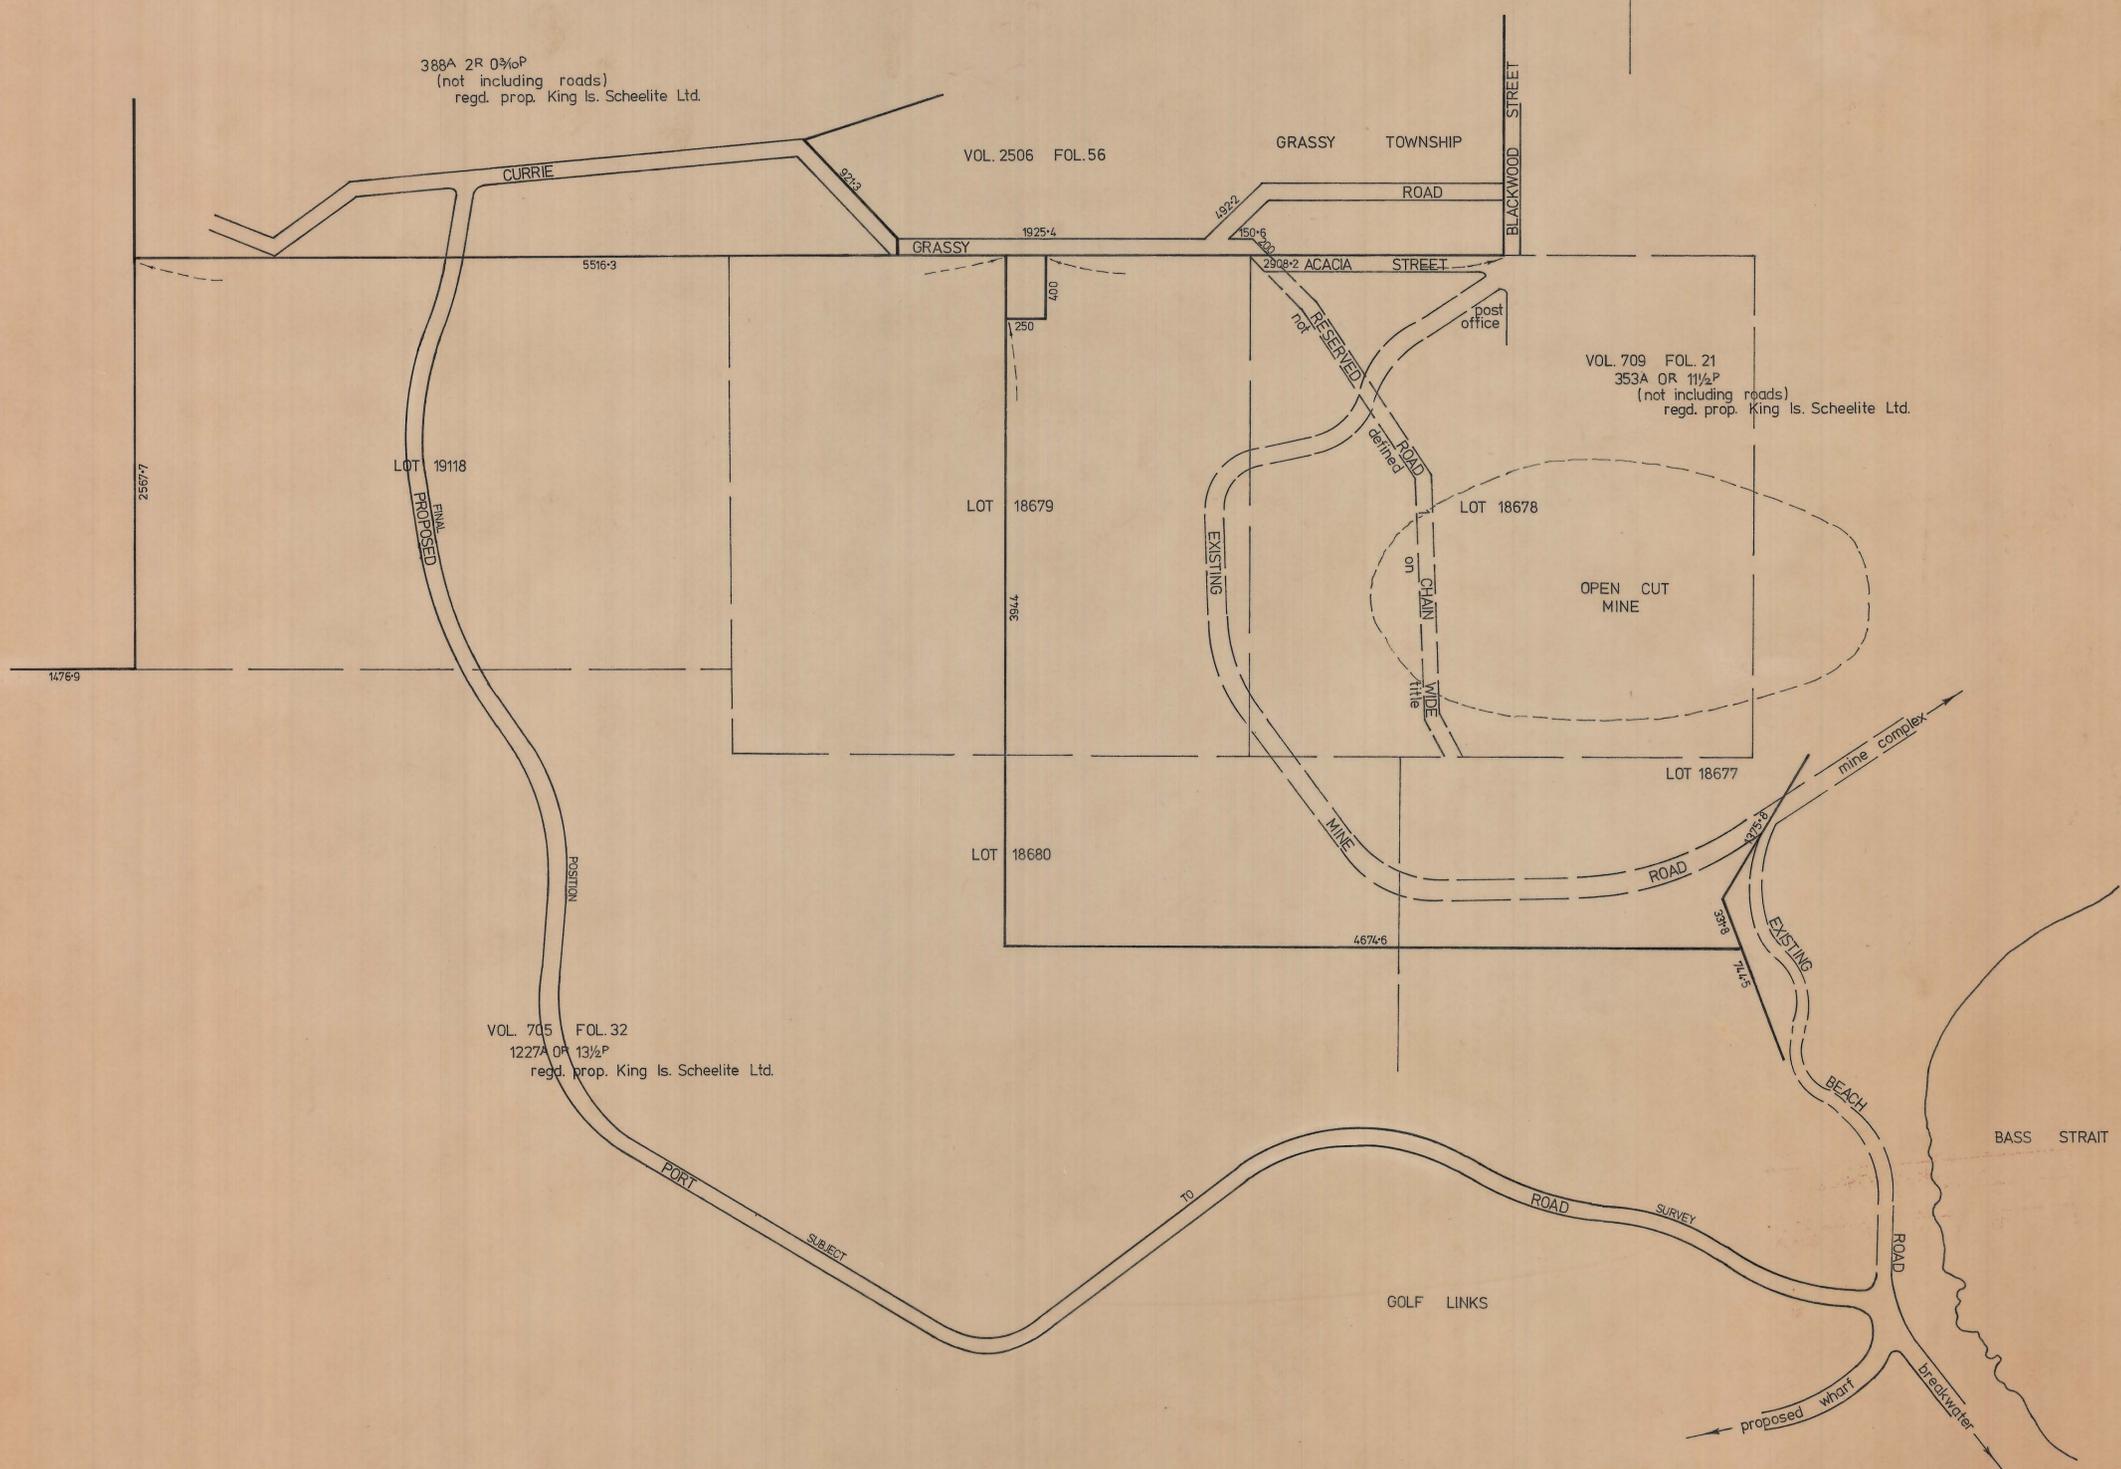

388A 2R 0 3/4 P
(not including roads)
regd. prop. King Is. Scheelite Ltd.

VOL. 2506 FOL. 56

GRASSY TOWNSHIP

VOL. 709 FOL. 21
353A OR 1 1/2 P
(not including roads)
regd. prop. King Is. Scheelite Ltd.

VOL. 705 FOL. 32
1227A OR 13 1/2 P
regd. prop. King Is. Scheelite Ltd.

K.I.S. DRAWING No. 1119
SCALE DATE OF RECEIPT

1-19-11