


5 cm

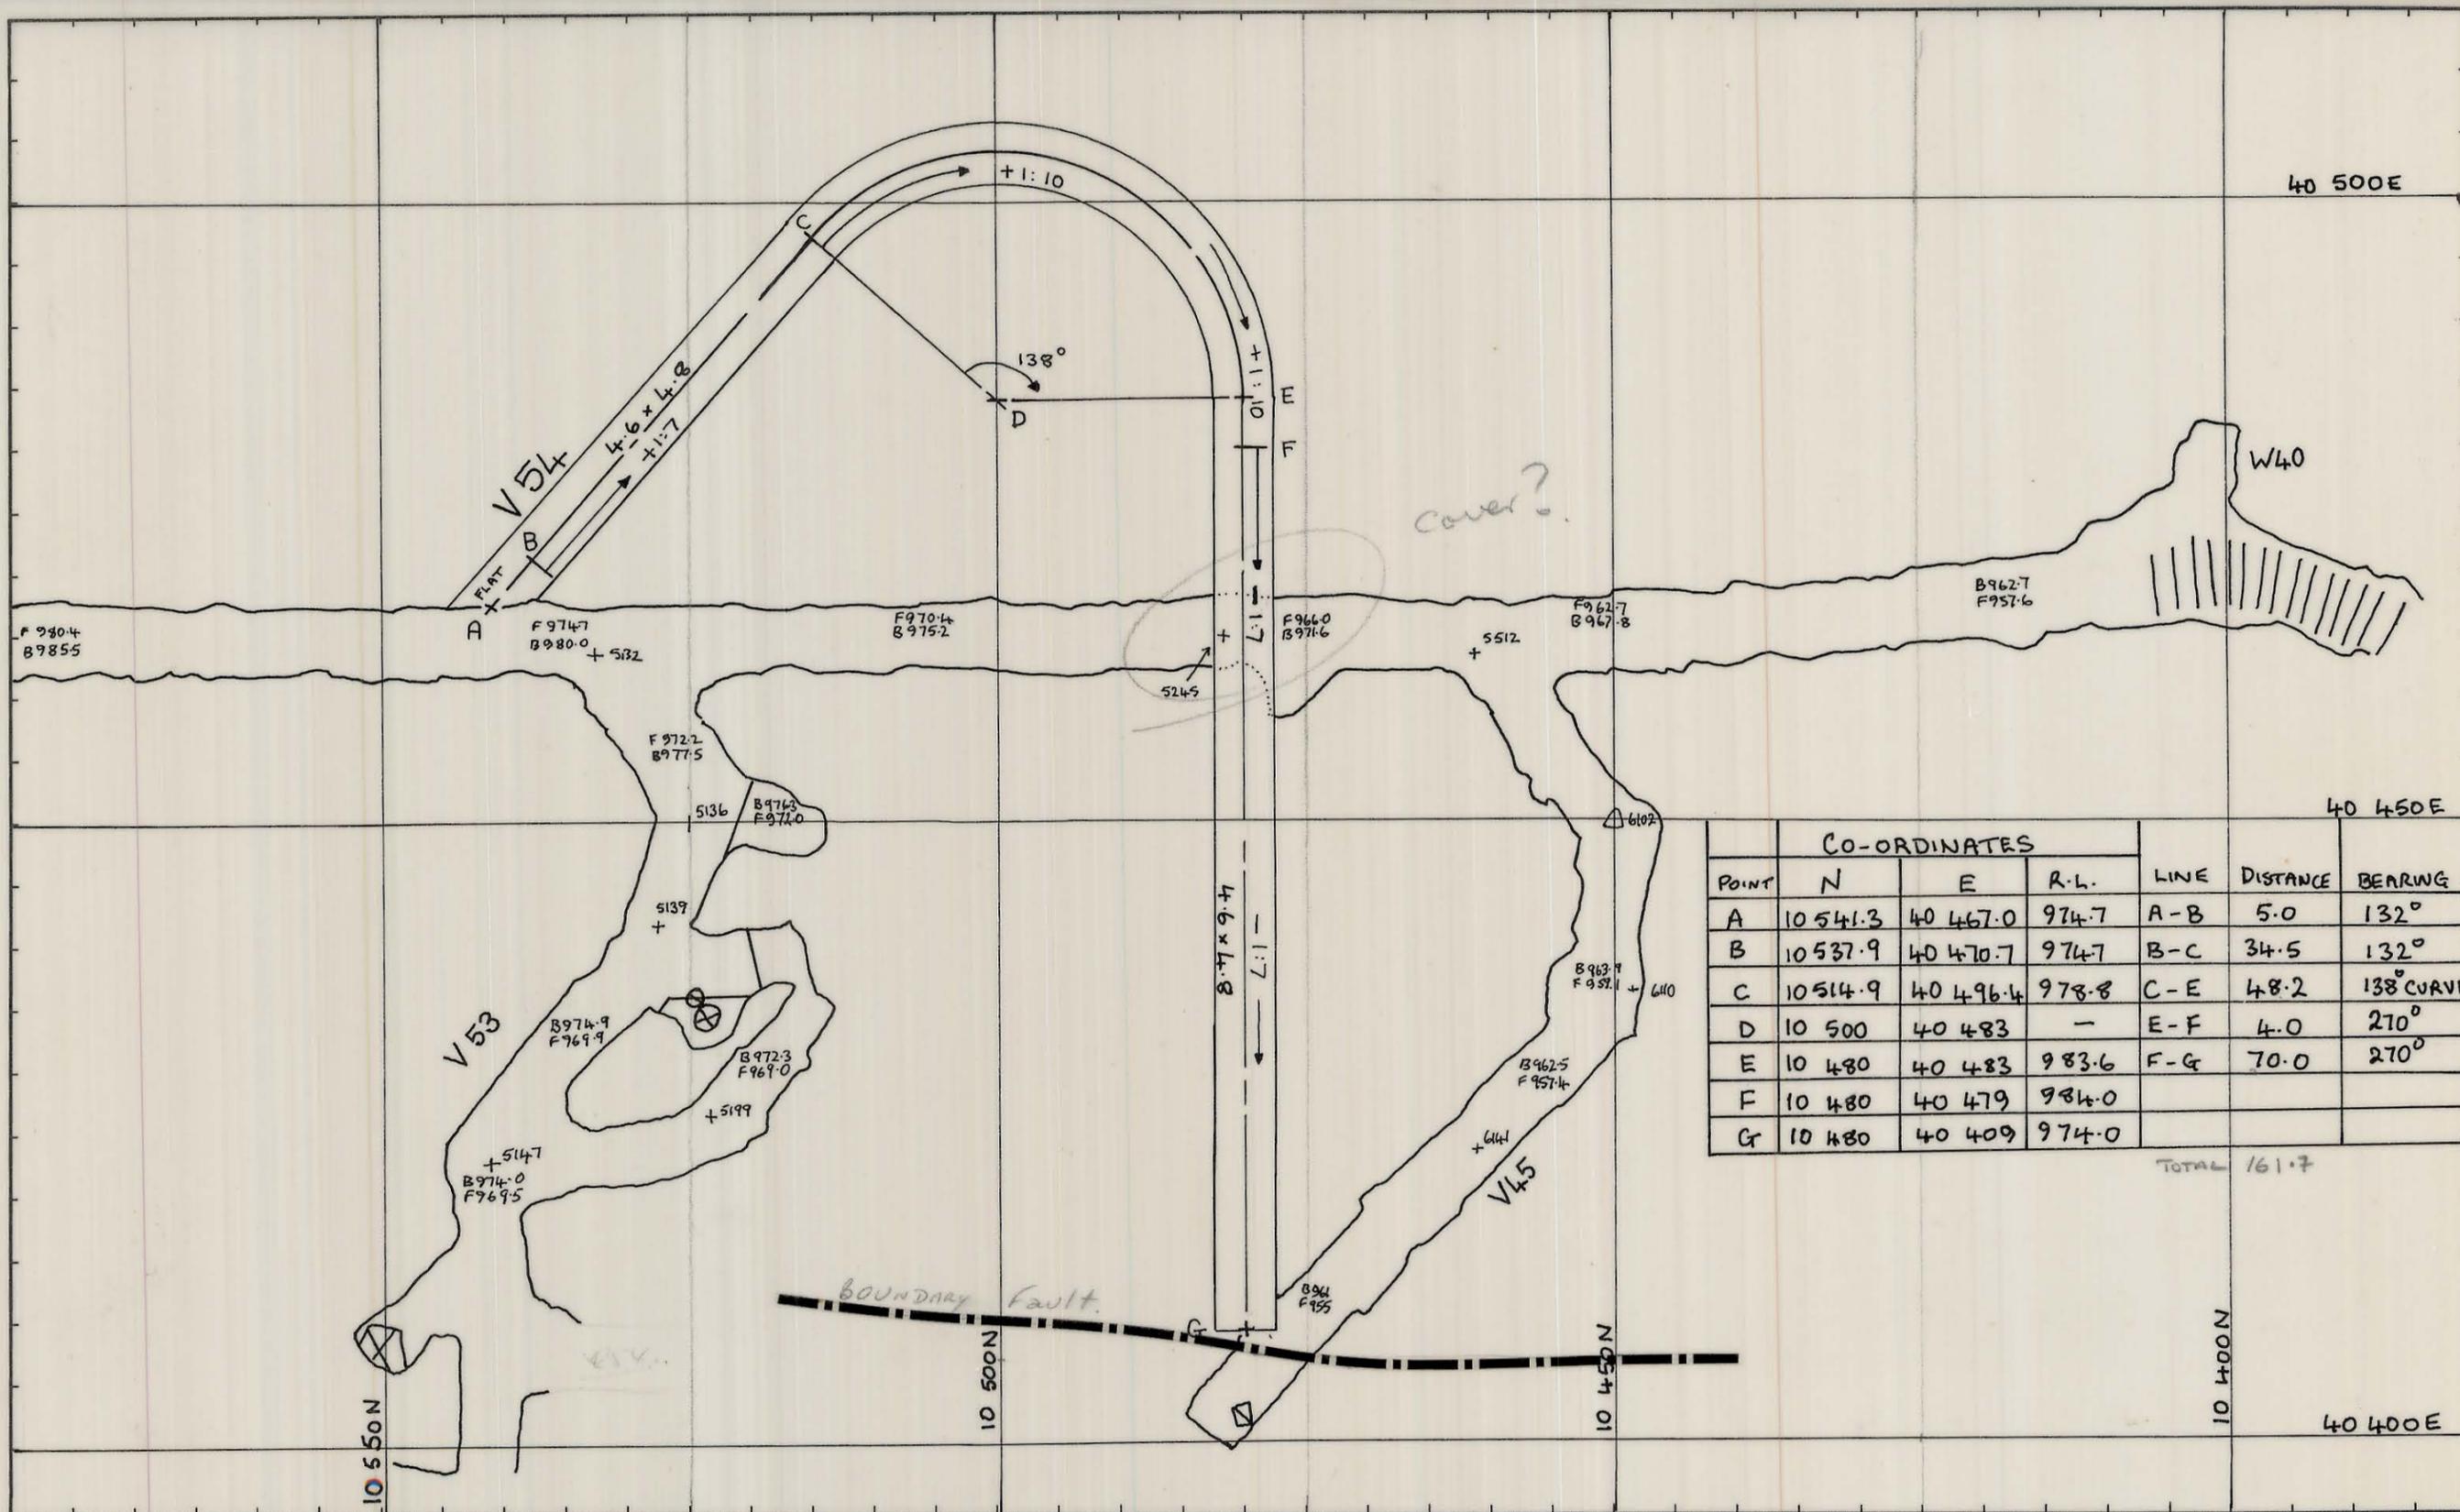

POINT	CO-ORDINATES			LINE	DISTANCE	BEARING
	N	E	R.L.			
A	10 541.3	40 467.0	974.7	A-B	5.0	132°
B	10 537.9	40 470.7	974.7	B-C	34.5	132°
C	10 514.9	40 496.4	978.8	C-E	48.2	138° CURVE
D	10 500	40 483	-	E-F	4.0	270°
E	10 480	40 483	983.6	F-G	70.0	270°
F	10 480	40 479	984.0			
G	10 480	40 409	974.0			
					TOTAL	161.7

REF PLAN 04 BH 14 - 1006  
 SUPERCEDES V59 ACCESS  
 03 BH 04 - 3016

GEOLOGY *CK* 19-2-82  
 SURVEY *BAL* 20/2/82  
 PLANNING *ADT* 9-2-82  
 ROCK MEC. *du* 25.3.82  
 GMS  
 MIN SUP  
 T.S.S. *W. Jpn* 30/3/82

SCALE 1:500  
**V54 FAULT BLOCK ACCESS**  
**BOLD HEAD**  
 DRAWING NUMBER  
 03 BH 04 - 3021

