27 JUN 1981

0374_3895

5 cm
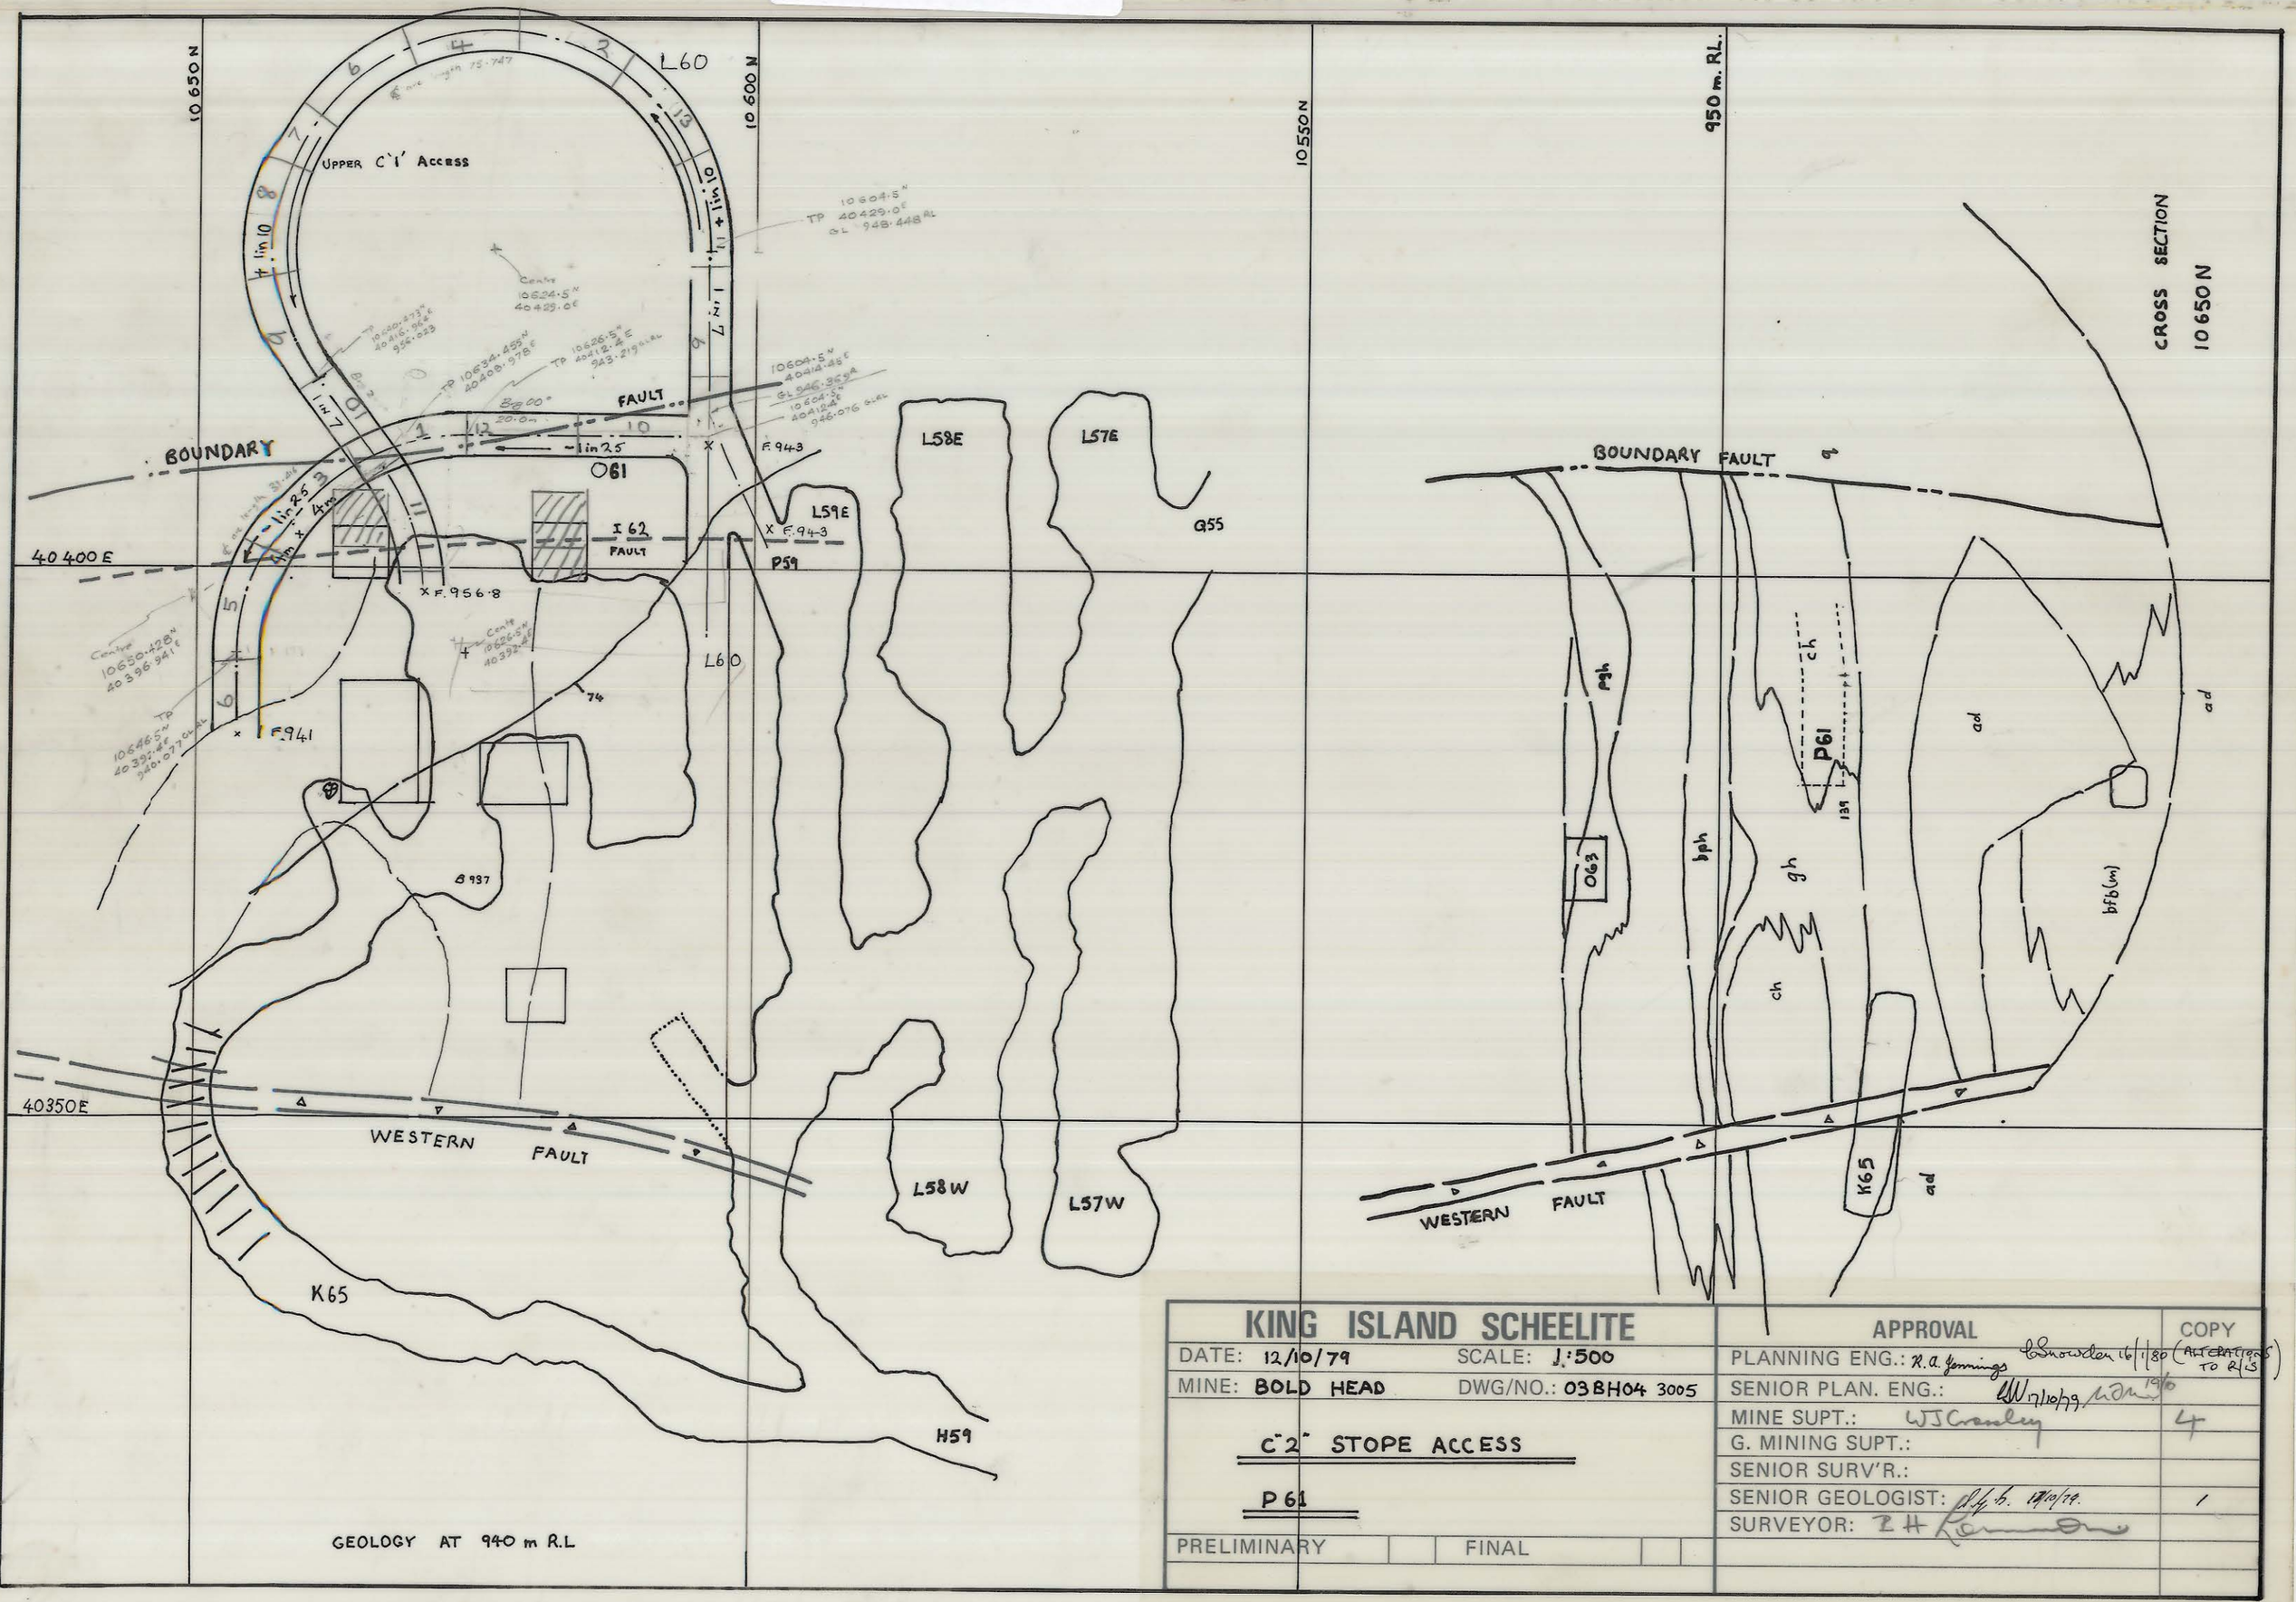
03BH04 3005