APPROVAL			COPY
PLANNING [redacted]G.:			
SENIOR PLAN. ENG.:		18/12/79	4
MINE SUPT.:	WSC		
G. MINING SUPT.:		18/12	
SENIOR SURV'R.:		18/12/79	
SENIOR GEOLOGIST:		18/12/79	
SURVEYOR:		18/12/79	

NOTE. ▲

NEW PILLAR DIMENSIONS AND POSITION ON 10500N.

MAXIMUM MINING WIDTH 8M FROM BOUNDARY FAULT.

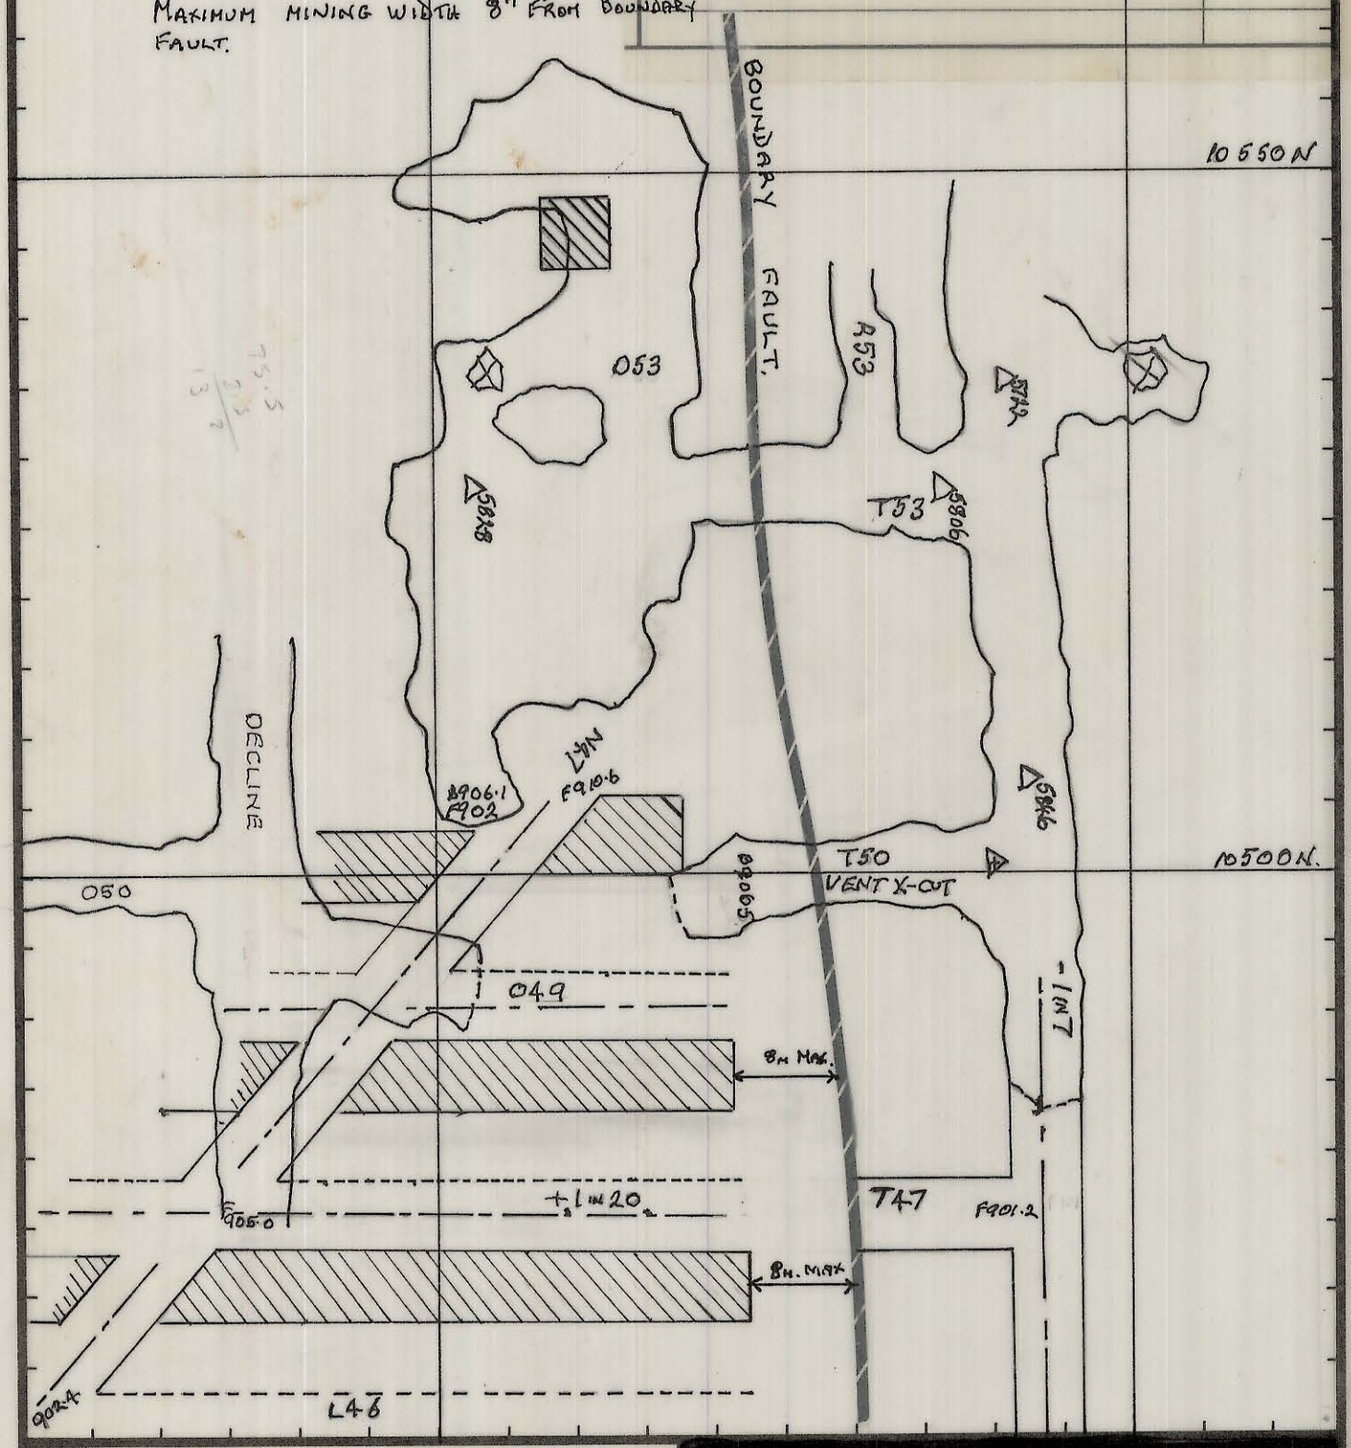

LEGEND:

cf 04BH03-1008

Scale: 1 : 500

C1 PILLAR MODIFICATIONS FOR MINING OF C2 ON BOUNDARY FAULT.

04BH04-4004

DATE:
GEOL:
DWN:
CHKD:

27 JUN 1981
0374_3896
5 cm
03BH04 4004