0374_3917

5 cm

03BH05-3018

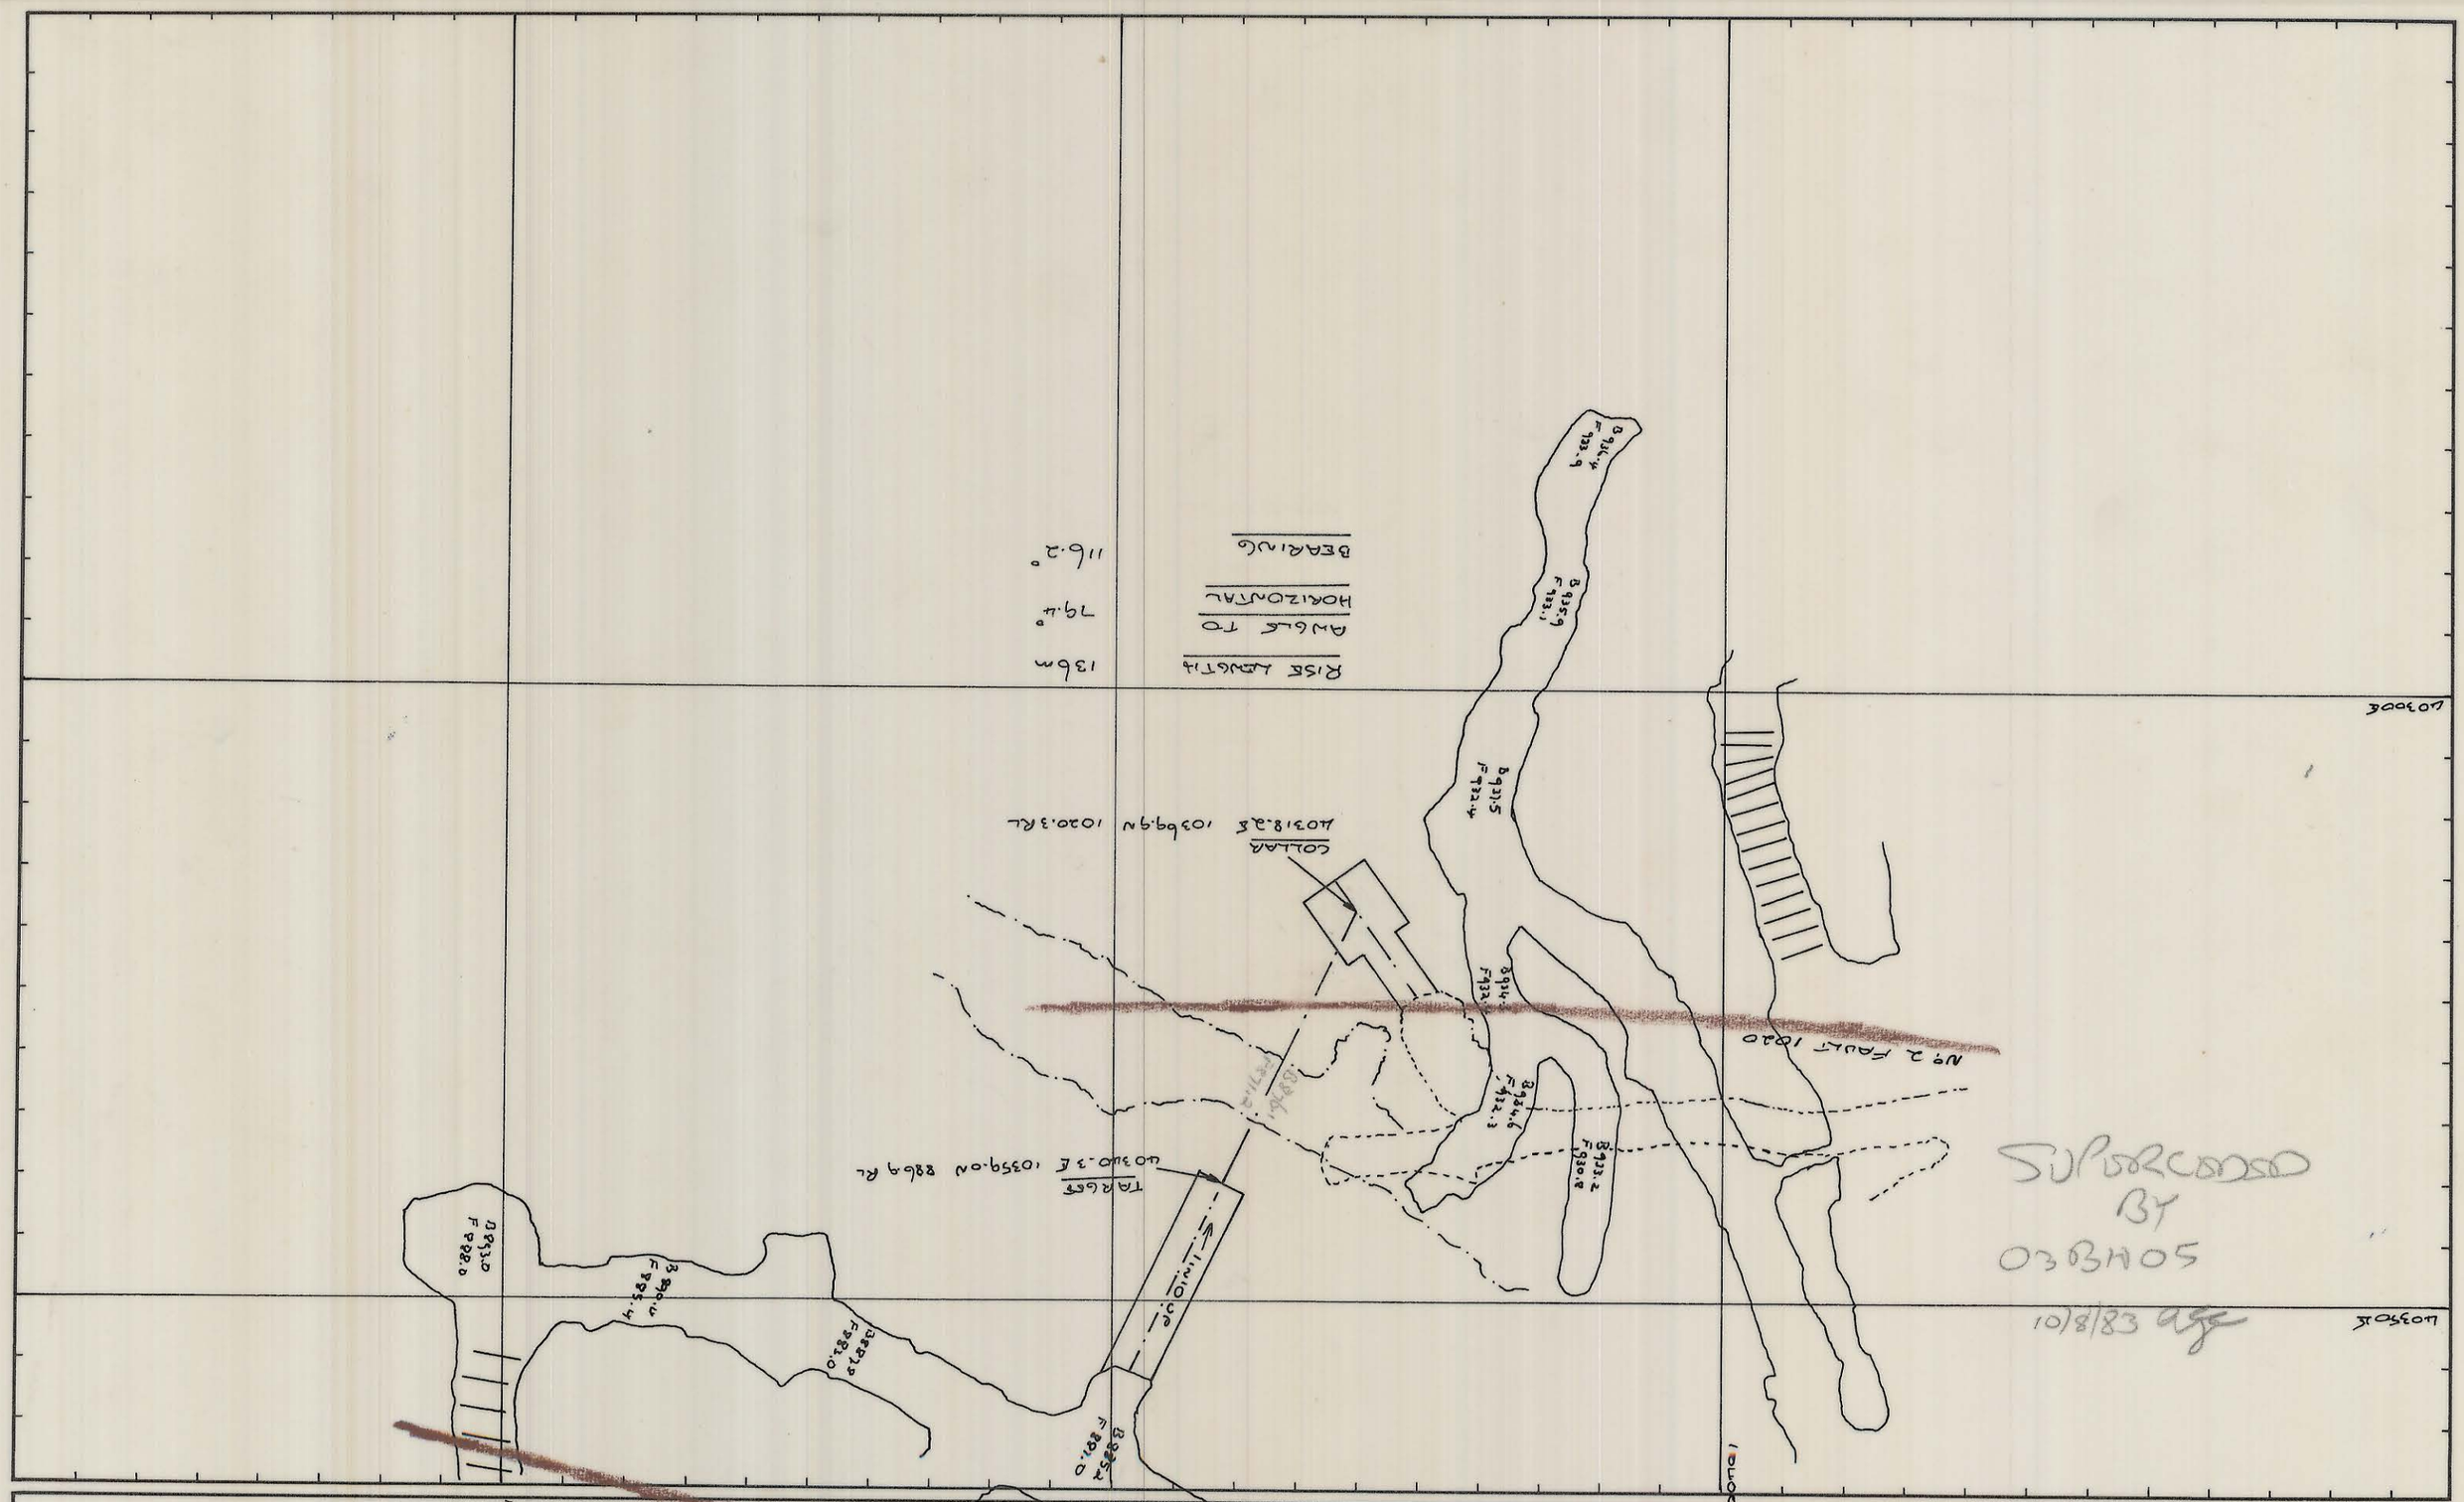

GEOLOGY		
SURVEY		
PLANNING		
ROCK MEC.		
GRADE CON.		
DRAFTING		
T.S.S.		14/12/82

REF. PLAN

SCALE 1: 500

KIS KING ISLAND SCHEELITE GRASSY KING ISLAND

BOLD HEAD MINE
MAIN VENTILATION – LOWER RAISE BORE HOLE REVISED

DRAWING NUMBER 03BH05-3018