03BH05-4008.

0374_3926

5 cm

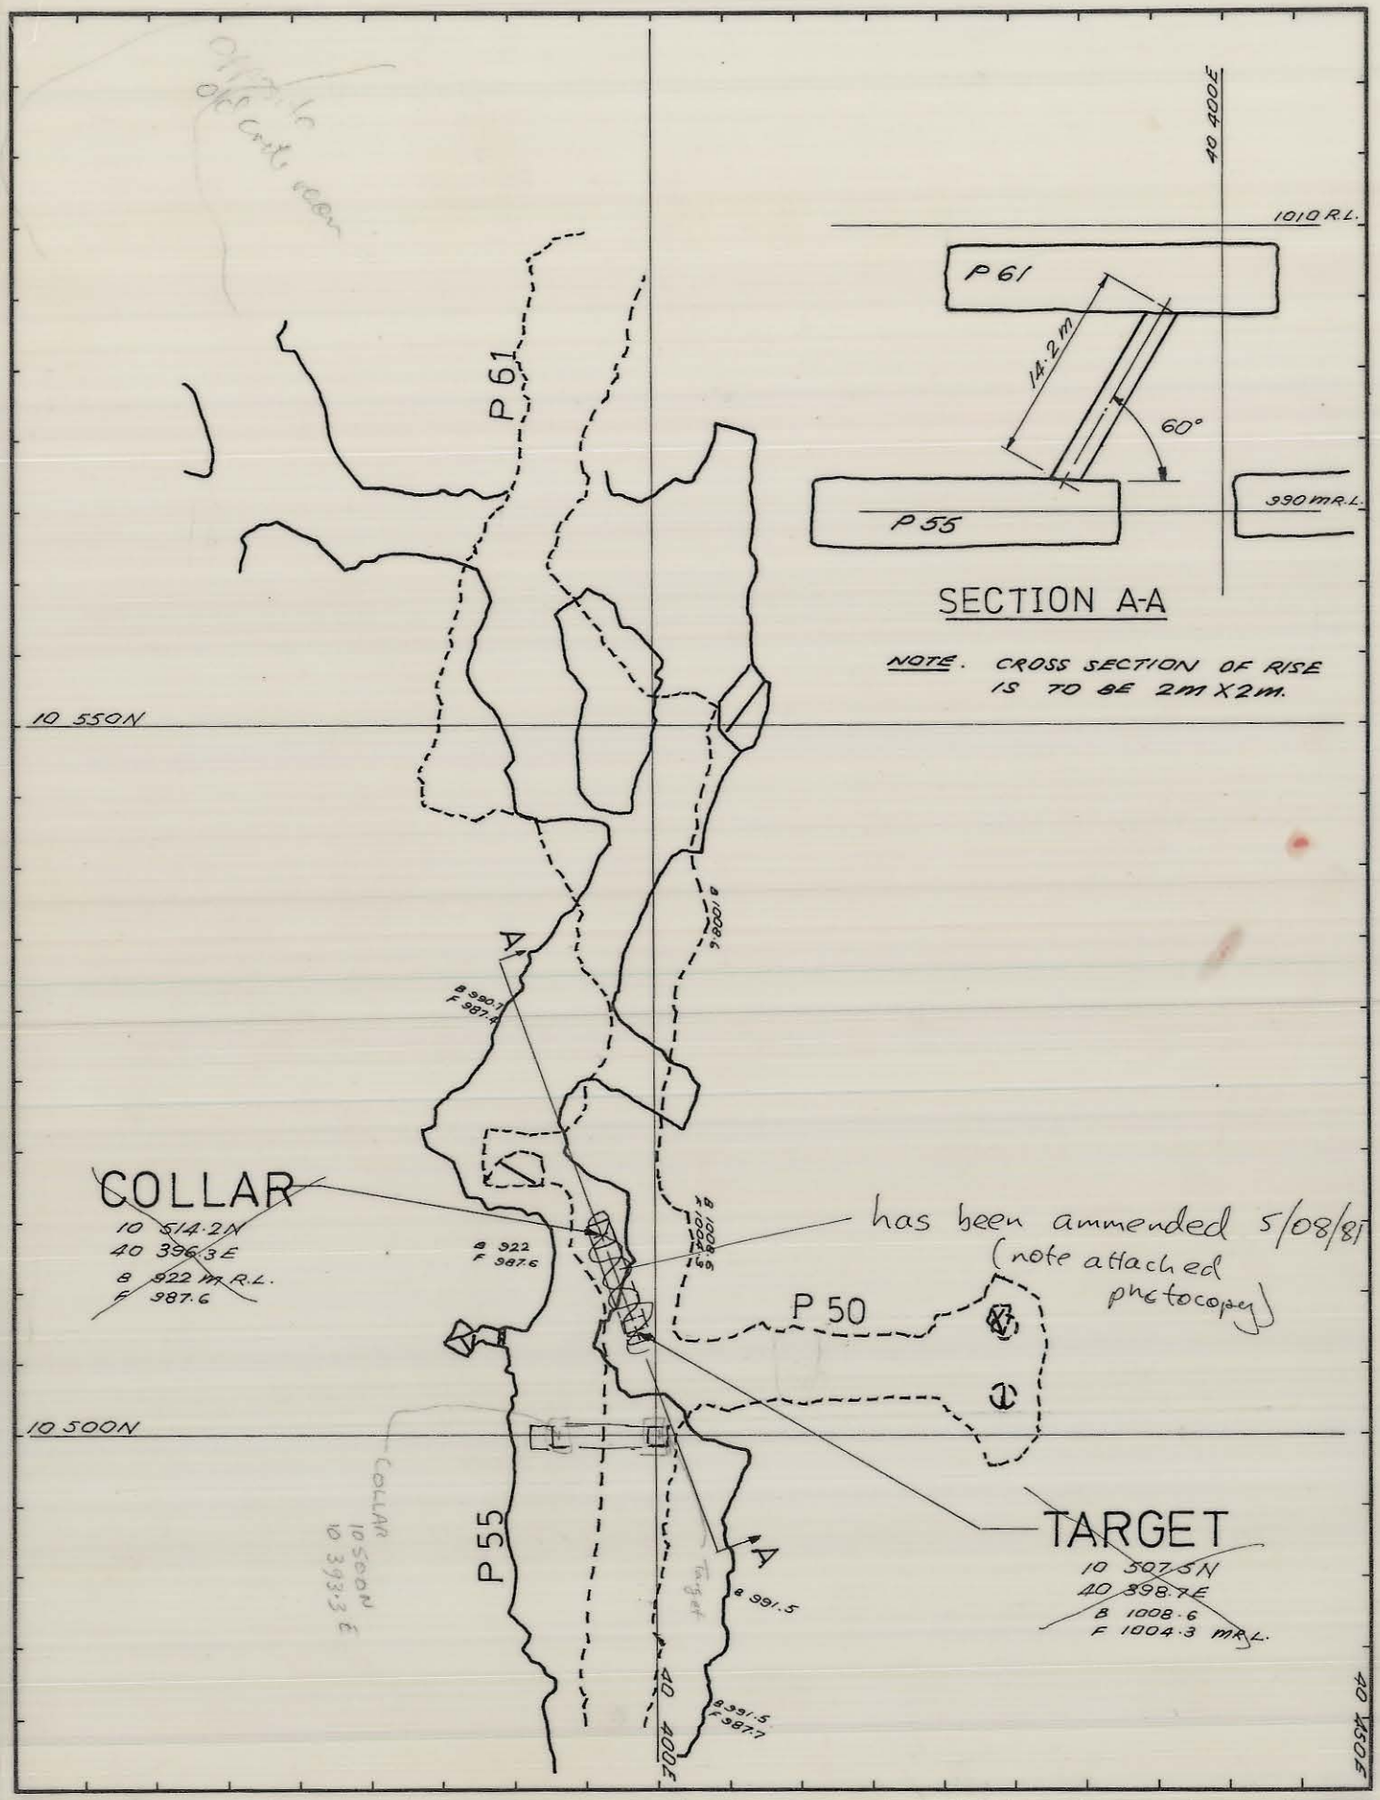


| REF. PLAN 04BH14-1004/1005. | GEOLOGY | | | 1 : 500 SCALE | KING ISLAND SCHEELITE GRASSY KING ISLAND |
|---|---|---|---|---|---|
| | SURVEY | | | BOLD HEAD MINE | |
| | PLANNING | P.B. | 24-7-81. | 051 VENT RETURN RISE | |
| | ROCK. MEC. | | | FROM P55 TO P61. | |
| | MINE SUPT. | Matt D | 6/08/81 | | |
| | G.M.S. | | | DRAWING NUMBER | |
| | T.S.S. | | | 03BH05 - 4008 | |