0374_3937

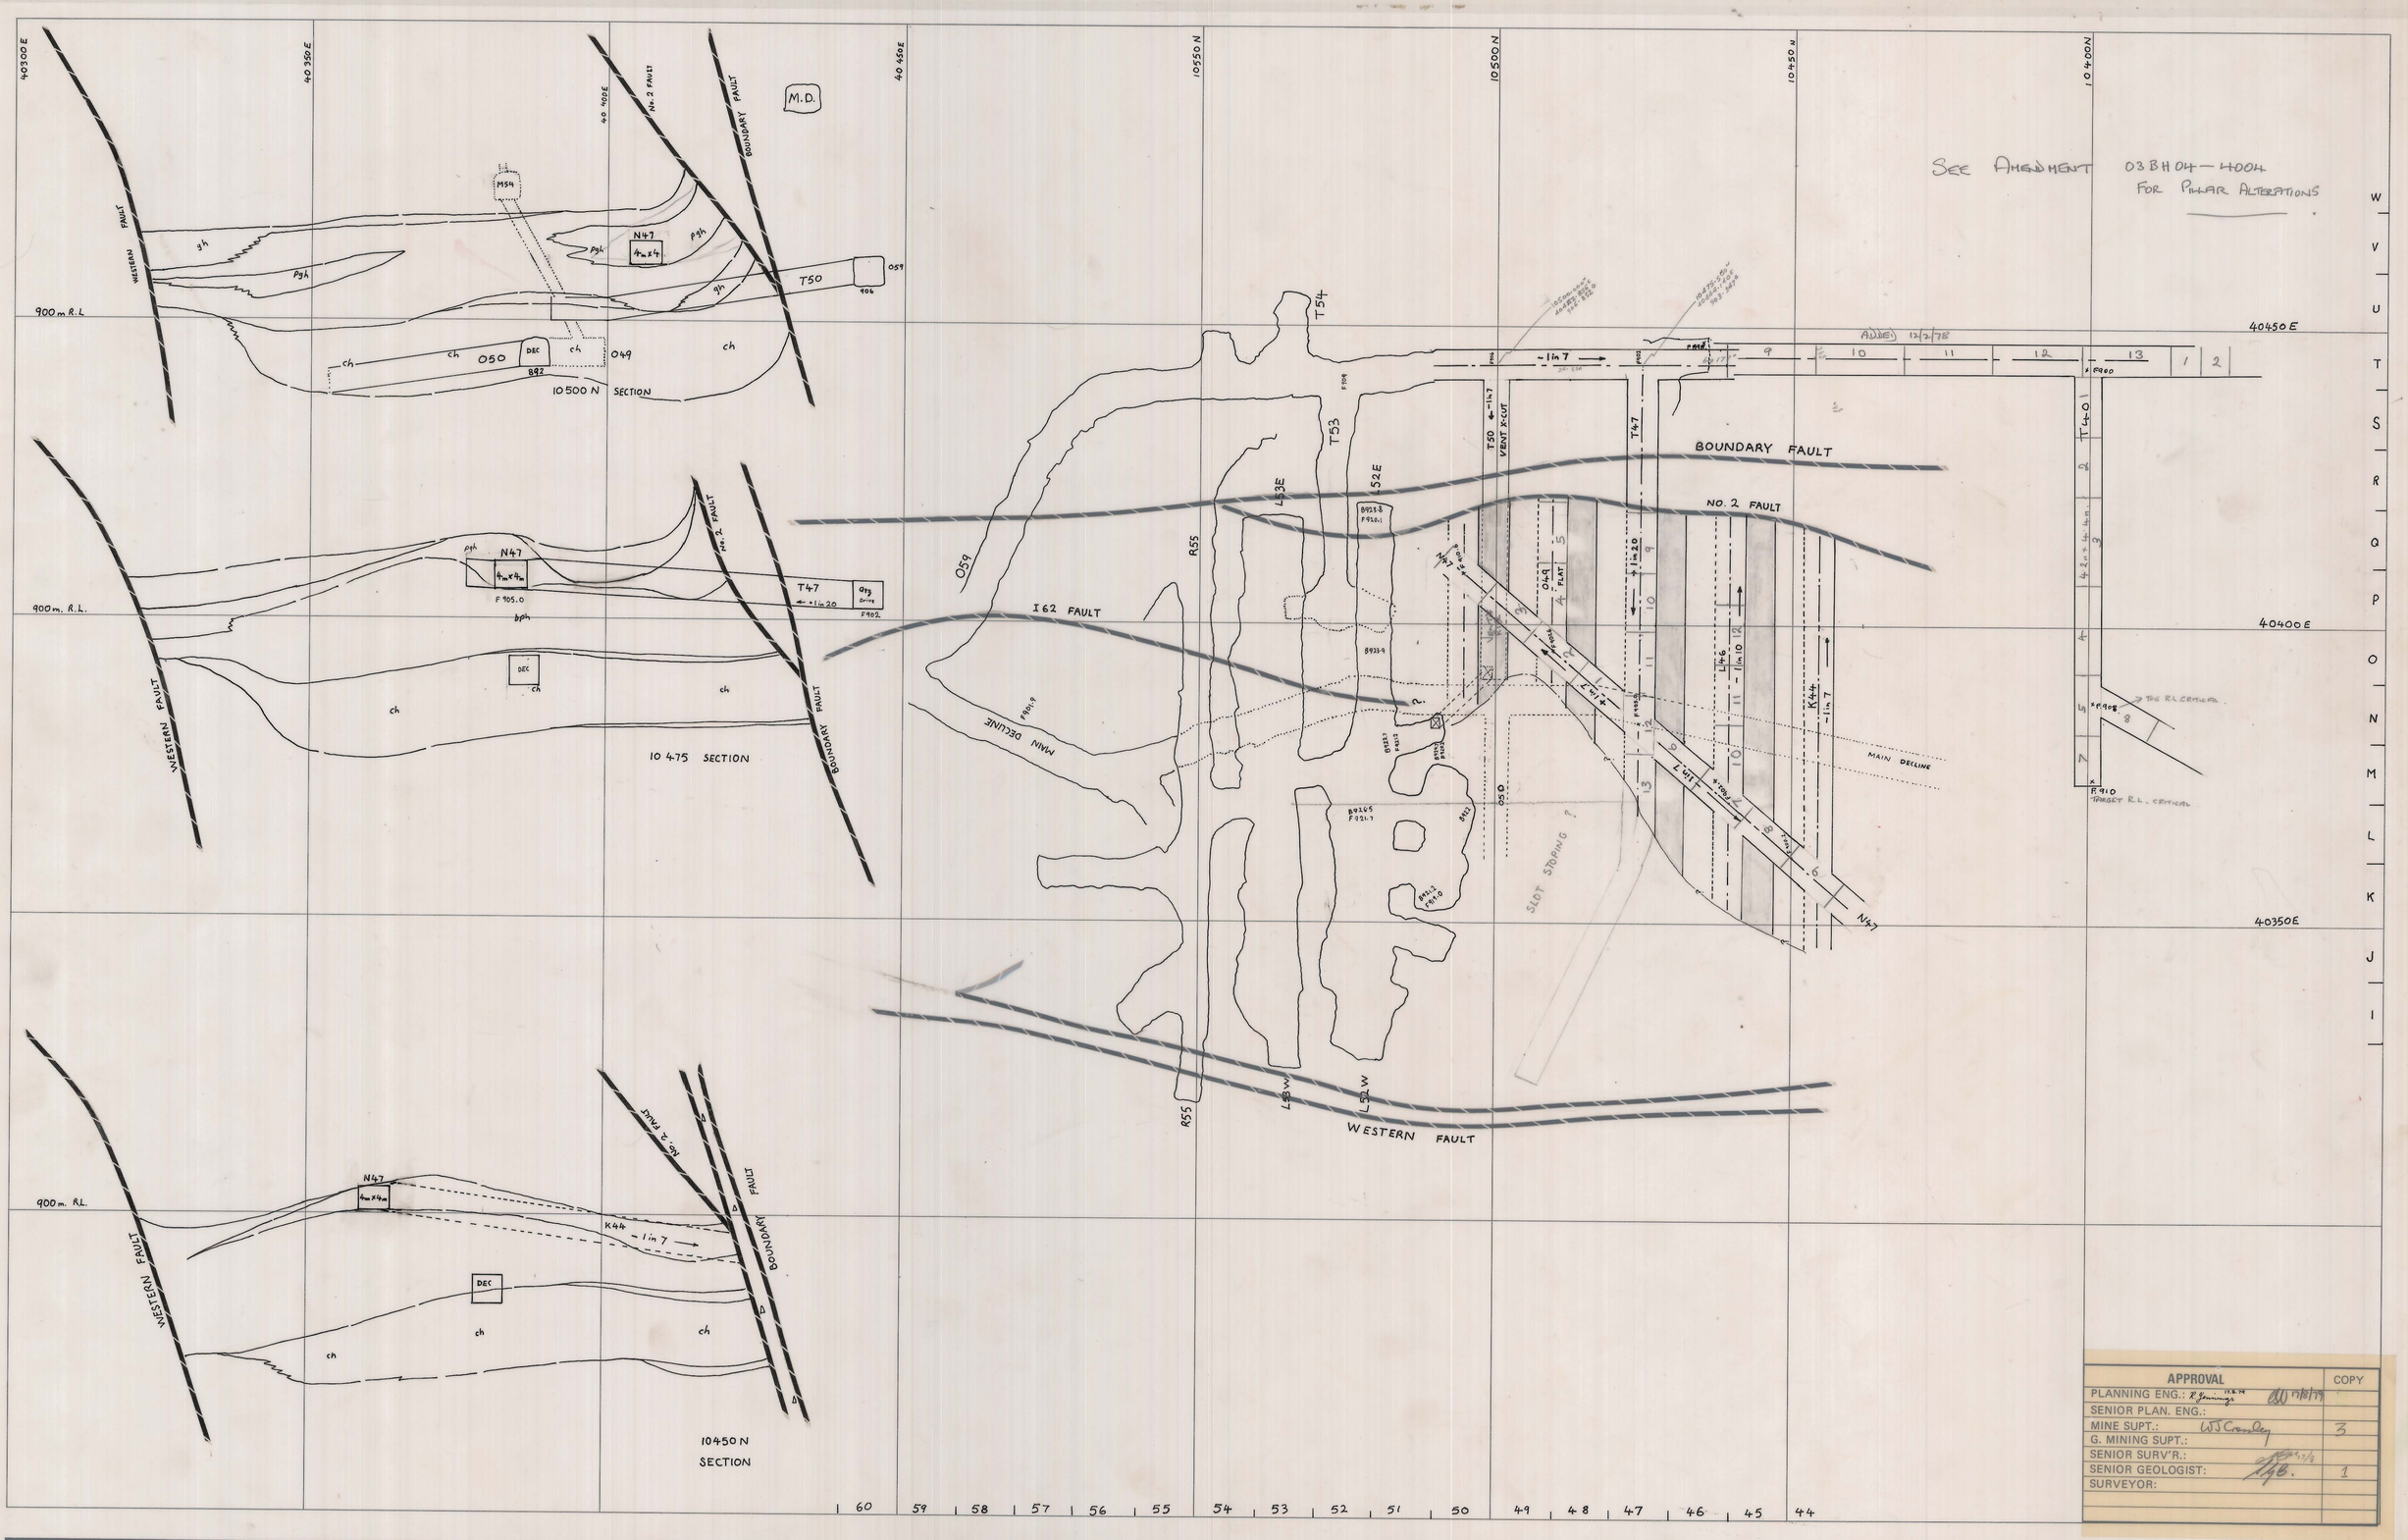

APPROVAL	COPY
PLANNING ENG.: R. Jennings 15.8.79	
SENIOR PLAN. ENG.:	
MINE SUPT.: WJ Crowley	3
G. MINING SUPT.:	
SENIOR SURV'R.:	
SENIOR GEOLOGIST:	1
SURVEYOR:	

SCALE 1:500

See 03BH03-4004 for revisions in T47 area
ref. 03BH04-1007 for 059 rounds

north

LOCATION: BOLD HEAD

SUBJECT: LOWER C'I'LENS DEVELOPMENT

KING ISLAND SCHEELITE
A DIVISION OF WARMAN INTERNATIONAL

GRASSY KING ISLAND

PLAN NUMBER 03BH04-1008