27 JUN 1981

5 cm

03 BH 07 1023

0374_3987

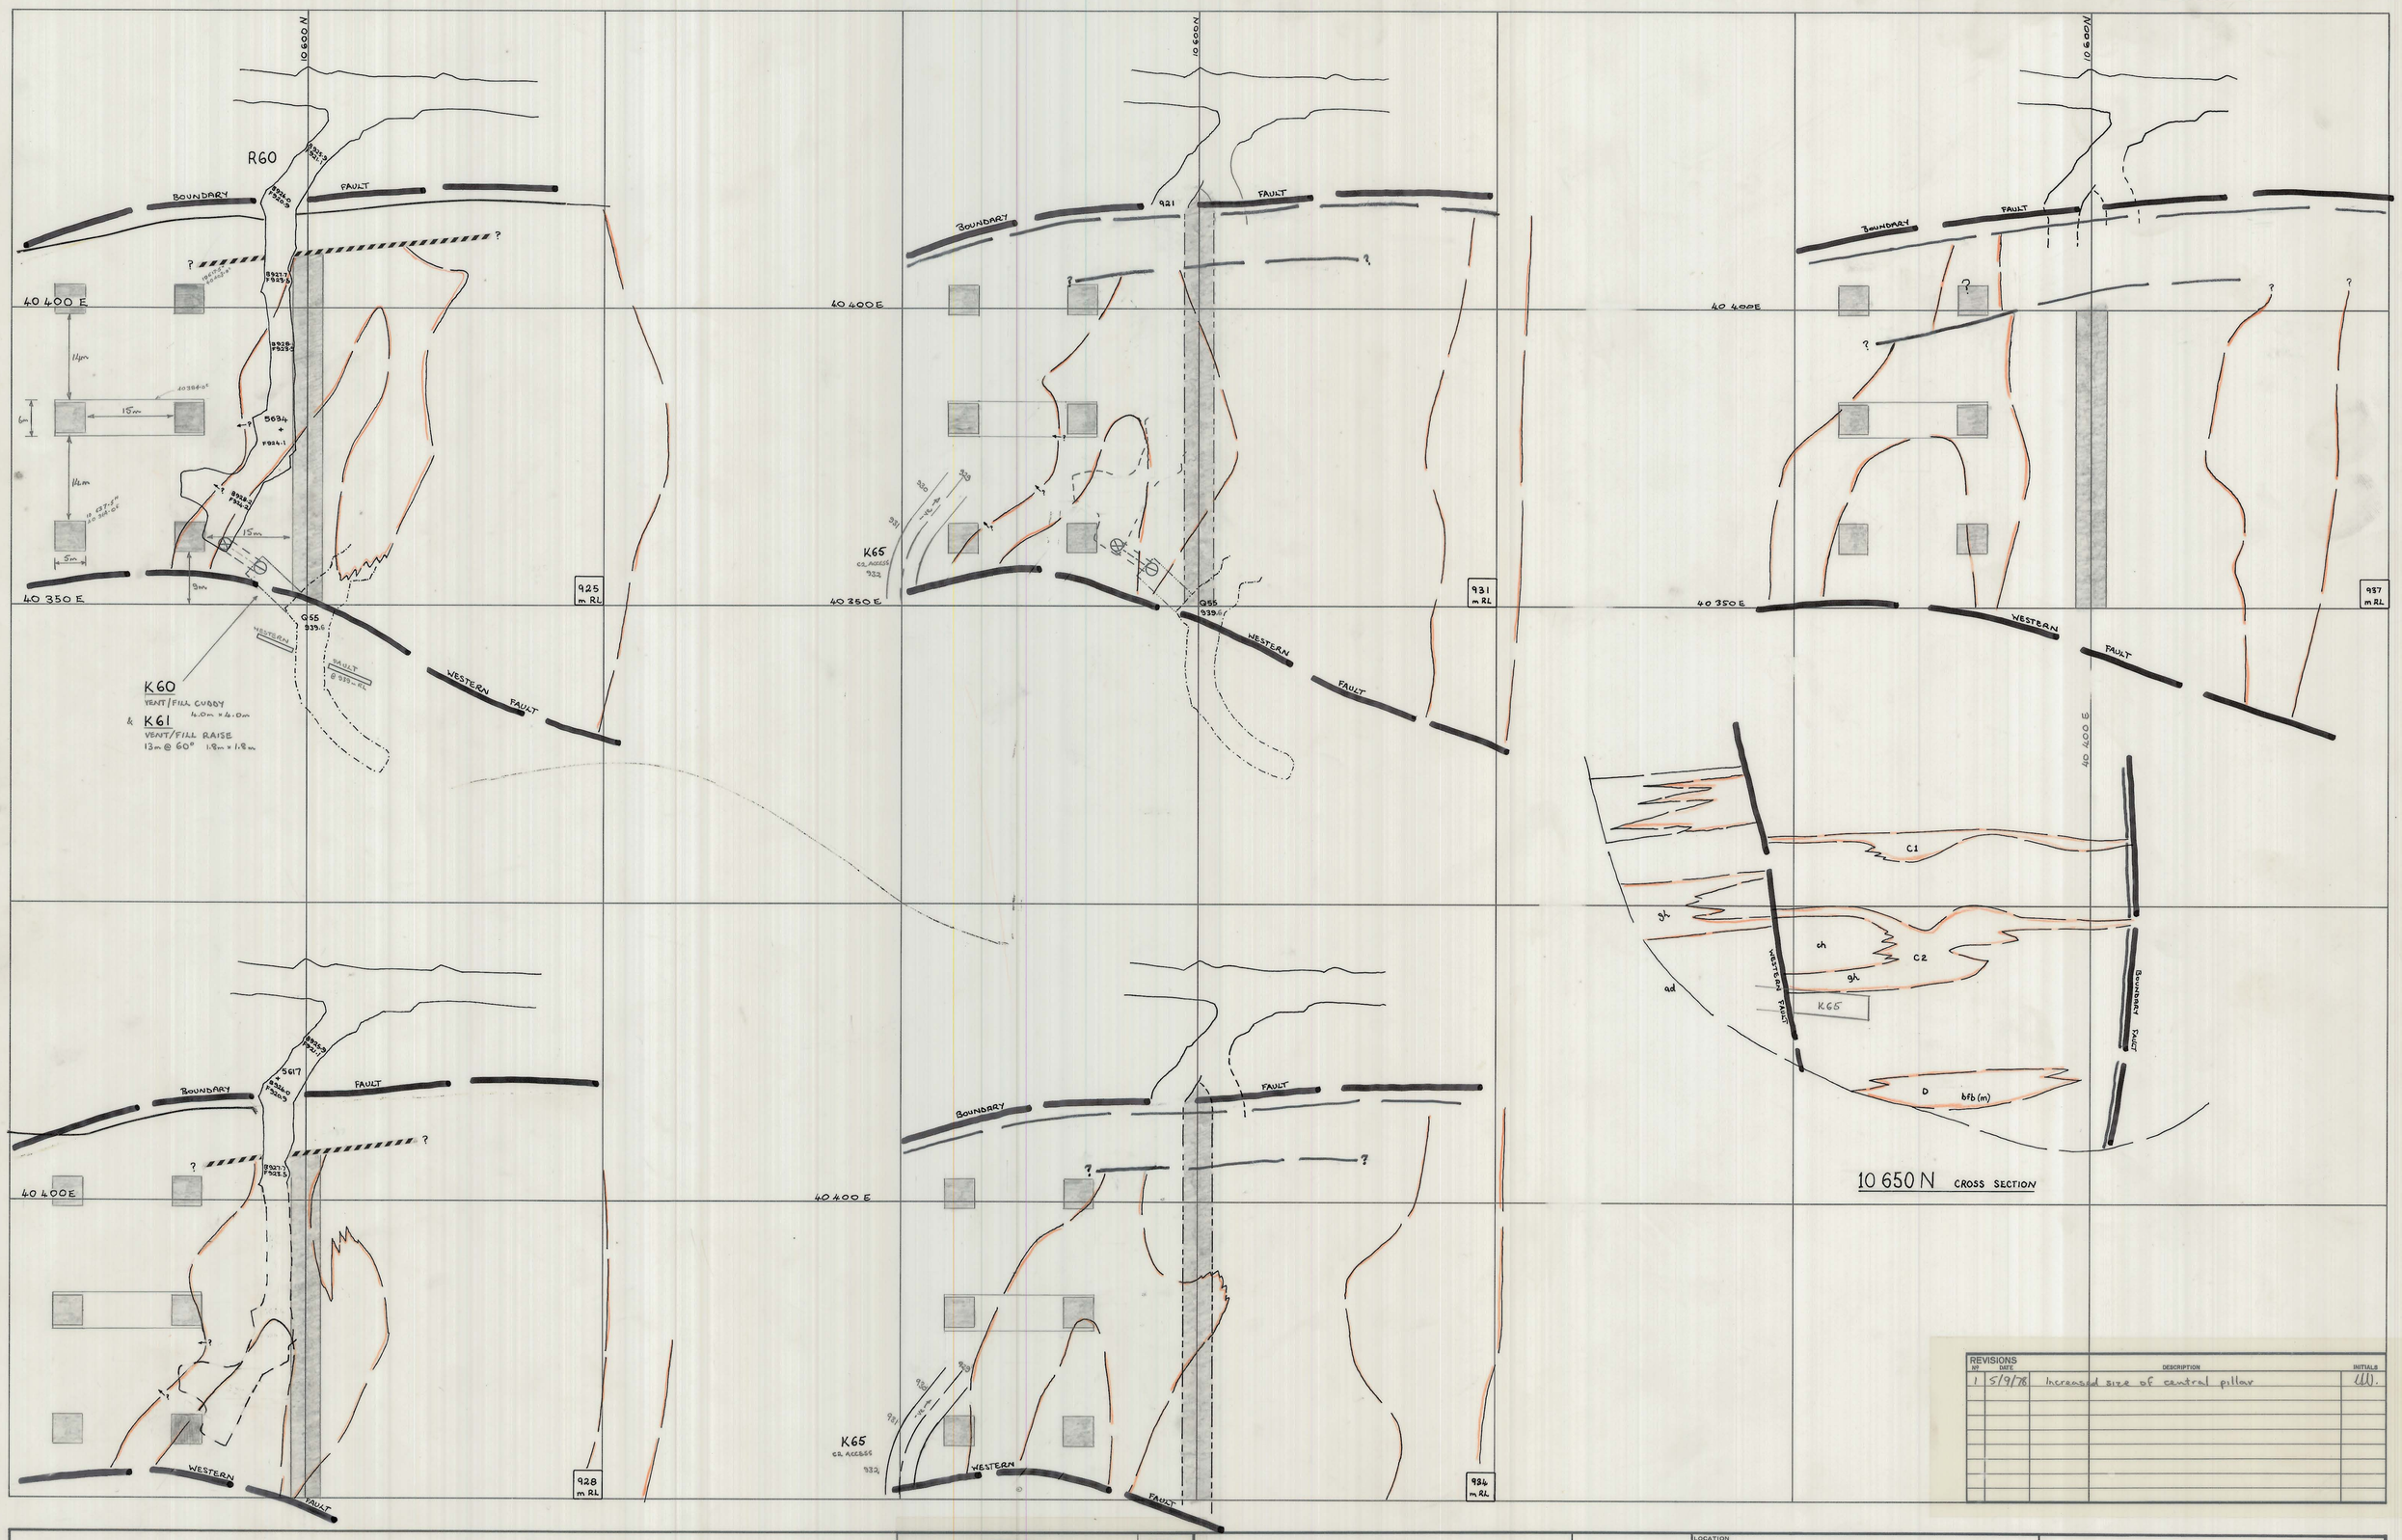

REVISIONS NO.	DATE	DESCRIPTION	INITIALS
1	5/9/78	Increased size of central pillar	W.

Explanation:- Undercutting is to take place on either side of the Central Pillar in order to determine the extent of the Orebody prior to mining through the Pillar. The Pillar may be trimmed once full extent of Orebody is known.

APPROVAL		COPY
PLANNING ENG.:	22/8/78	
SENIOR PLAN. ENG.:	ABSENT	
MINE SUPT.:	23/8/78	2
G. MINING SUPT.:	24/8/78	
SENIOR SURV'R.:	24/8/78	
SENIOR GEOLOGIST:	24.8.78	
SURVEYOR:	5.10.78	

SCALE 1:500

Approx. Tonnes between 600N & 650N	57 000
Approx. Tonnes tied up in pillars	9 000
Available Tonnes	48 000
	(84% Recovery)

N.B. GEOLOGY IS VERY APPROXIMATE — PLANS NOT SUPPLIED BY GEOLOGIST.

LOCATION: BOLD HEAD MINE

SUBJECT: PROPOSE LAYOUT FOR — R60 STOPING — C2 LENS

KING ISLAND SCHEELITE
A DIVISION OF WARMAN INTERNATIONAL

GRASSY — KING ISLAND

14 AUGUST 1978

PLAN NUMBER: 03 BH 07 - 1023