27 JUN 1981

0374 - 399

04DM15 - 1014
sections above 1987

101

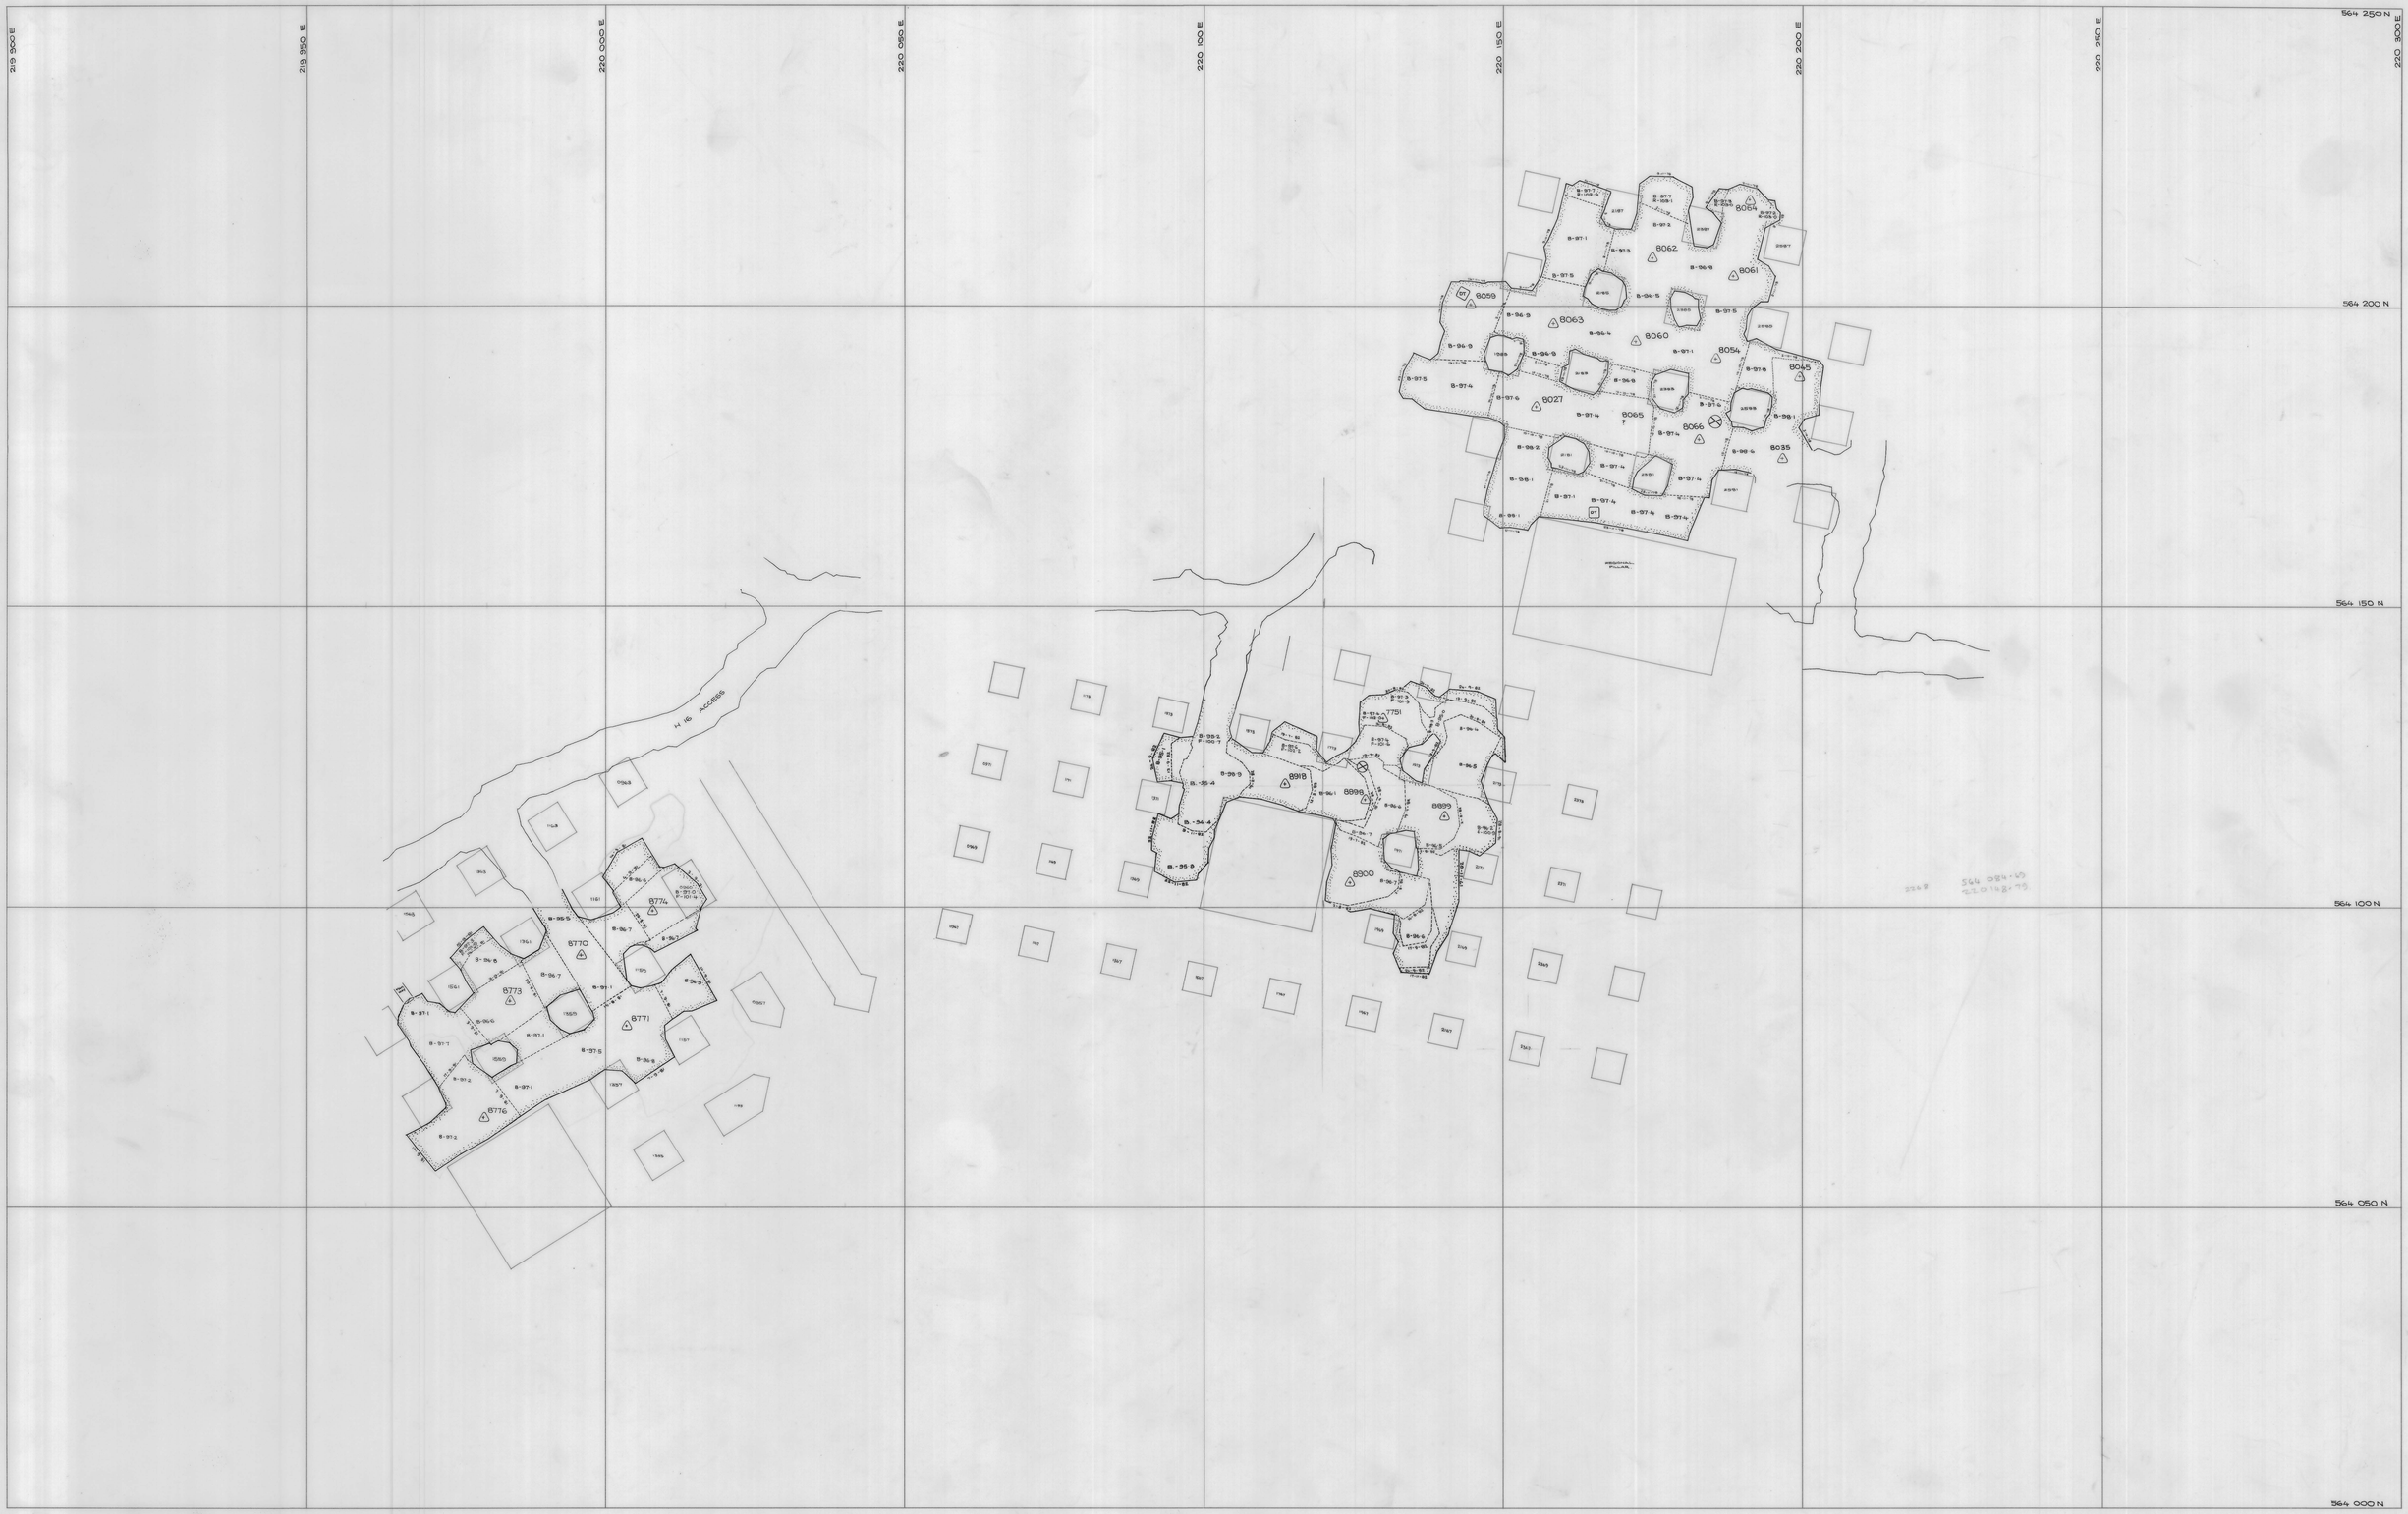

SCALE 1:500

C WEDGE STOPE - LIFT Nº 9
C CENTRAL STOPE - LIFT Nº 14
C PIT STOPE - LIFT Nº 15

5 cm

north

LOCATION: DOLPHIN MINE

SUBJECT: C WEDGE STOPE -101 m CONTOUR
PIT -100m CONTOUR
CENTRAL

KINGS KING ISLAND SCHEELITE
A DIVISION OF WARMAN INTERNATIONAL

GRASSY KING ISLAND

PLAN NUMBER 04DM15 - 1014