5 cm

0374_4002
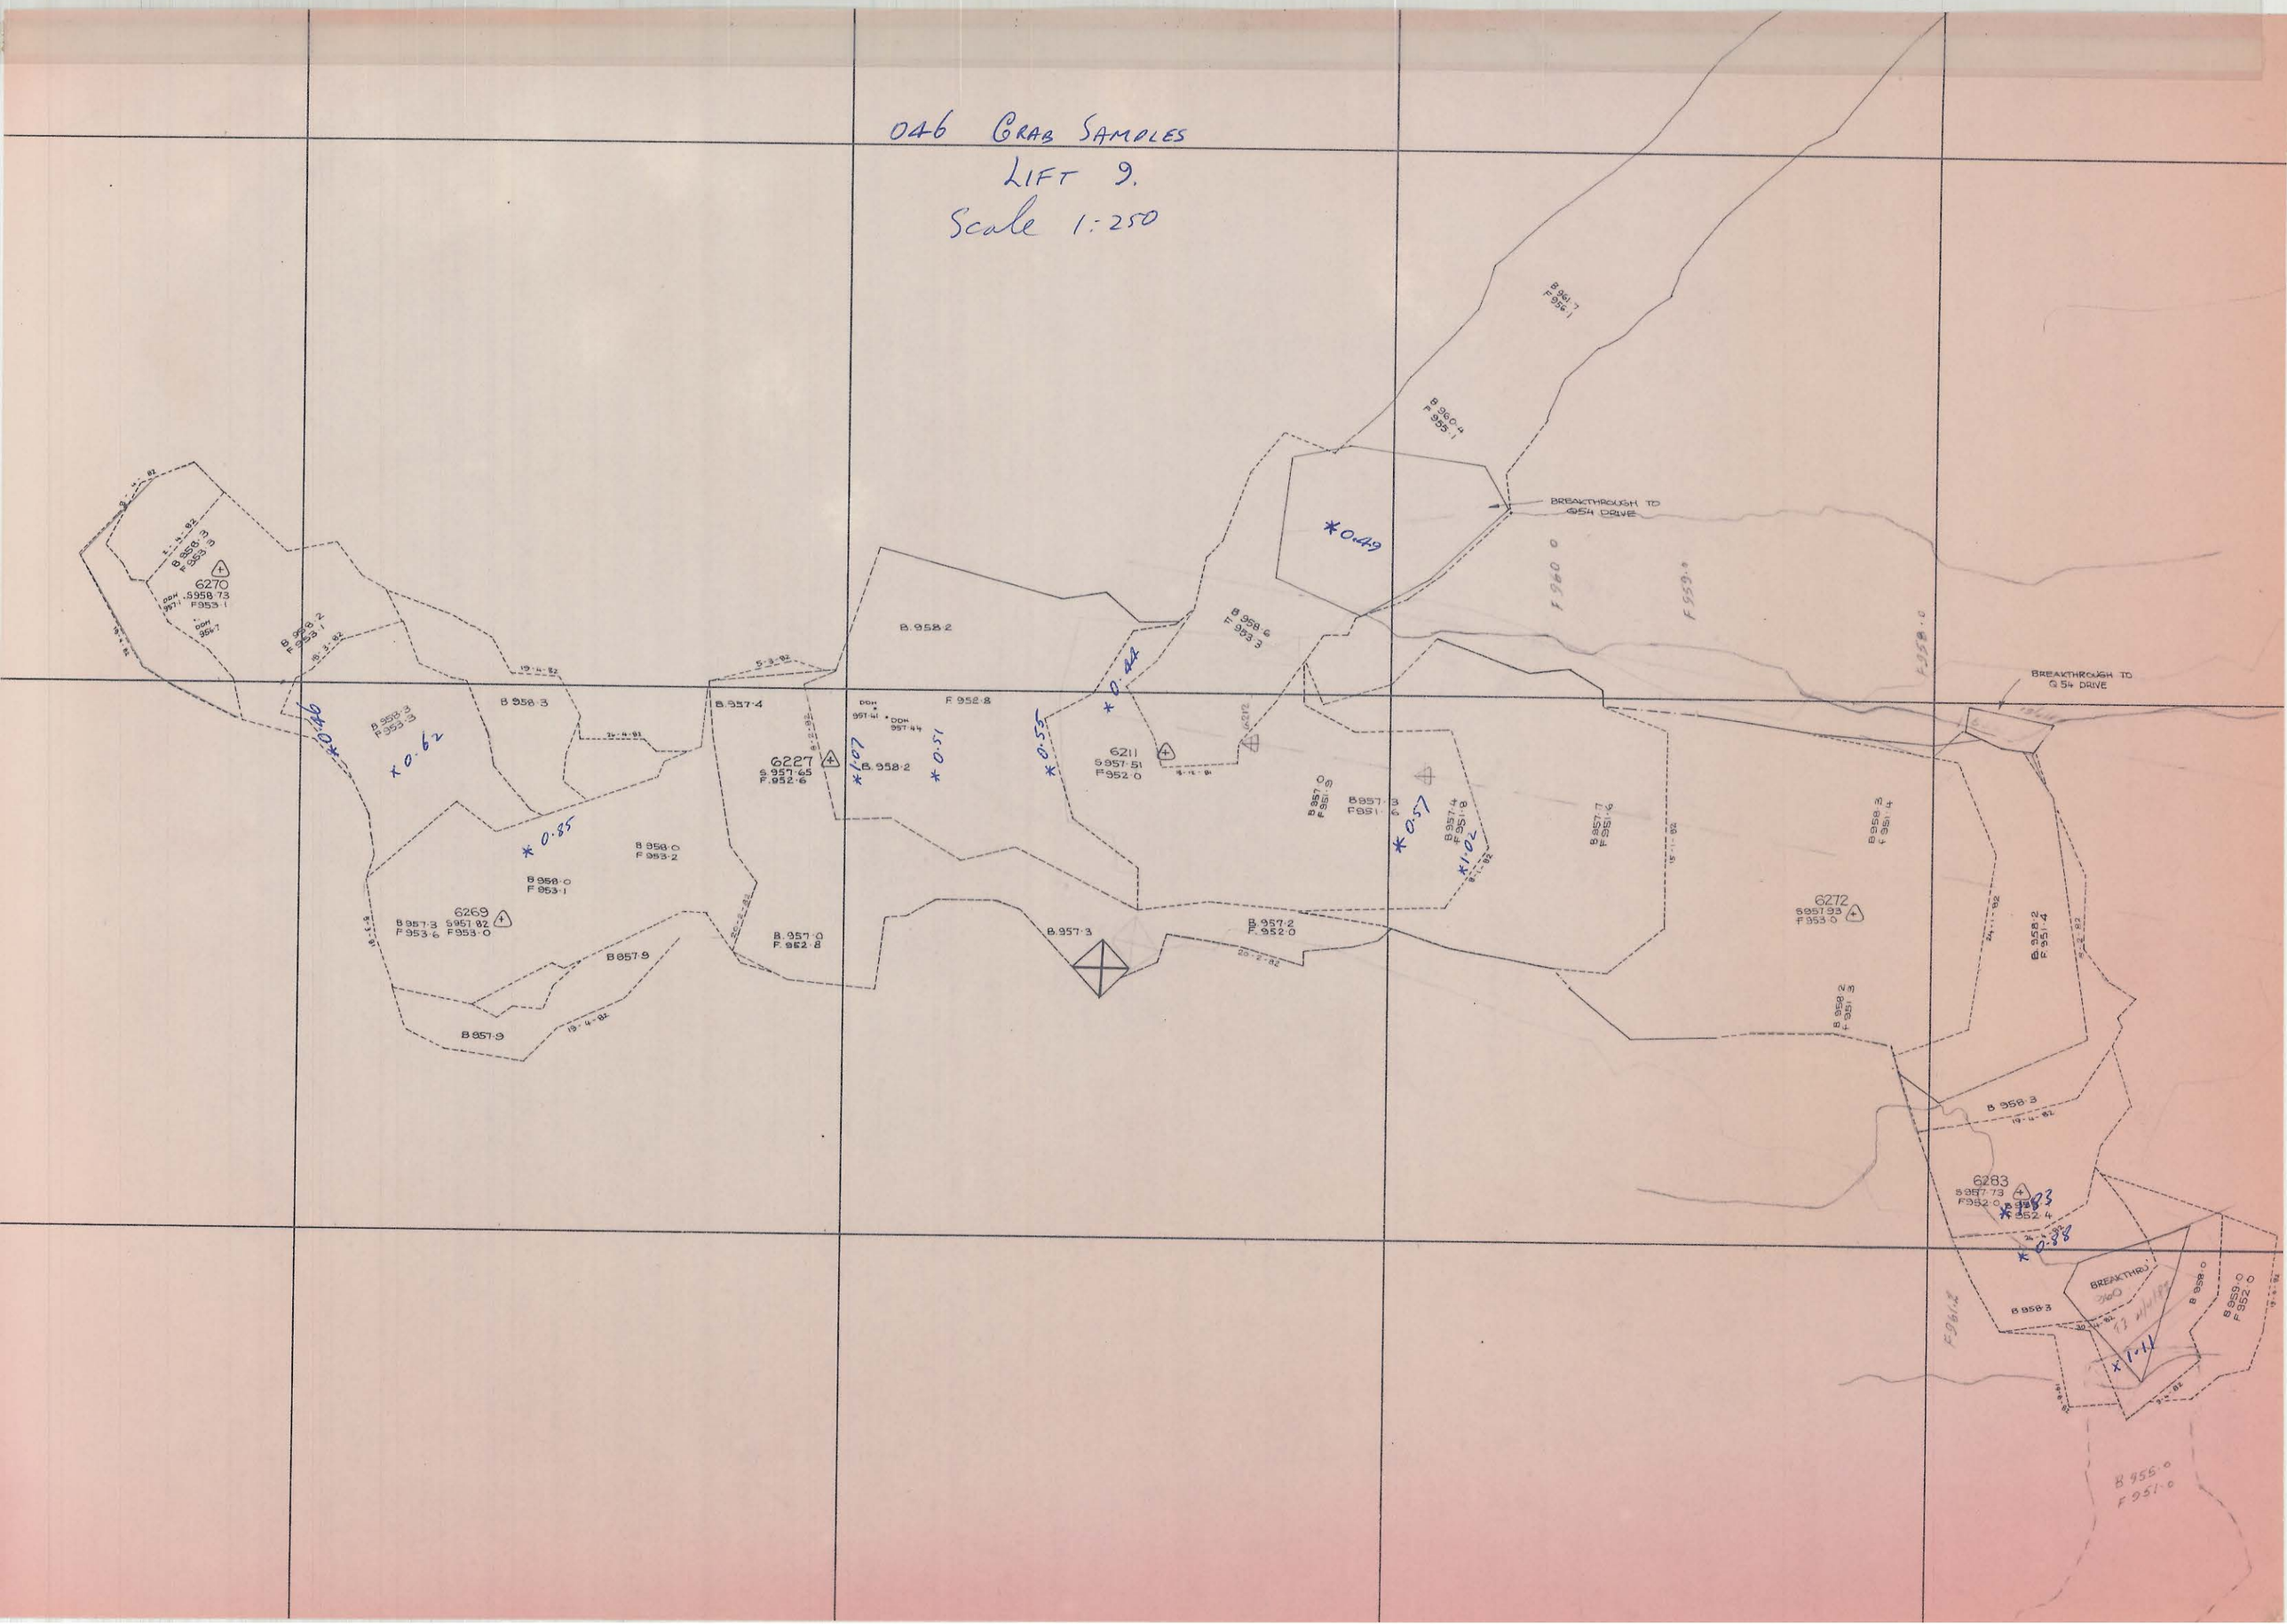
046 LIFT 9
GRAB SAMPLES