27 JUN 1981

0324 - 401

04DM15 - 1016.
SECTIONS DONE 1987

107

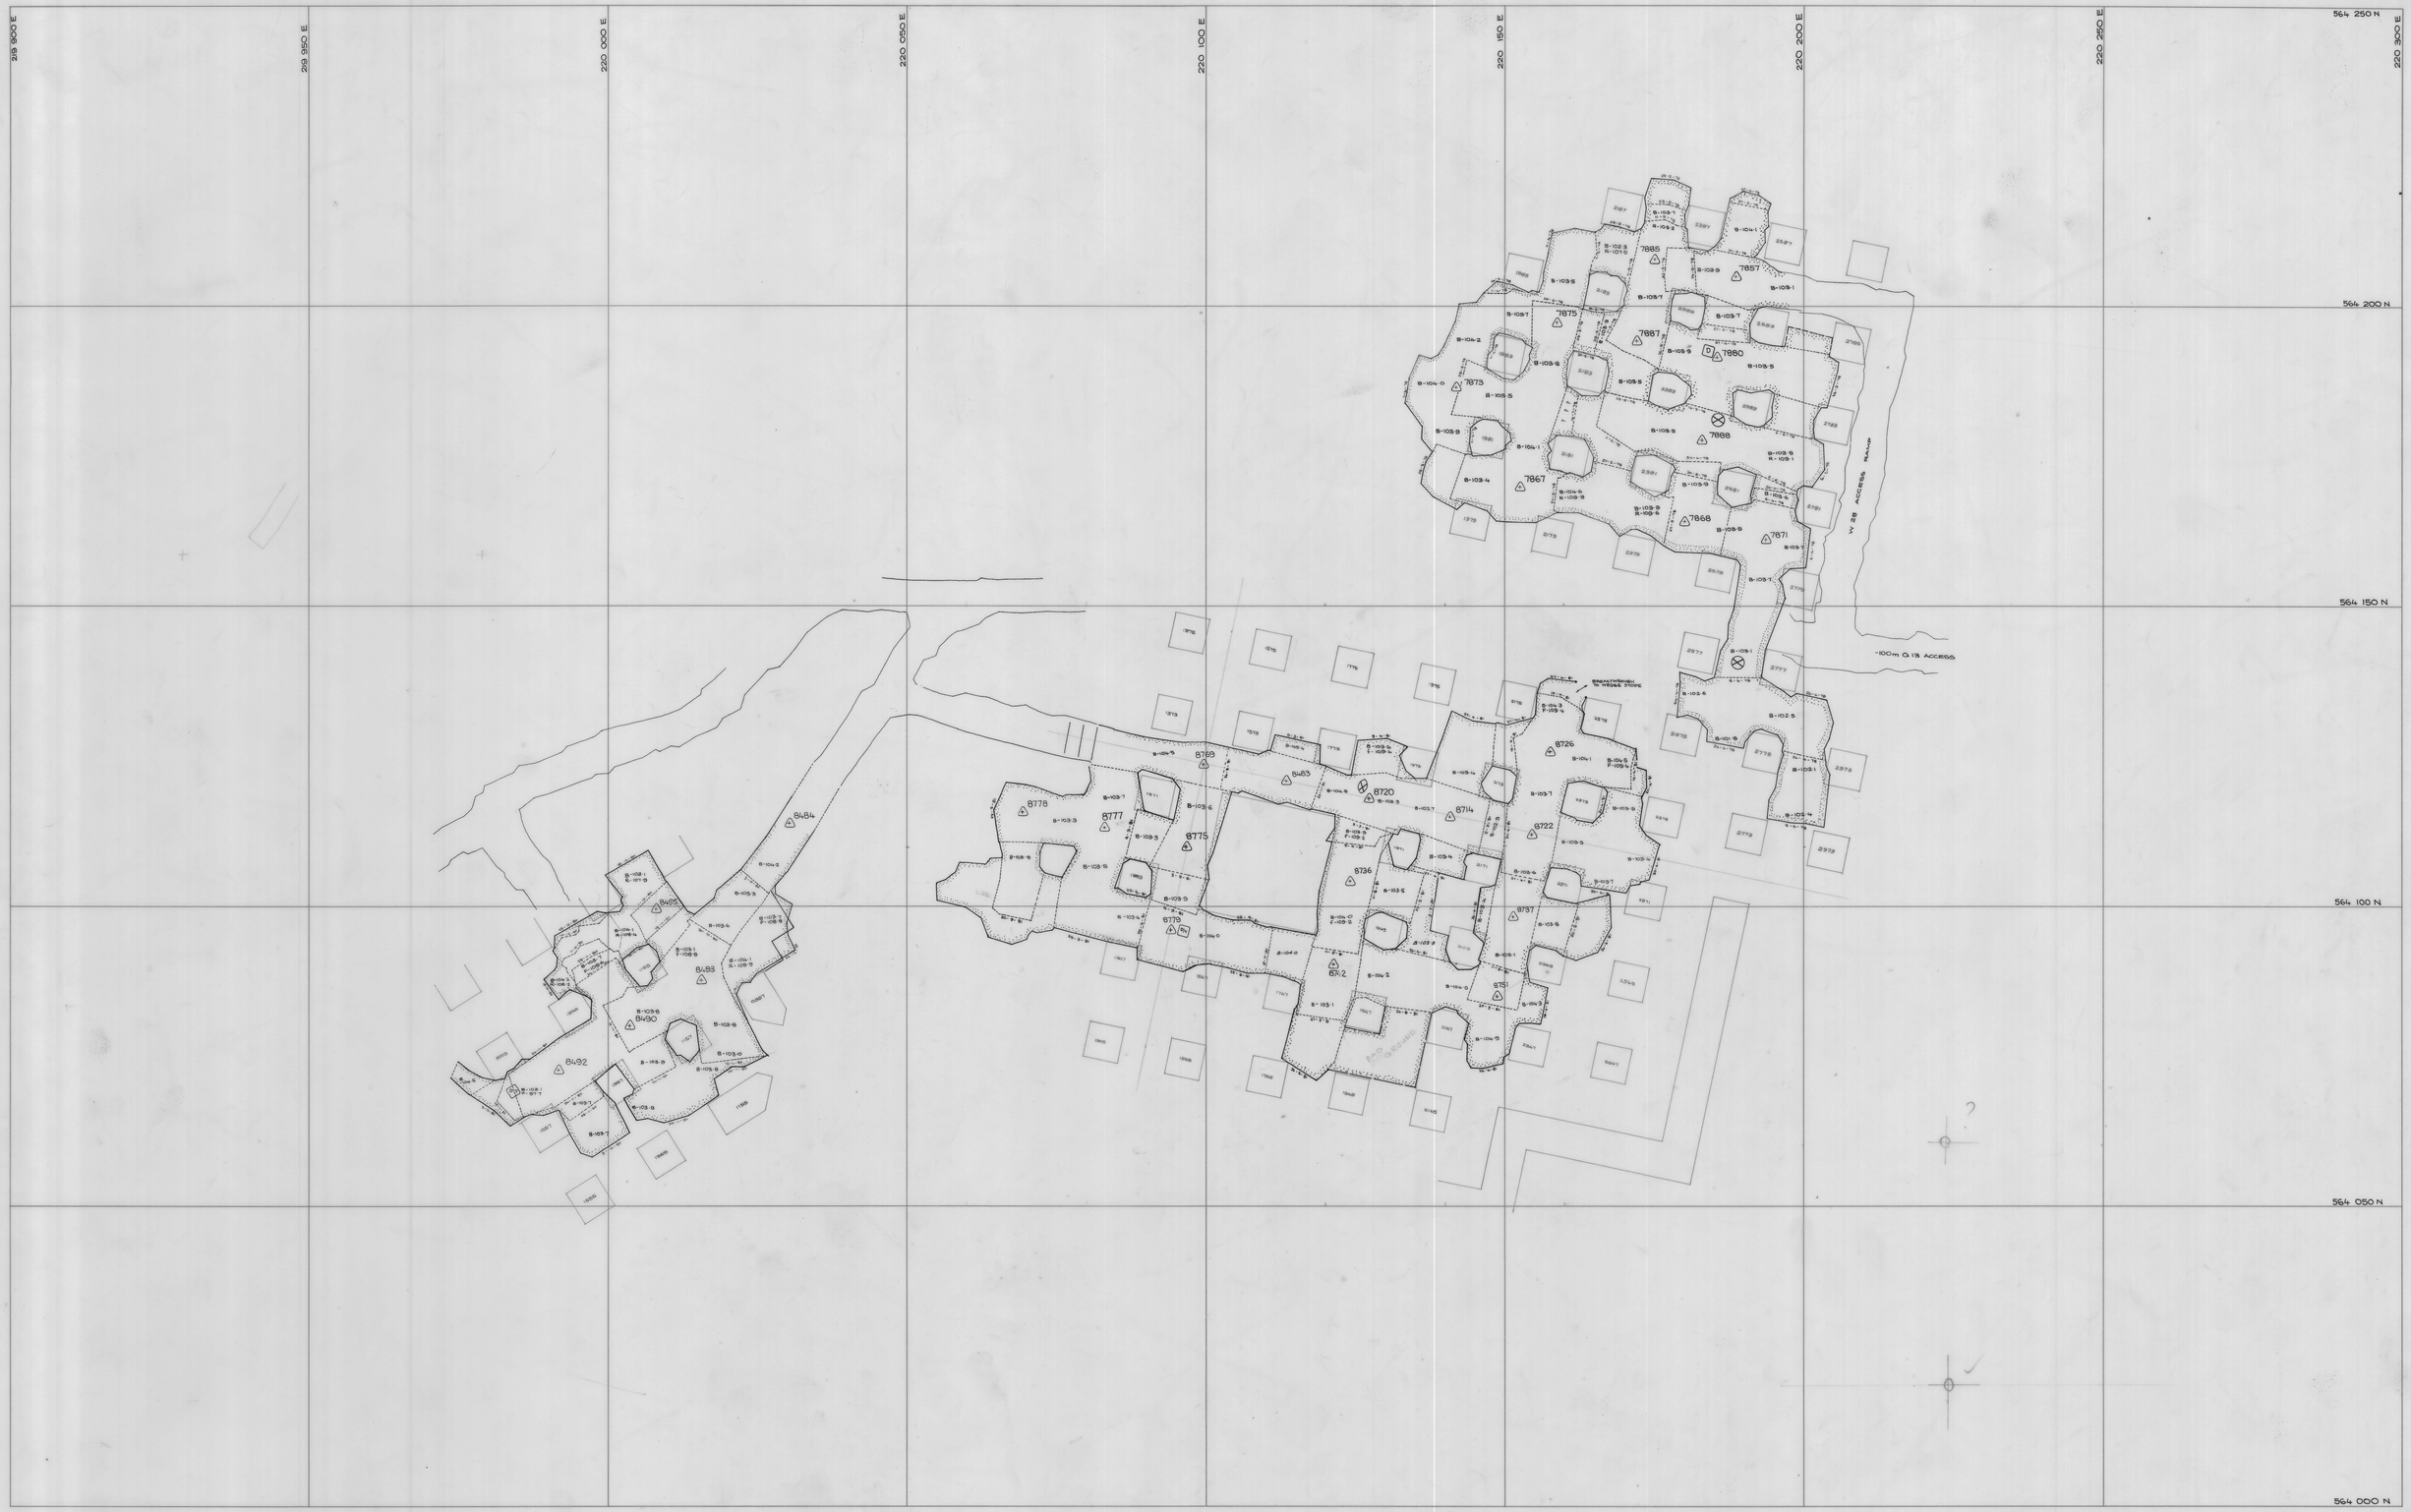

SCALE 1:500		LOCATION: DOLPHIN MINE	KING ISLAND SCHEELITE — A DIVISION OF WARMAN INTERNATIONAL
C Wedge Stope - Lift Nº 7 - -107m Contour C Central Stope - Lift Nº 12 - -107m Contour C. Pit Stope - Lift Nº 13 - -107m Contour 5 cm	north	SUBJECT: C WEDGE STOPE -107m CONTOUR PIT CENTRAL upper lower	GRASSY KING ISLAND PLAN NUMBER: 04DM15 - 1016