0374_4030

5 cm
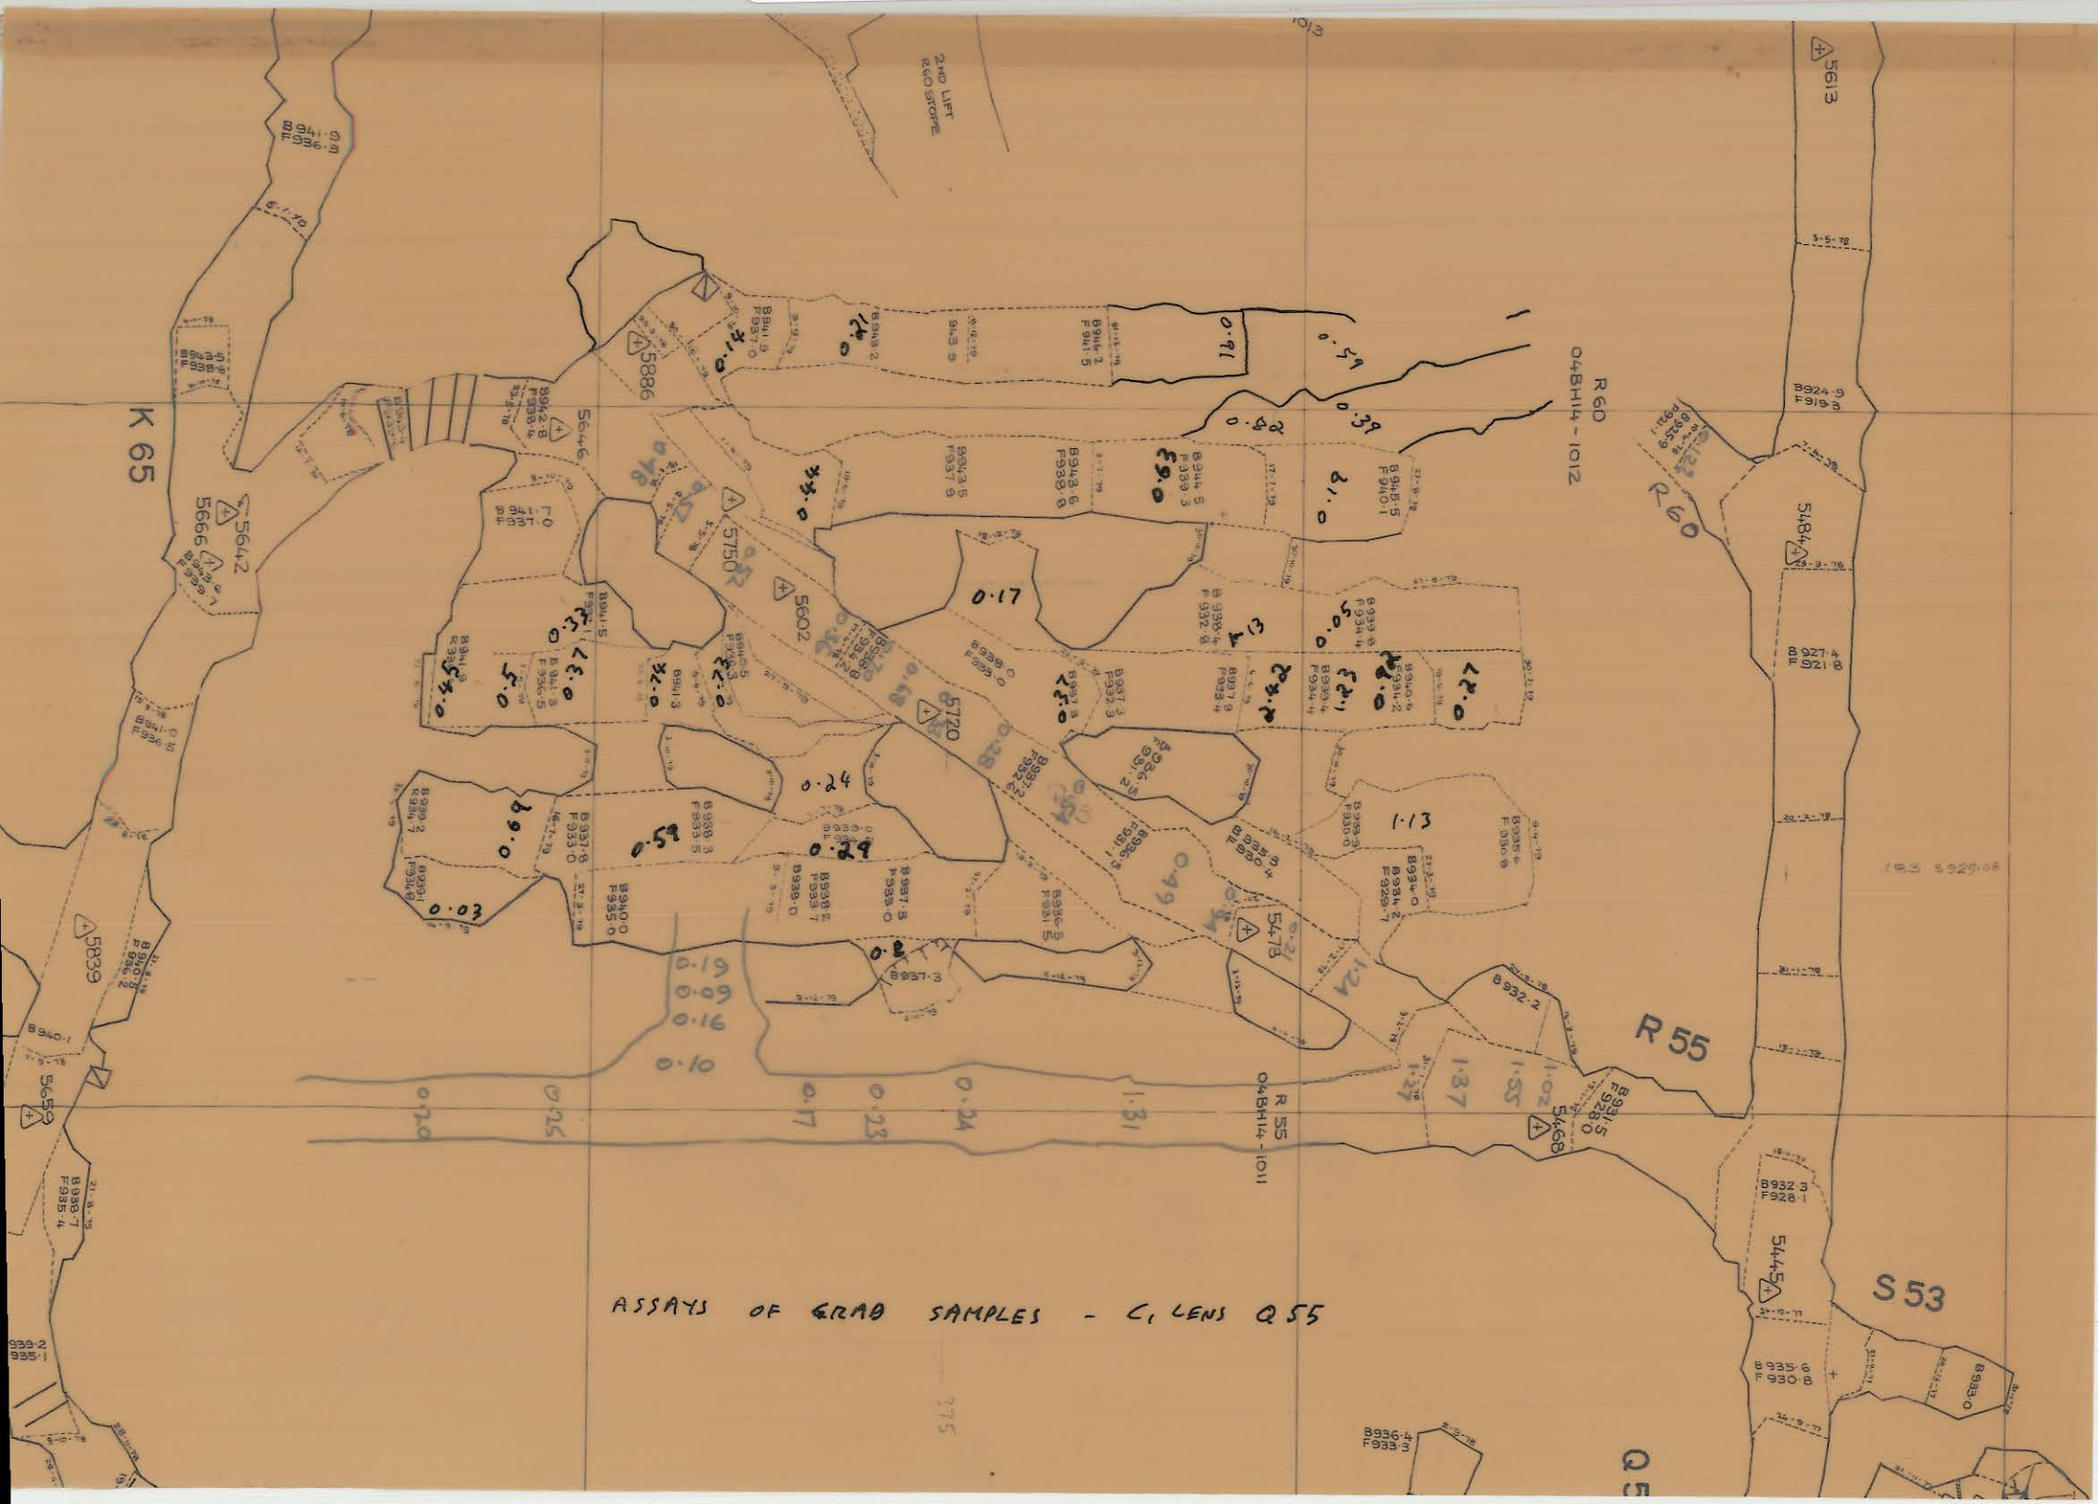
Q55
C LENS
UNDERCUT