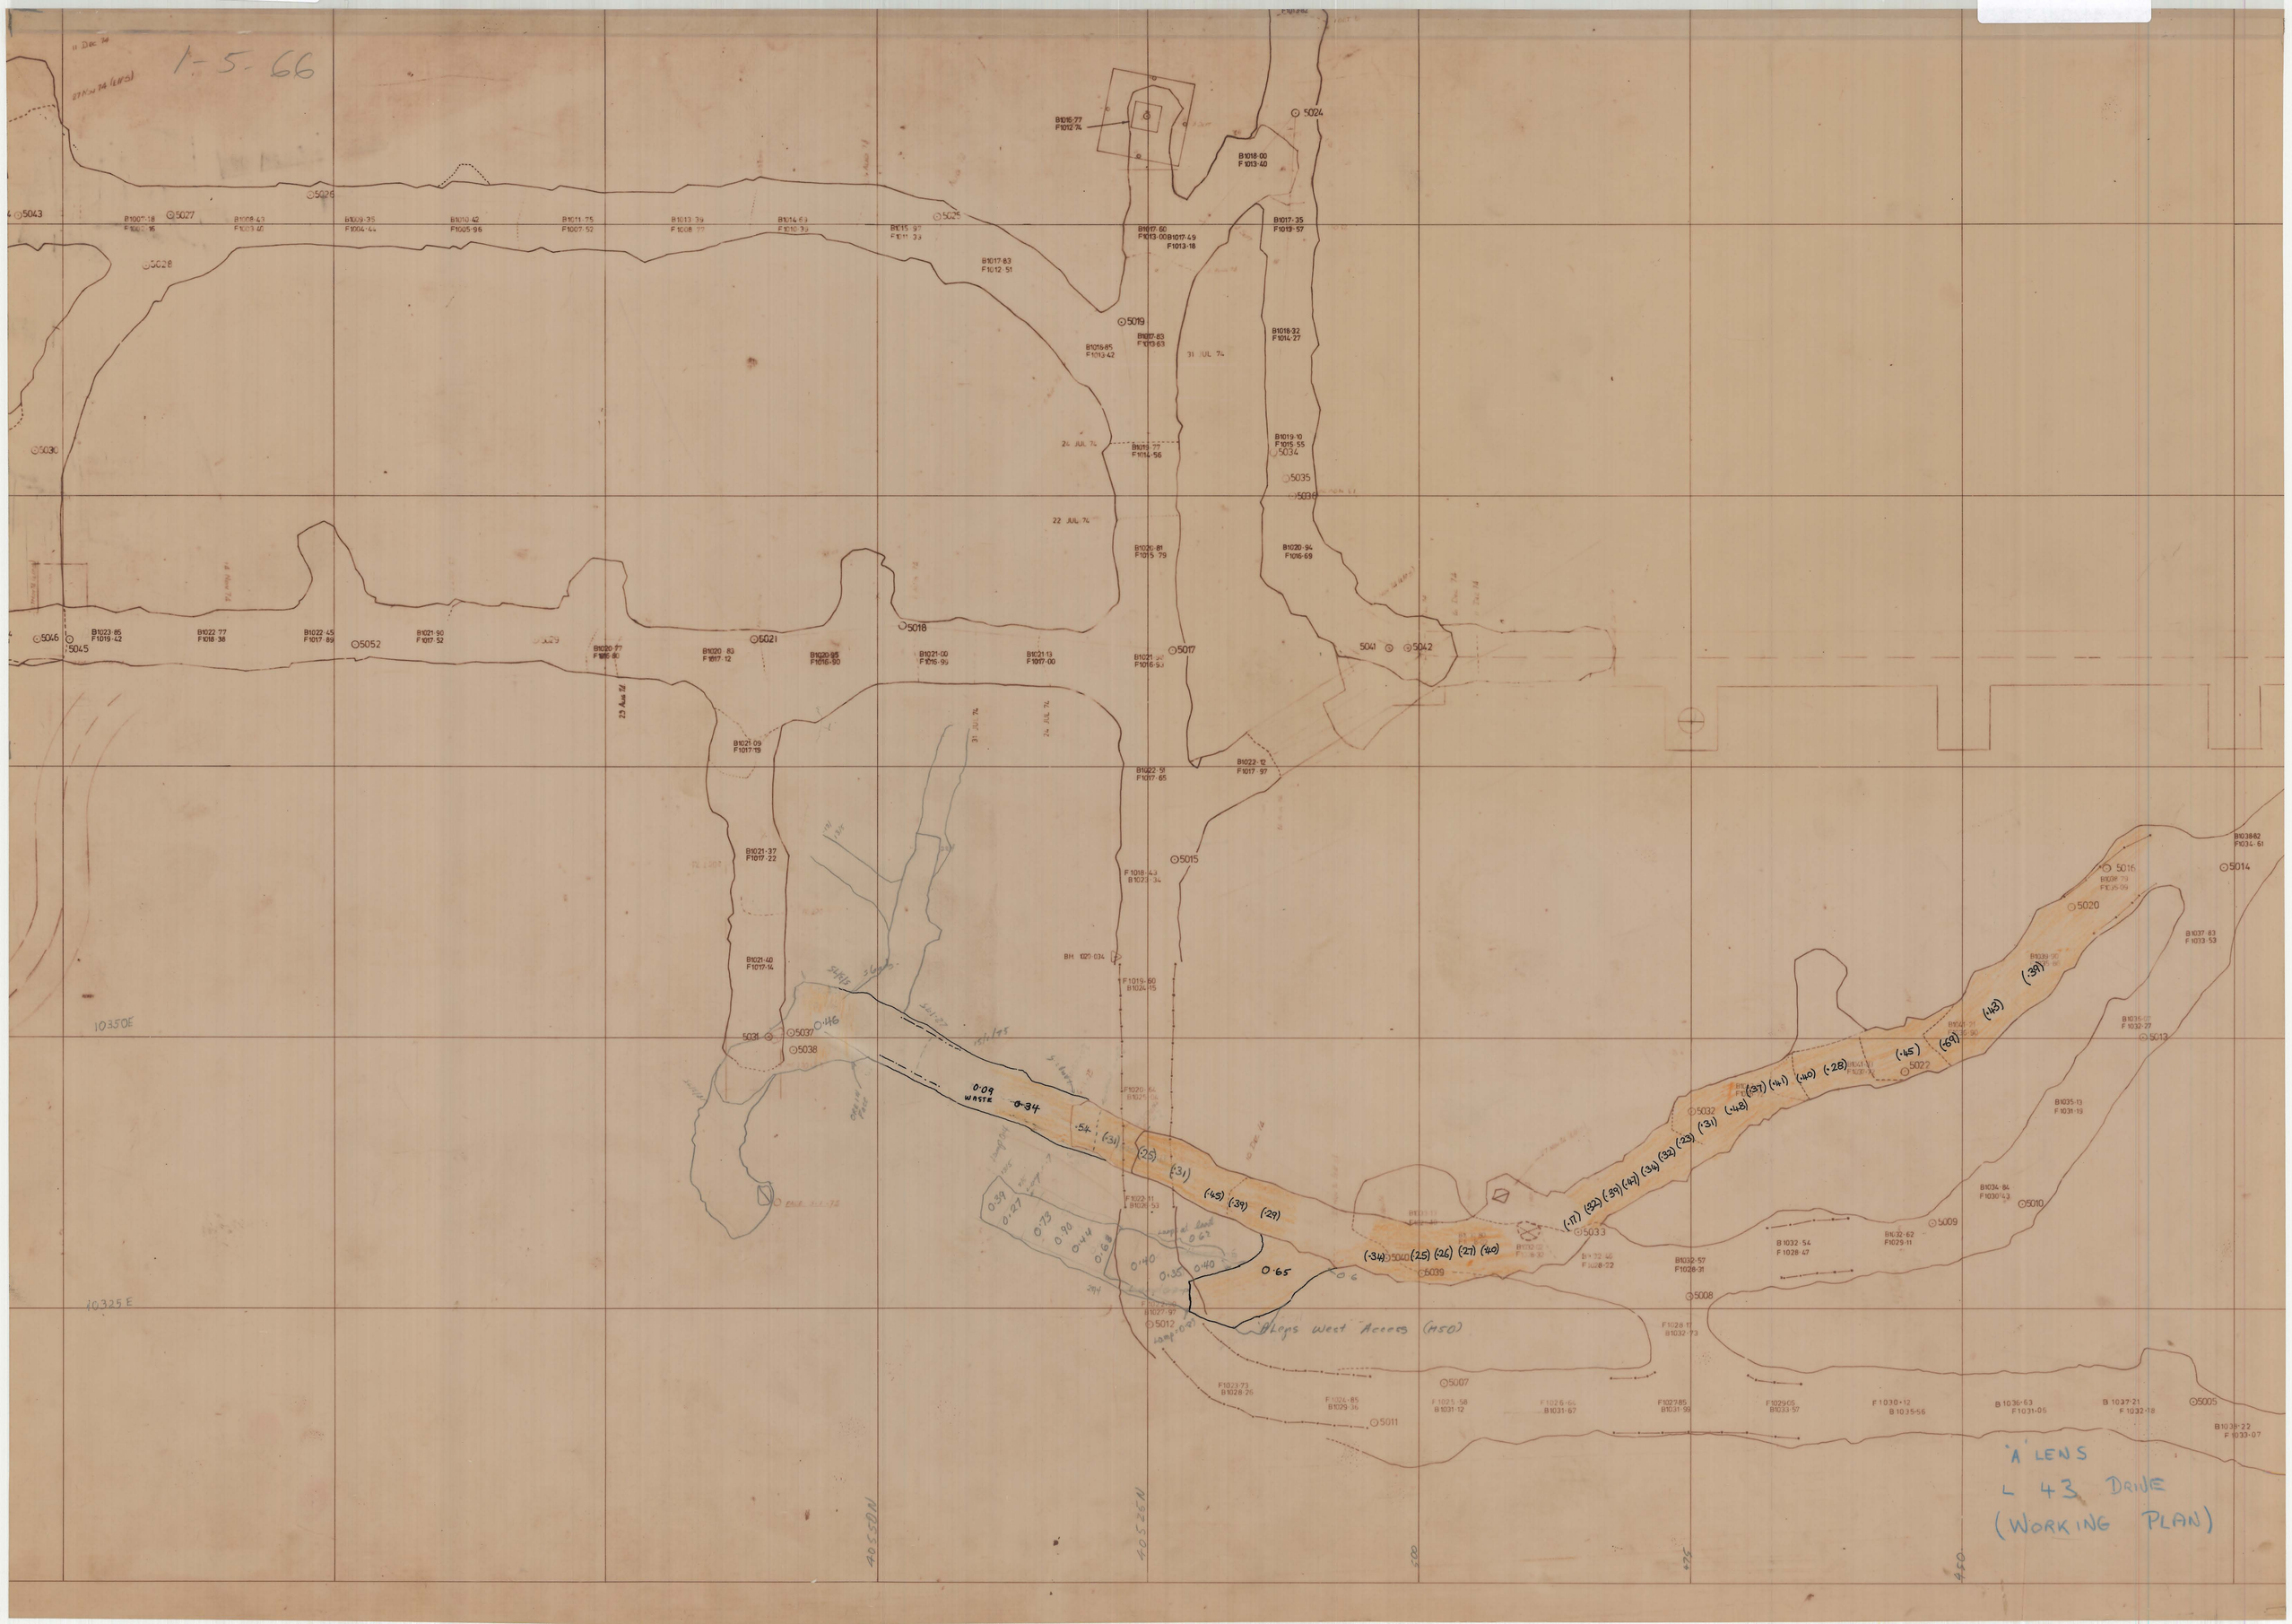5 cm
0374_4067
L43
H50