27 JUN 1981

5 cm

03BH01 - 1002

0374_4075

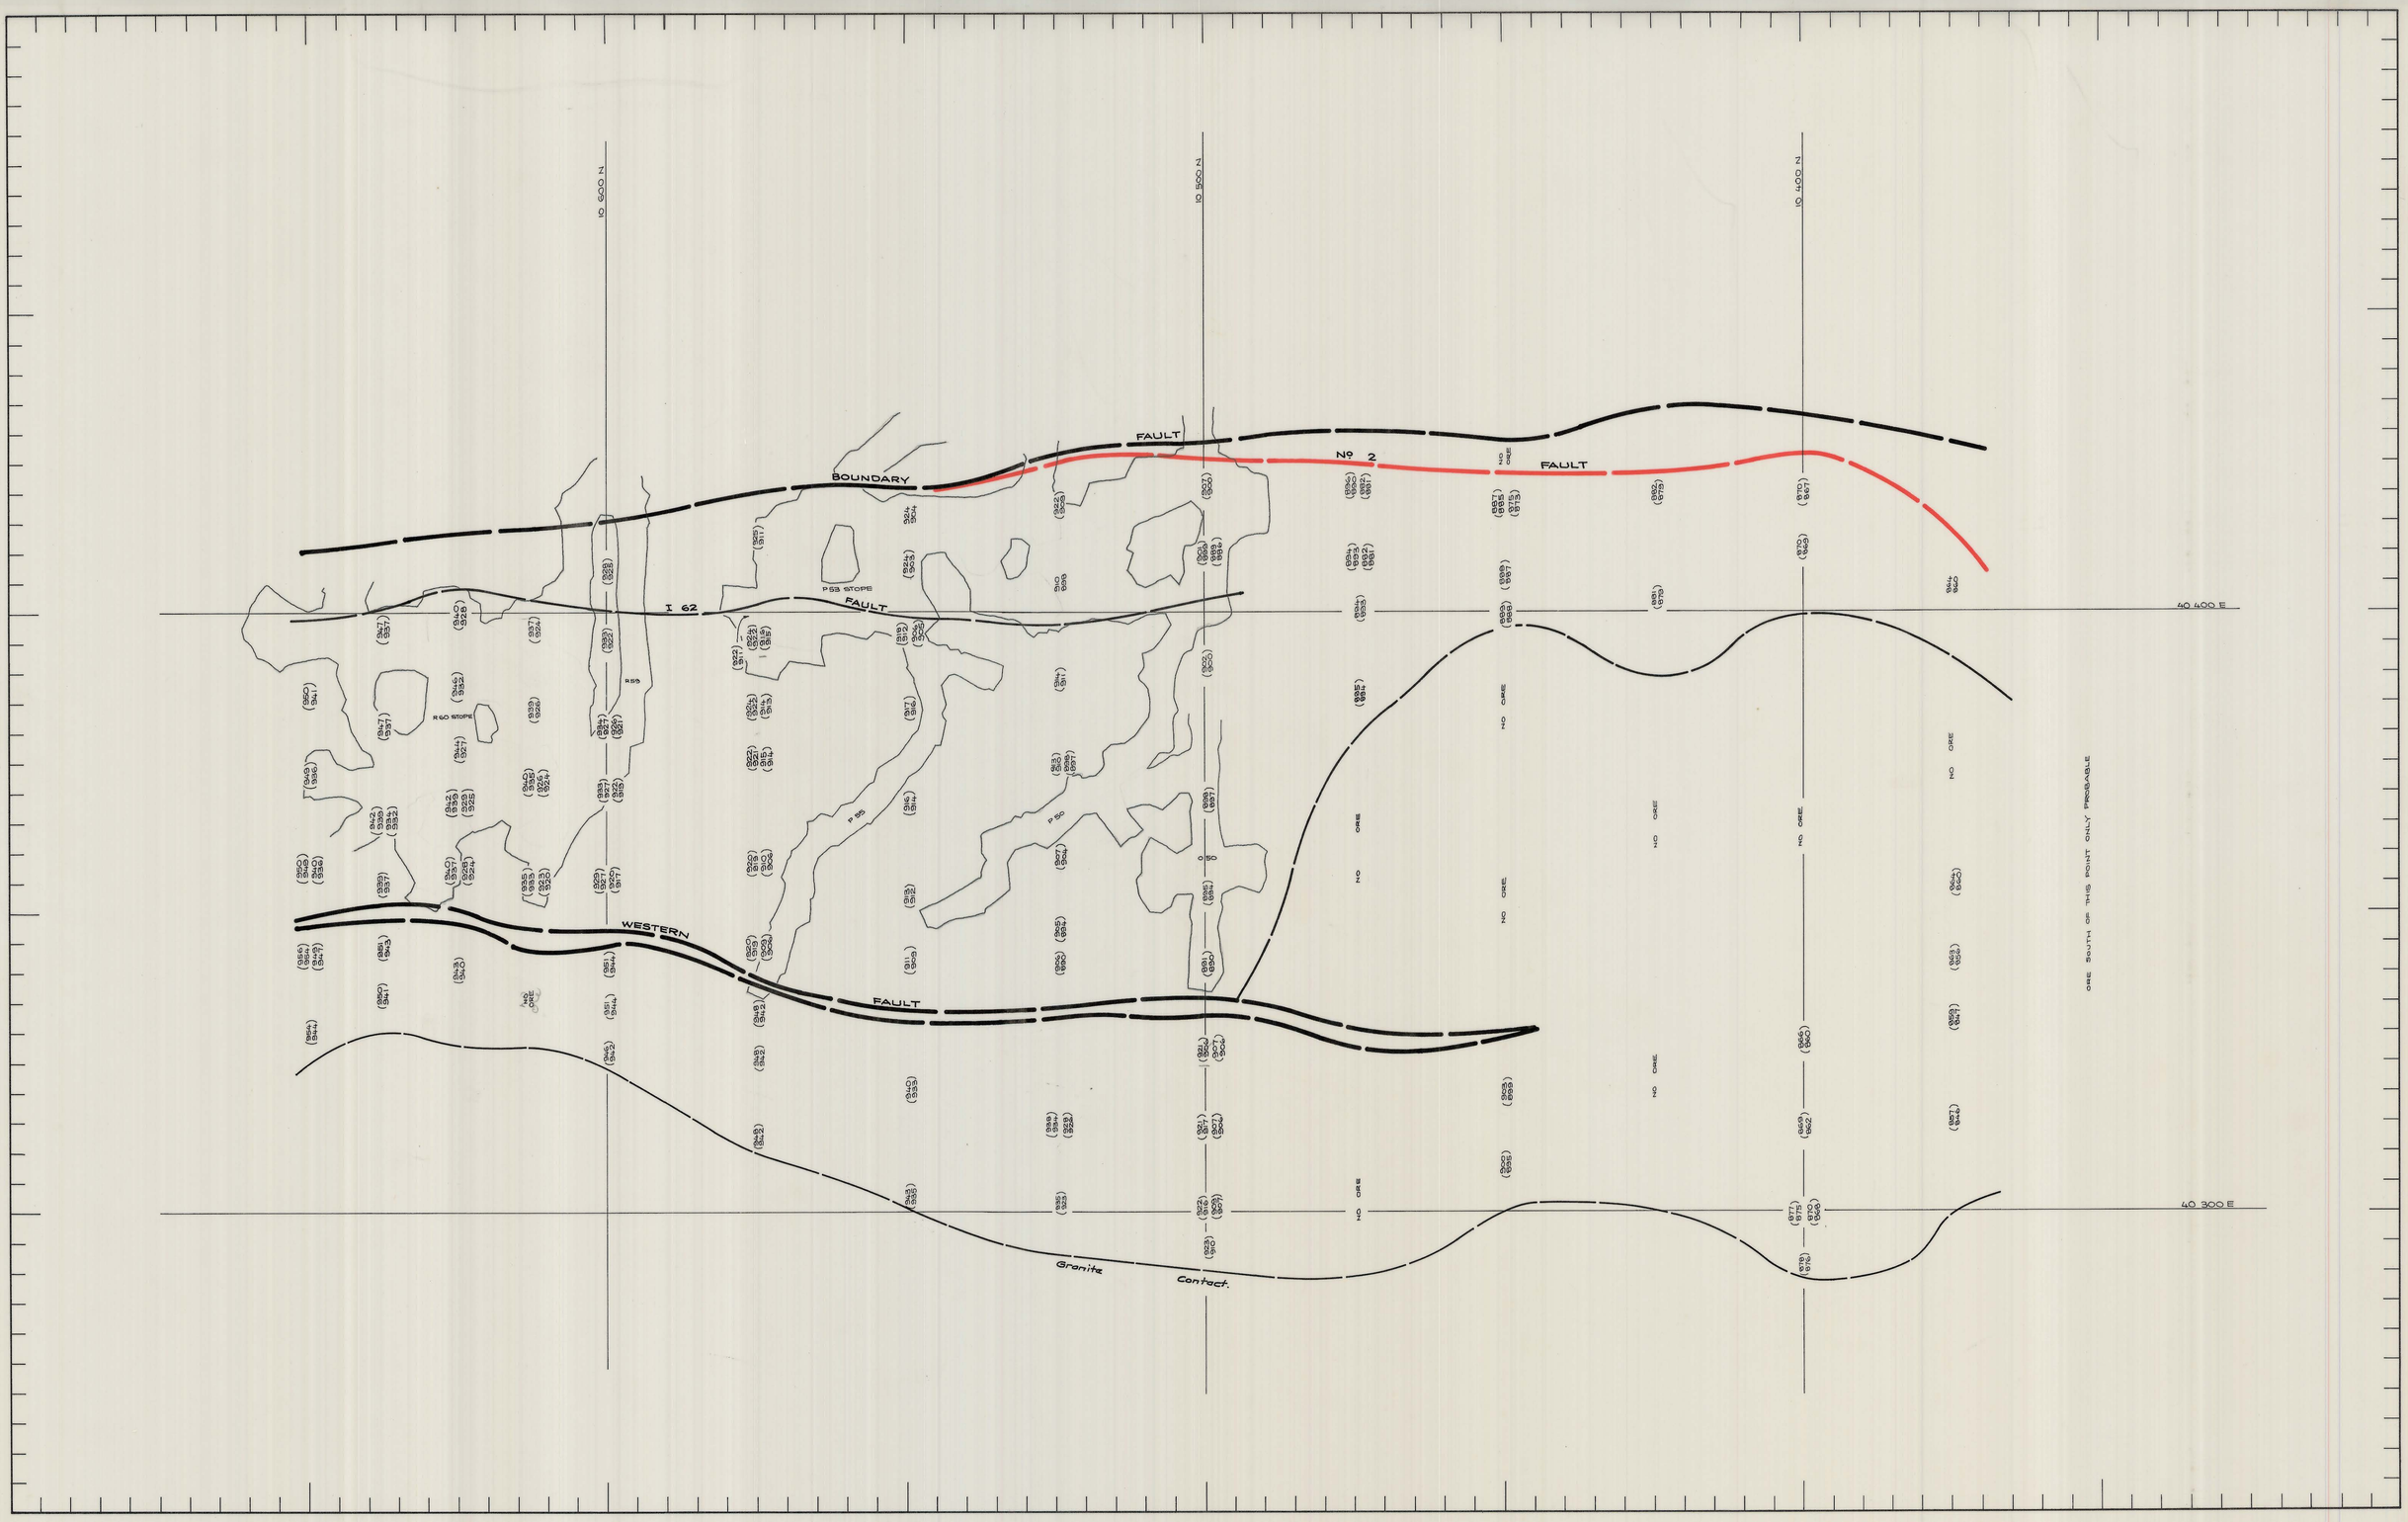

REVISIONS			
Nº	DATE		INITIALS

APPROVAL	INITIALS	DATE
PLANNING ENGINEER		
SNR. PLANNING ENGINEER		
TECHNICAL SERVICES SUPT.		
GENERAL MINING SUPT.		
MINE SUPT.		
SNR. SURVEYOR		
SNR. GEOLOGIST		

SCALE 1 : 500

LOCATION: BOLD HEAD MINE

SUBJECT: ORE THICKNESS C2. LENS OREBODY

KING ISLAND SCHEELITE
A Member of the Peko Wallsend Group
GRASSY KING ISLAND

PRELIMINARY ☐ FINAL ☐

PLAN NUMBER: 03BH01 - 1002