27 JUN 1981

0374 - 409

04DM15 - 1055
SECTIONS DONE 27-8-70

213

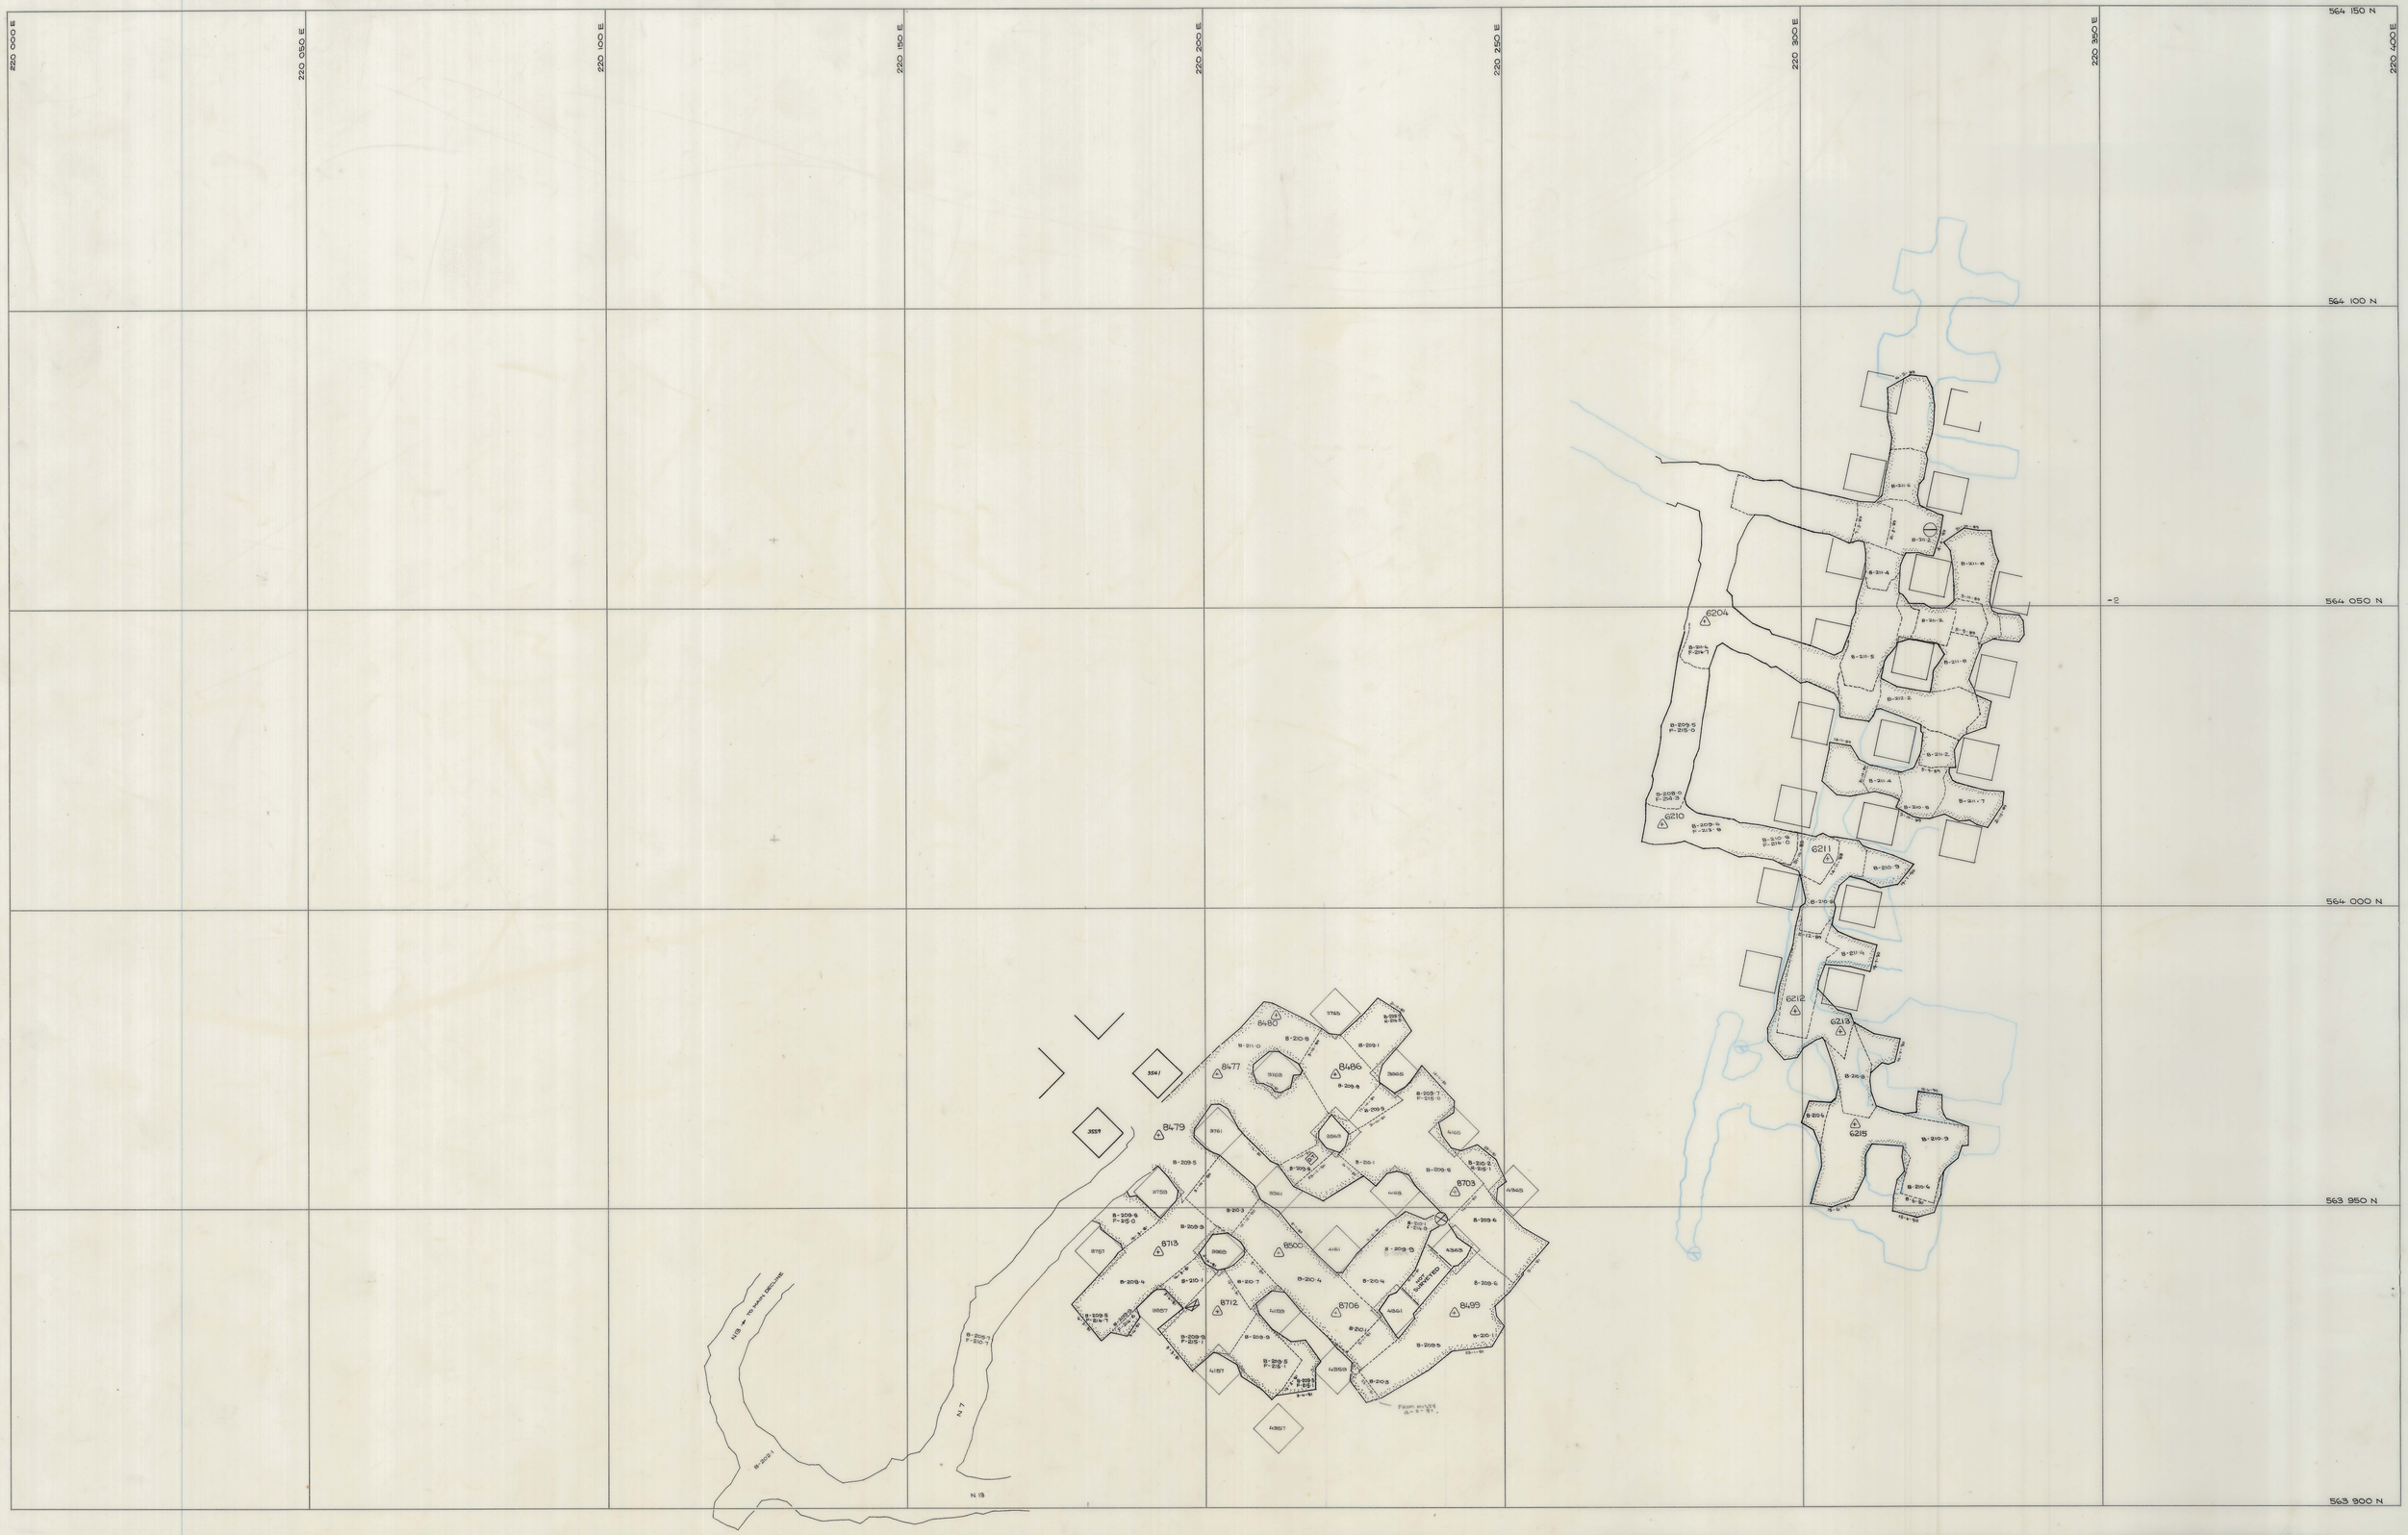

SCALE 1:500	north	LOCATION: DOLPHIN MINE	KIS KING ISLAND SCHEELITE — A DIVISION OF WARMAN INTERNATIONAL
5 cm		SUBJECT: -213 m CONTOUR	GRASSY KING ISLAND
			PLAN NUMBER: 04DM15 - 1055