0374_4114

5 cm

03BH03 - 3008

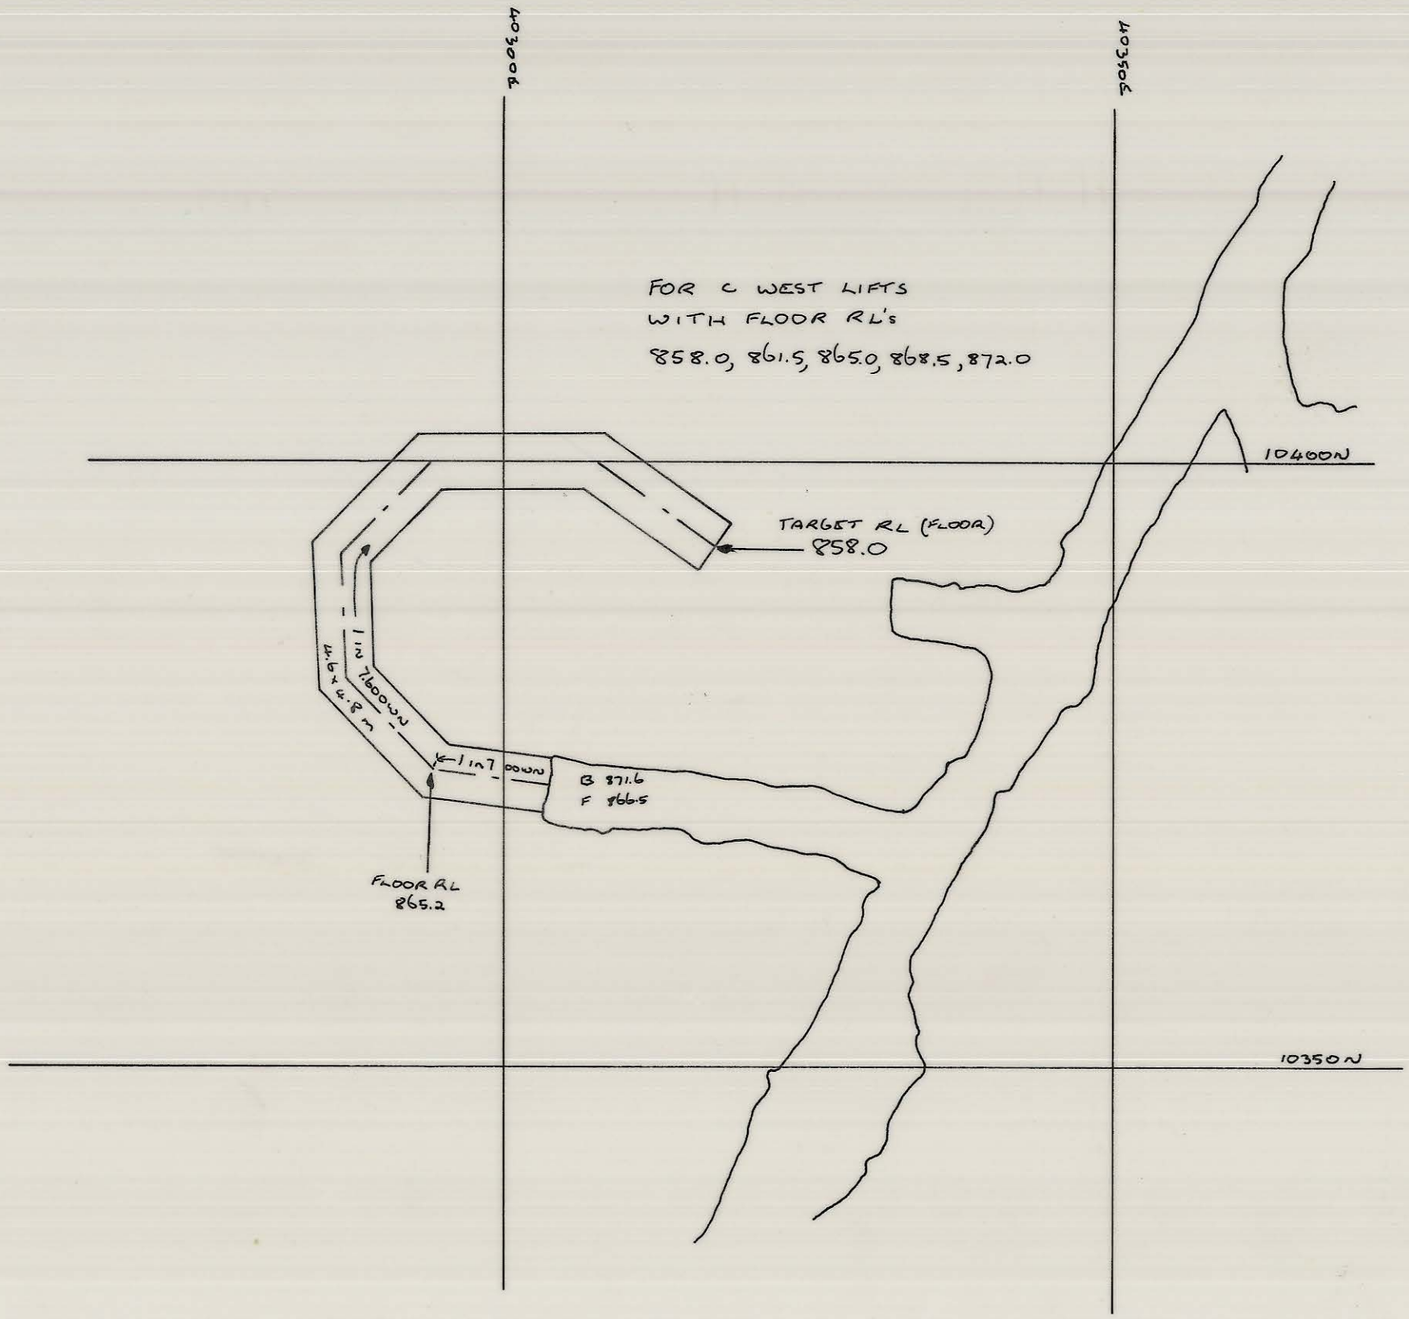

REF. PLAN 03BH03- 3006	GEOLOGY		23/3/83	SCALE 1: 500
	SURVEY			KING ISLAND SCHEELITE GRASSY KING ISLAND
	PLANNING			BOLD HEAD MINE
	ROCK MEC.			REVISED H36 ACCESS TO
	GRADE CON.			C WEST
	DRAFTING			DRAWING NUMBER
	T.S.S.		23/3/83	03BH03-3008