0374-412

04DM14 - 1020

5 cm

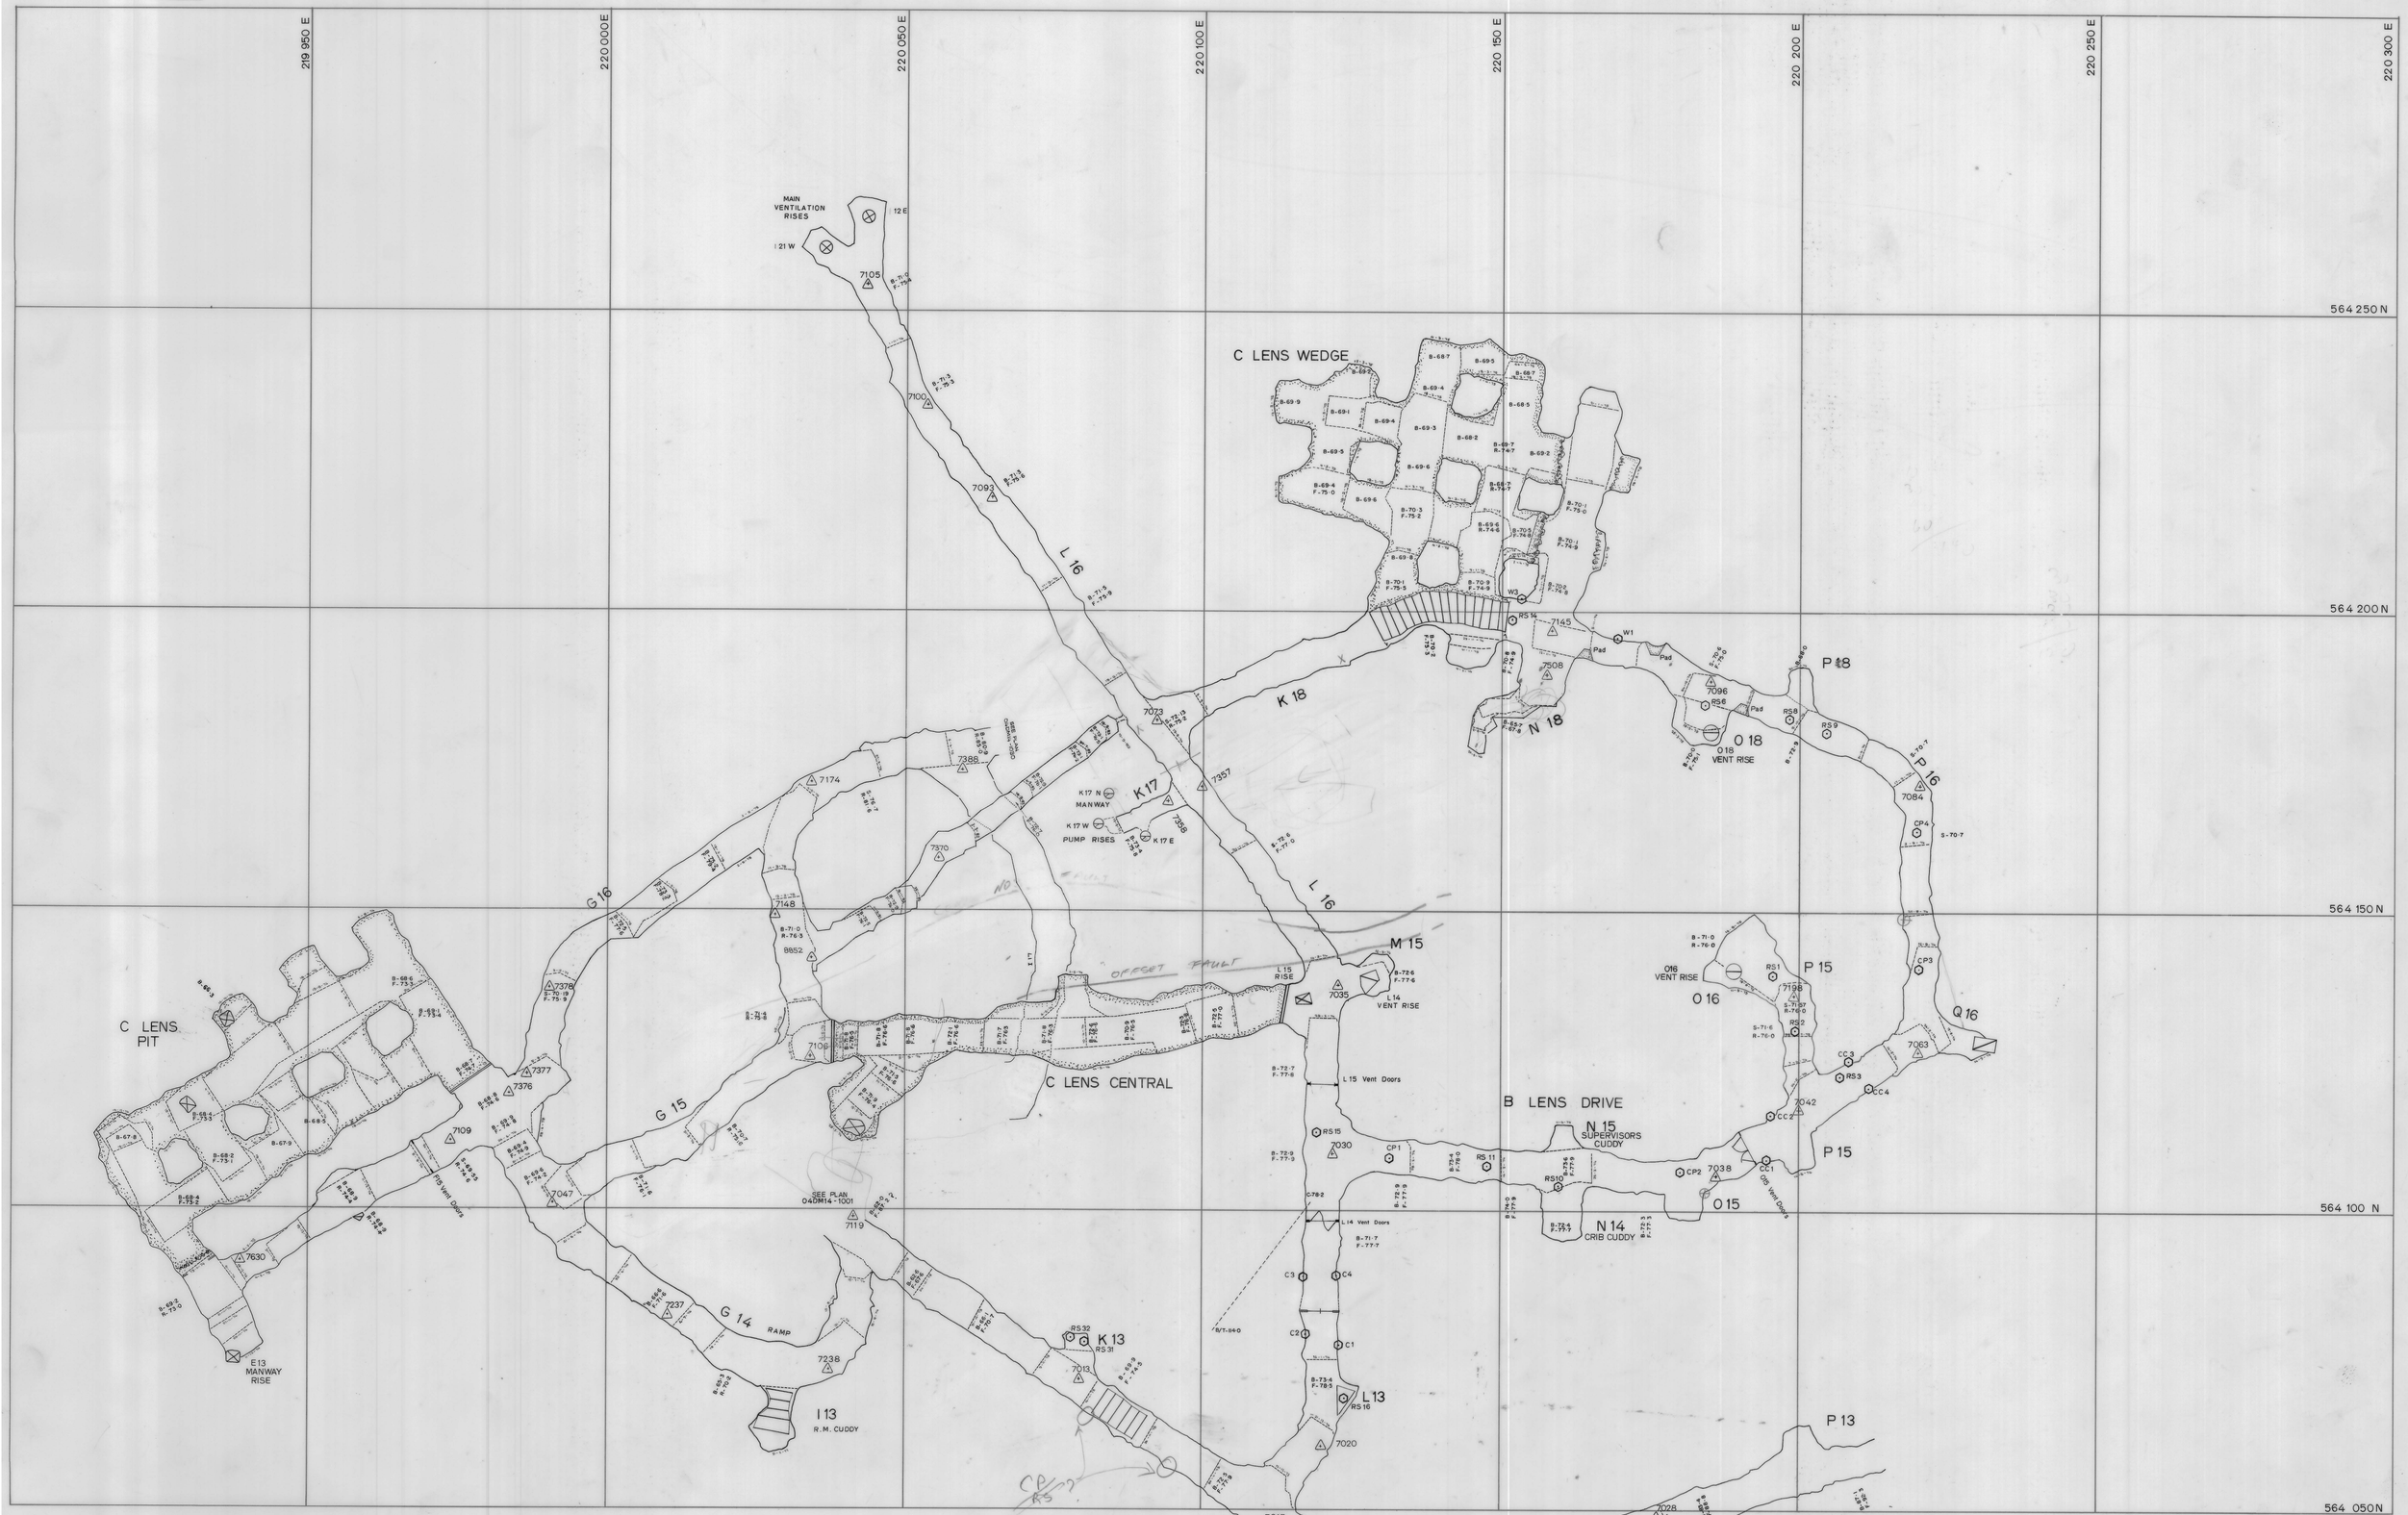

LOCATION

DOLPHIN MINE

SUBJECT

-75m ZONE

F-62m TO B-87m

KING ISLAND SCHEELITE

A DIVISION OF WARMAN INTERNATIONAL

GRASSY KING ISLAND

PLAN NUMBER

04DM14 - 1020