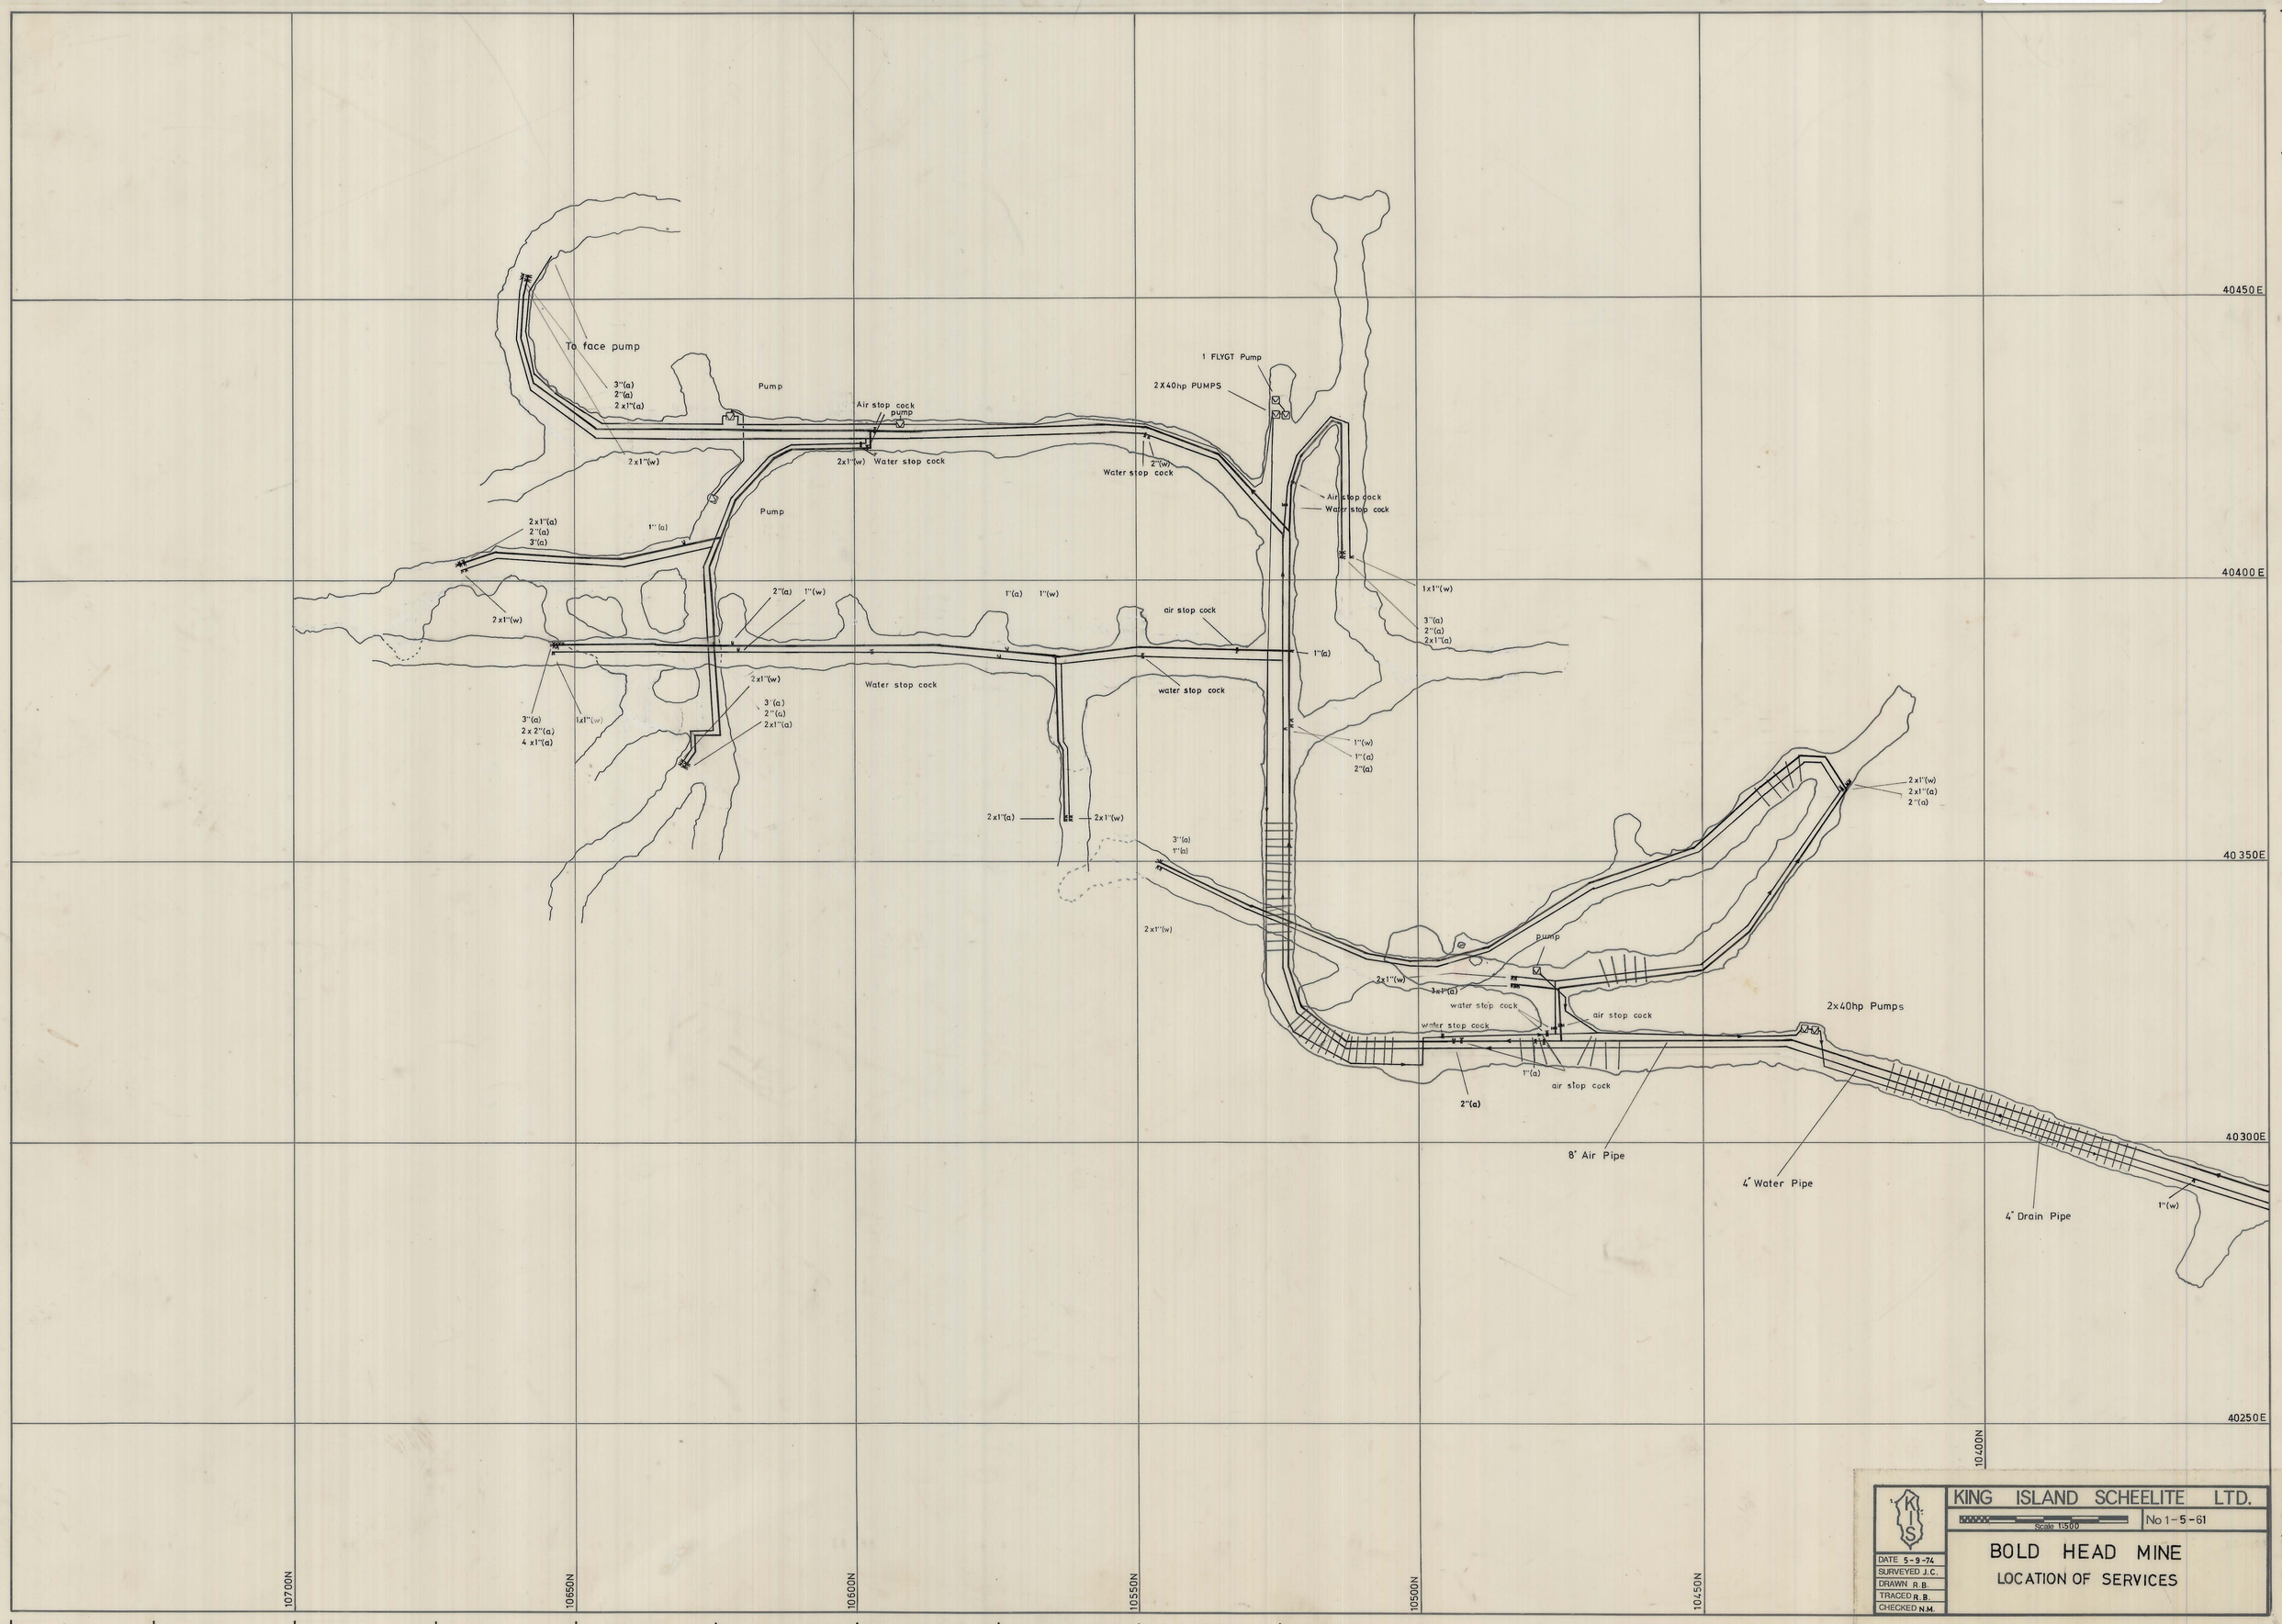5 cm
03BH 12-1005
0374_4134
1-5-61. LOCATION OF SERVICES BOLD HEAD.