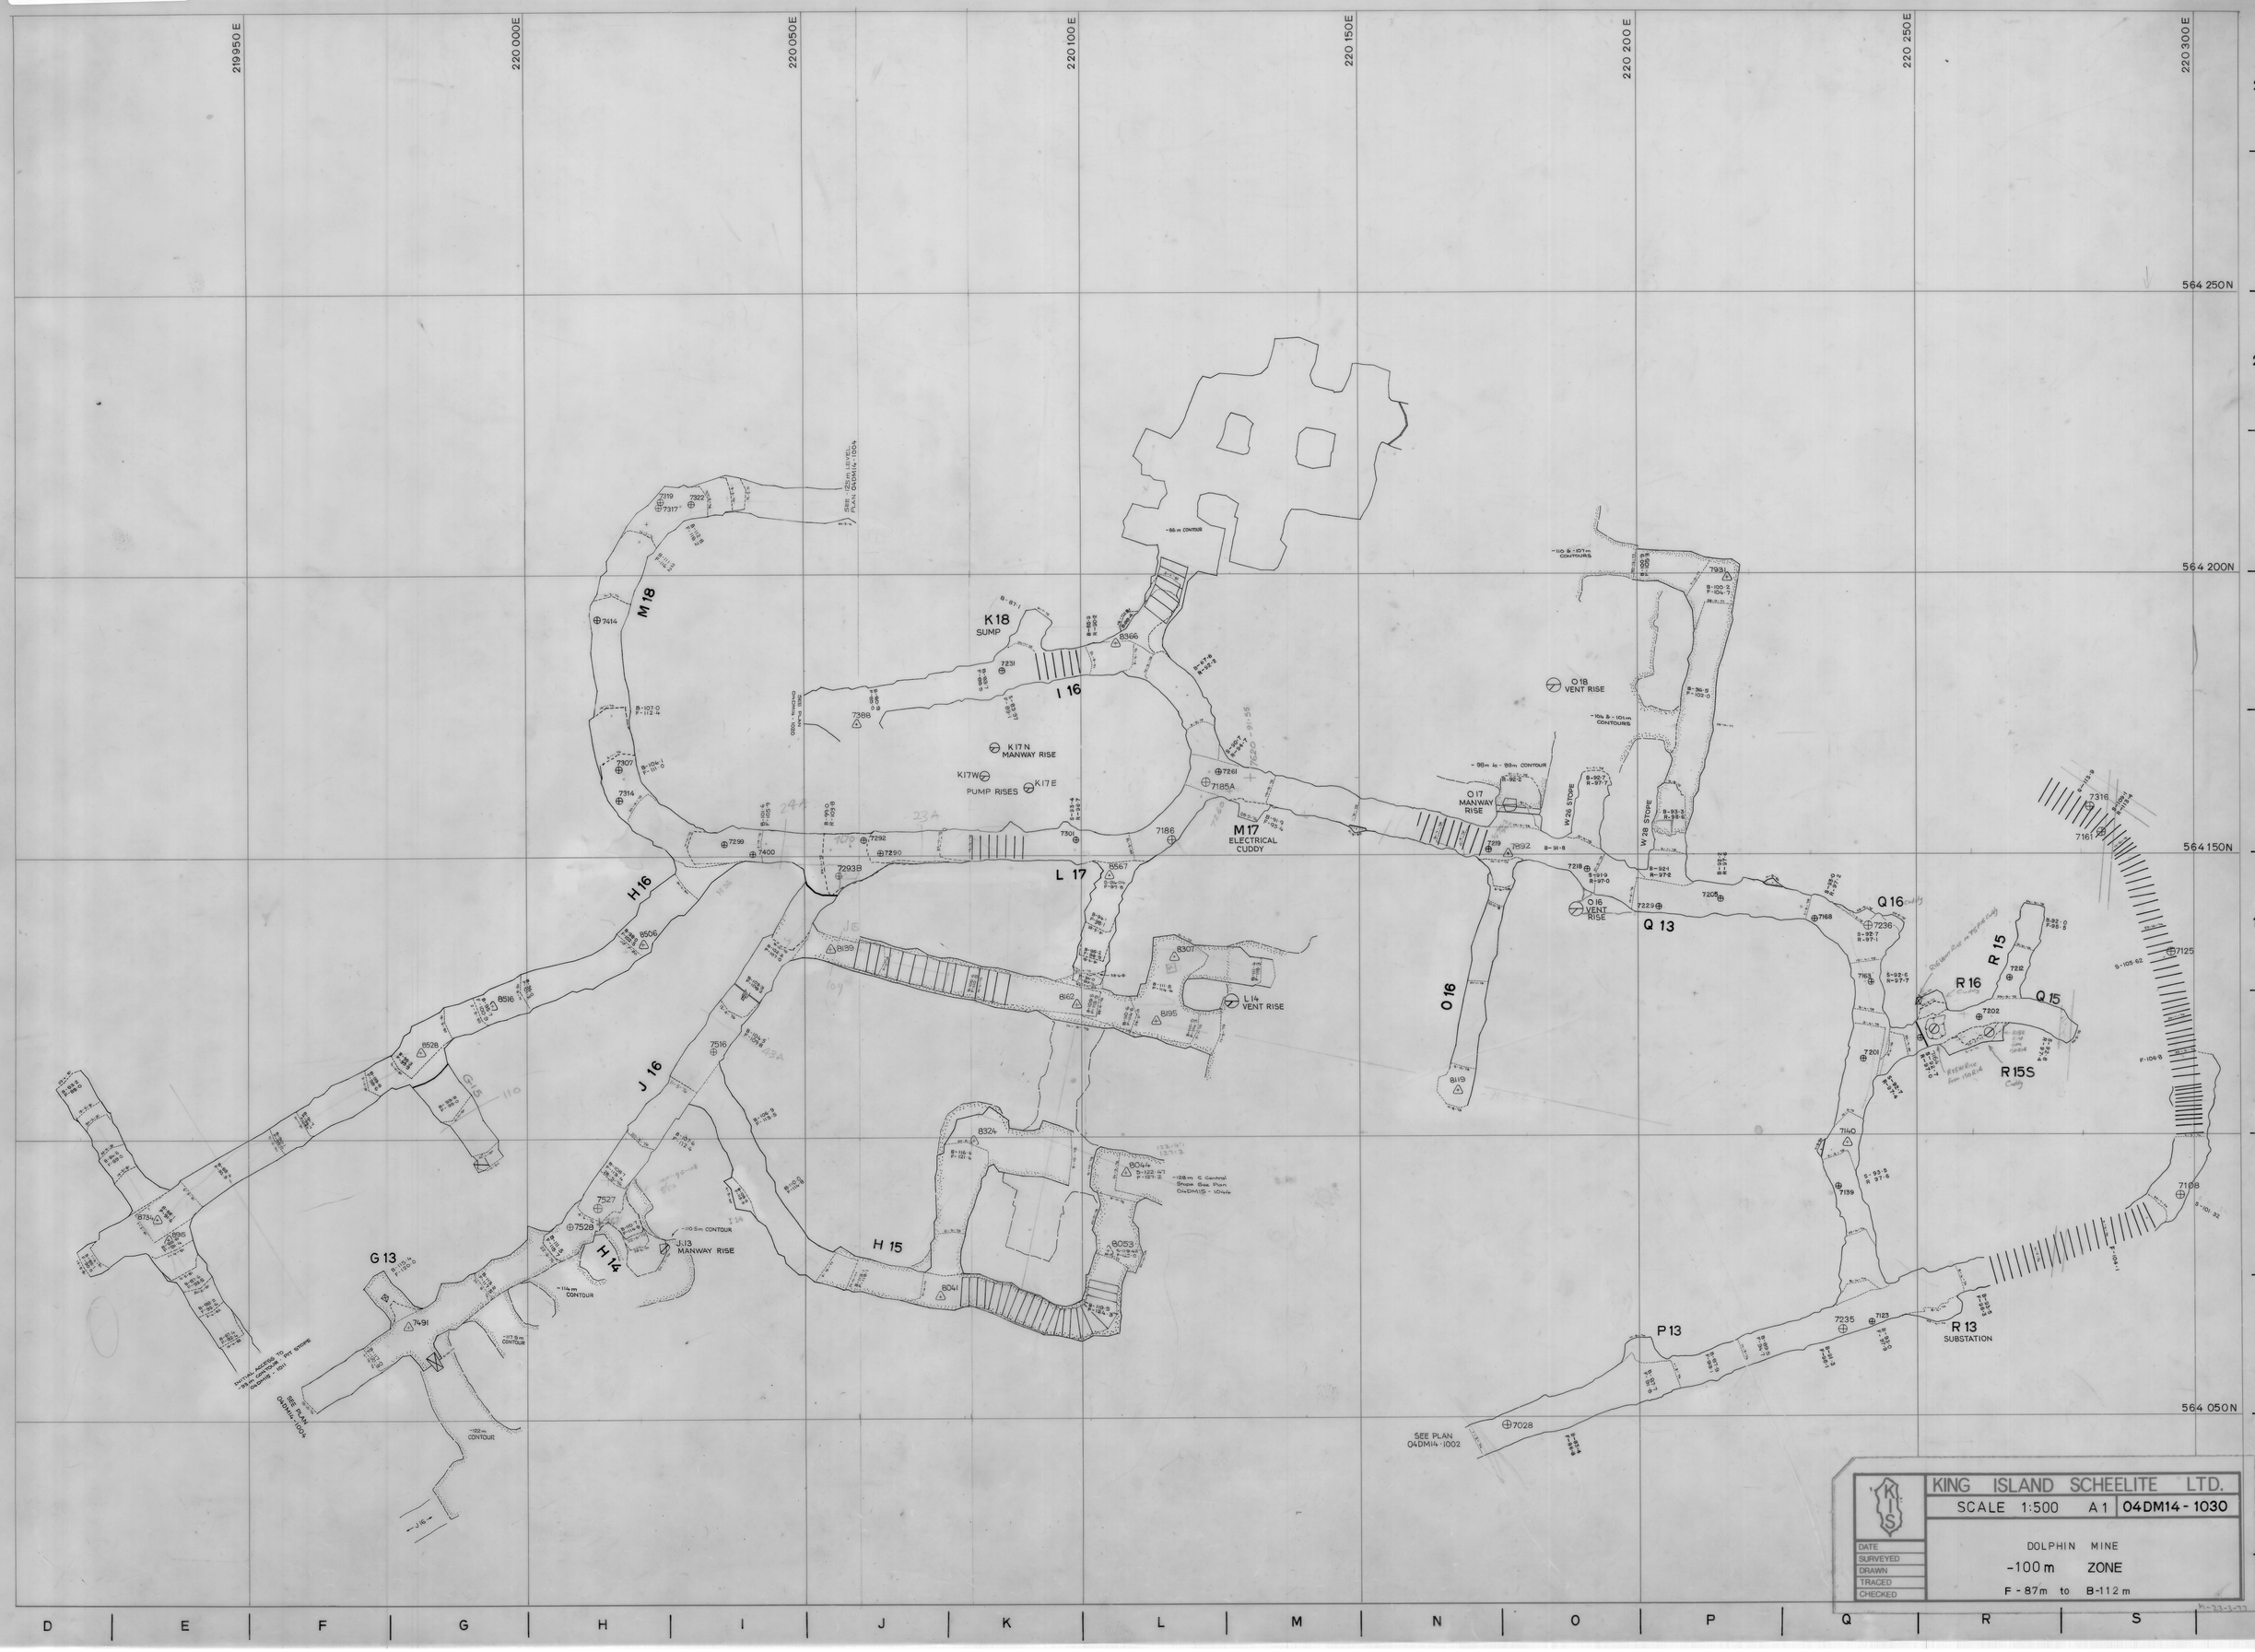

KING ISLAND SCHEELITE LTD.	
SCALE 1:500 A1	04DM14 - 1030
DOLPHIN MINE	
-100 m ZONE	
F - 87m to B-112 m	
DATE	
SURVEYED	
DRAWN	
TRACED	
CHECKED	